


DONALD SVONAVEC
 MINE NO. 19
 LOWER FREEPORT SEAM
 SOMERSET TWP SOMERSET CO
 SCALE 1:100
 V.E. ERICKSON RPE # 7074
 B-2
 3

PERMIT NO. 58-1
 LEGEND
 MINING COMPLETED
 MONTHS ADVANCE
 PROPERTY LINE
 7-1068-7-1068

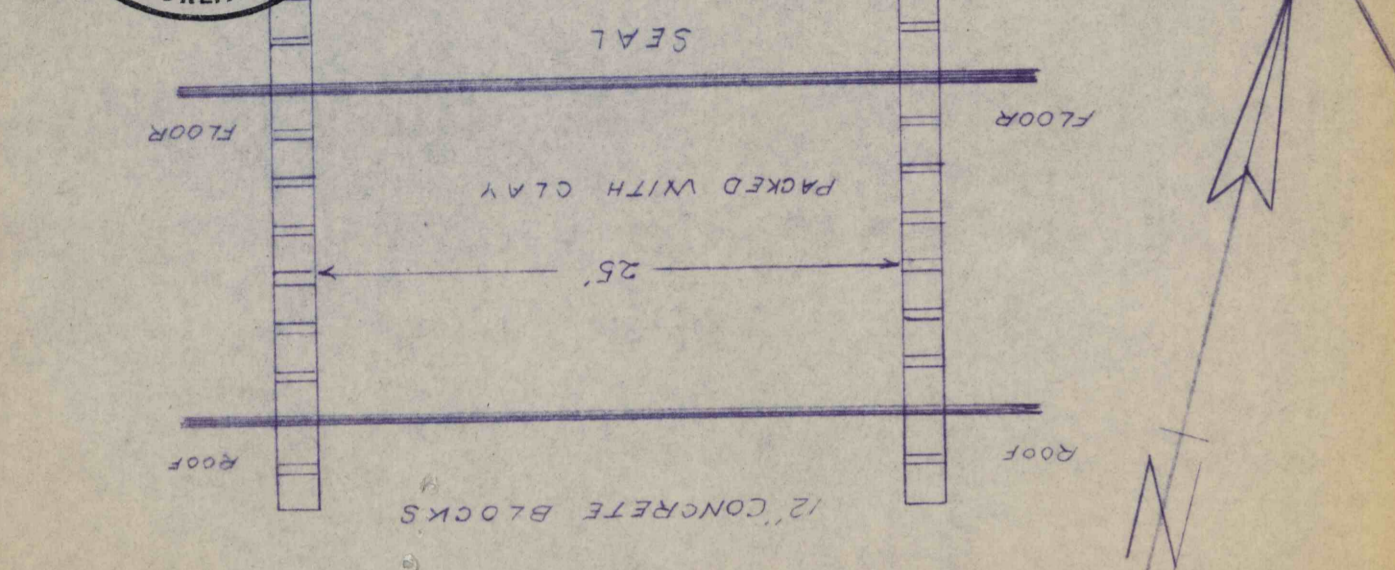

ON THIS MINE MAP 12-11-1924
 HIGHEST SURVEY DATE