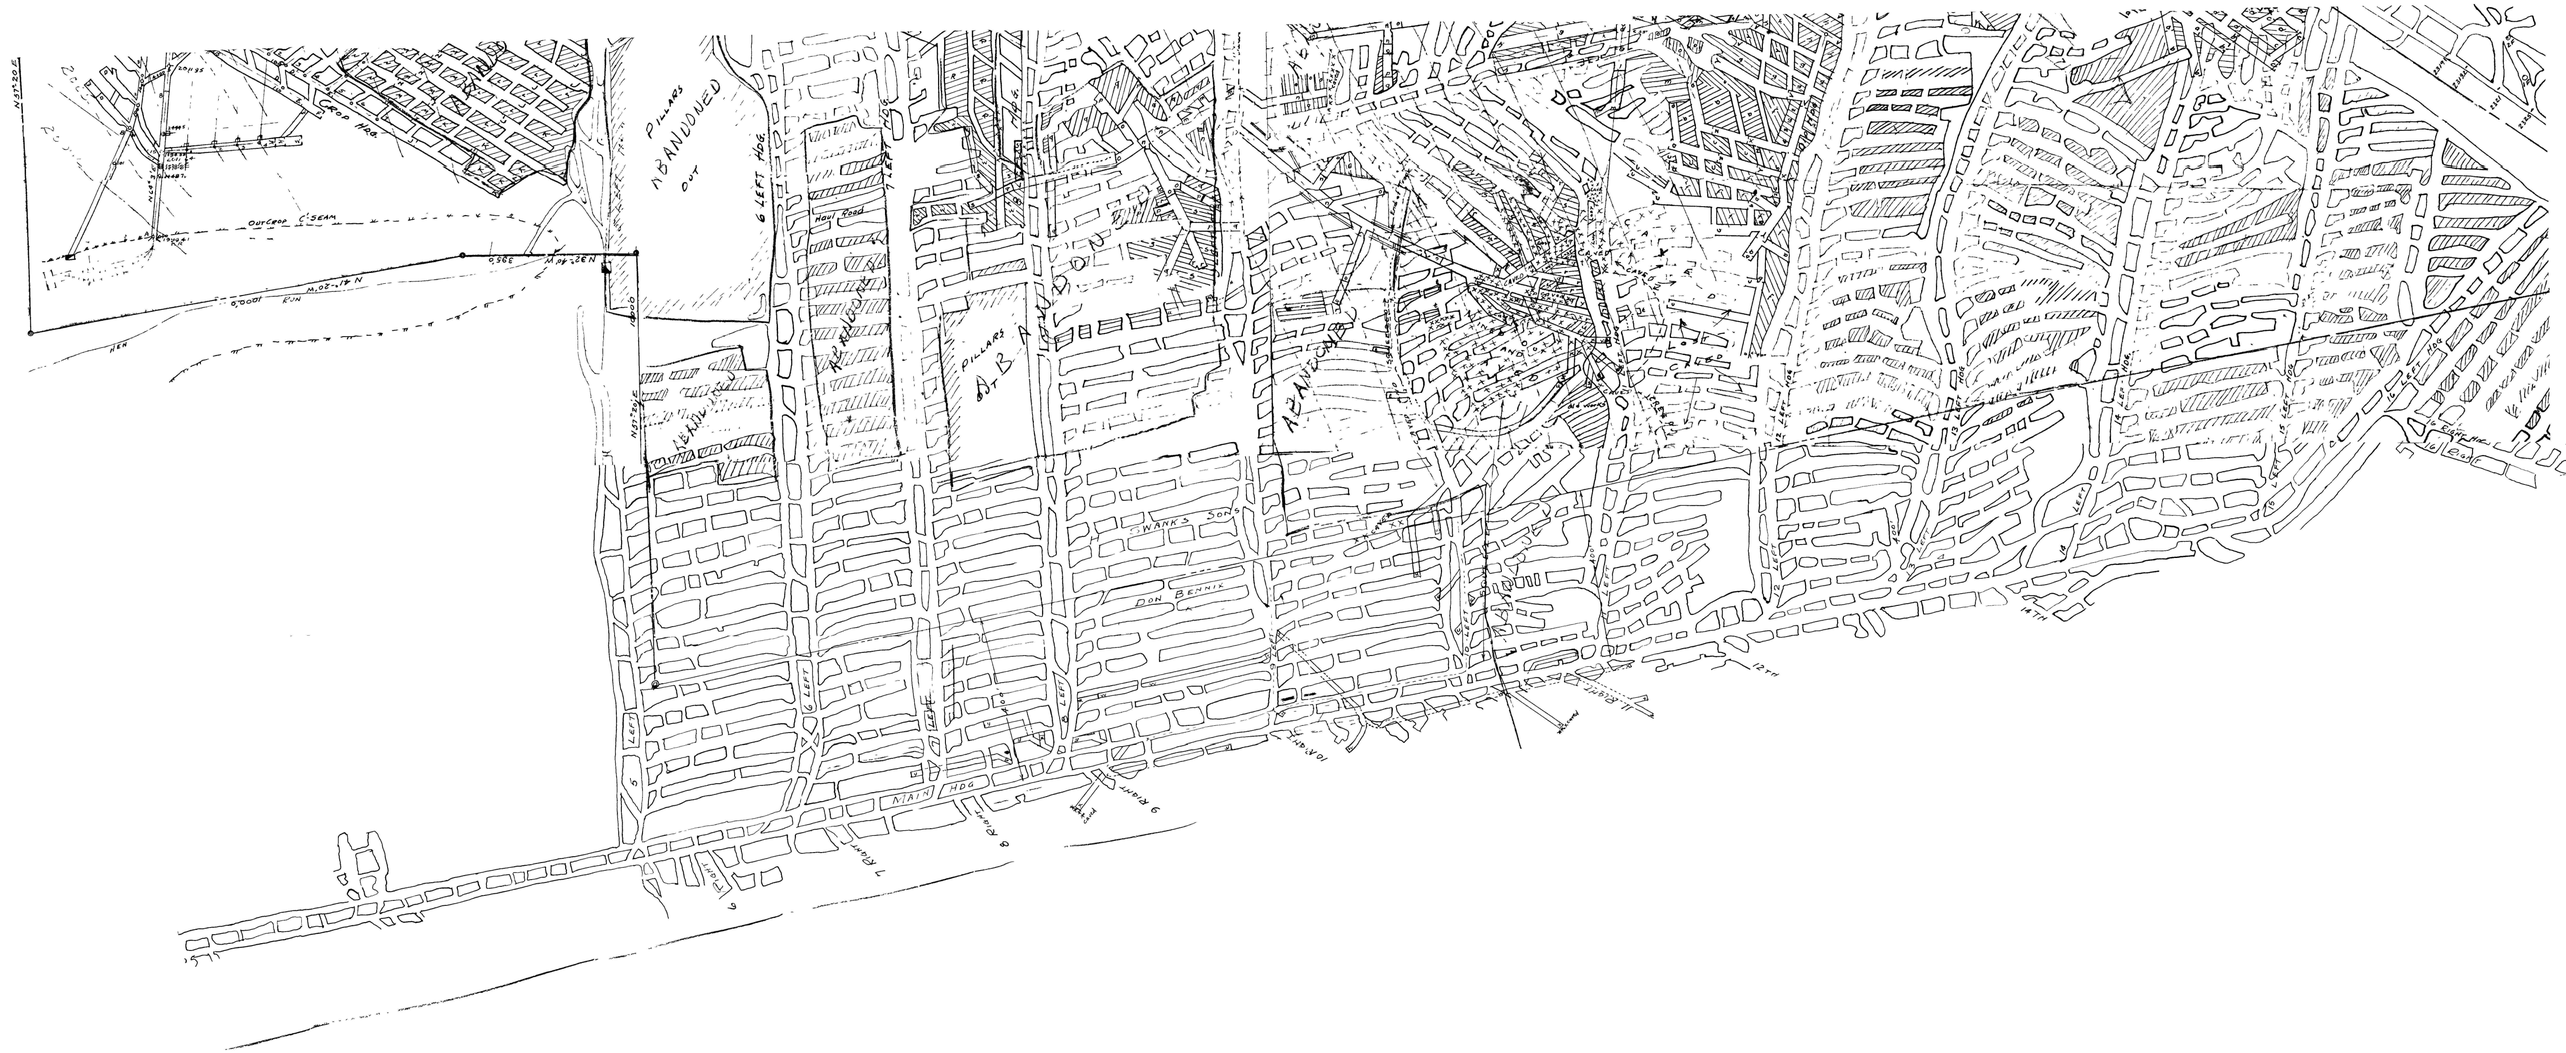

ALBERT YONKOSKY - DAVIS
ADDRESS: R D 4, MILL RUN, BOX 599,
ALTOONA, PA 16601

SWANK No 13 MINE
C - PRIME SEAM
DEAN TWP, CAMBRIA CO, PA

SCALE 1" = 100'

DATE: AUG 27, 1966

JOSEPH E. MCGUIRE
REGISTERED
PROFESSIONAL
ENGINEER
PA