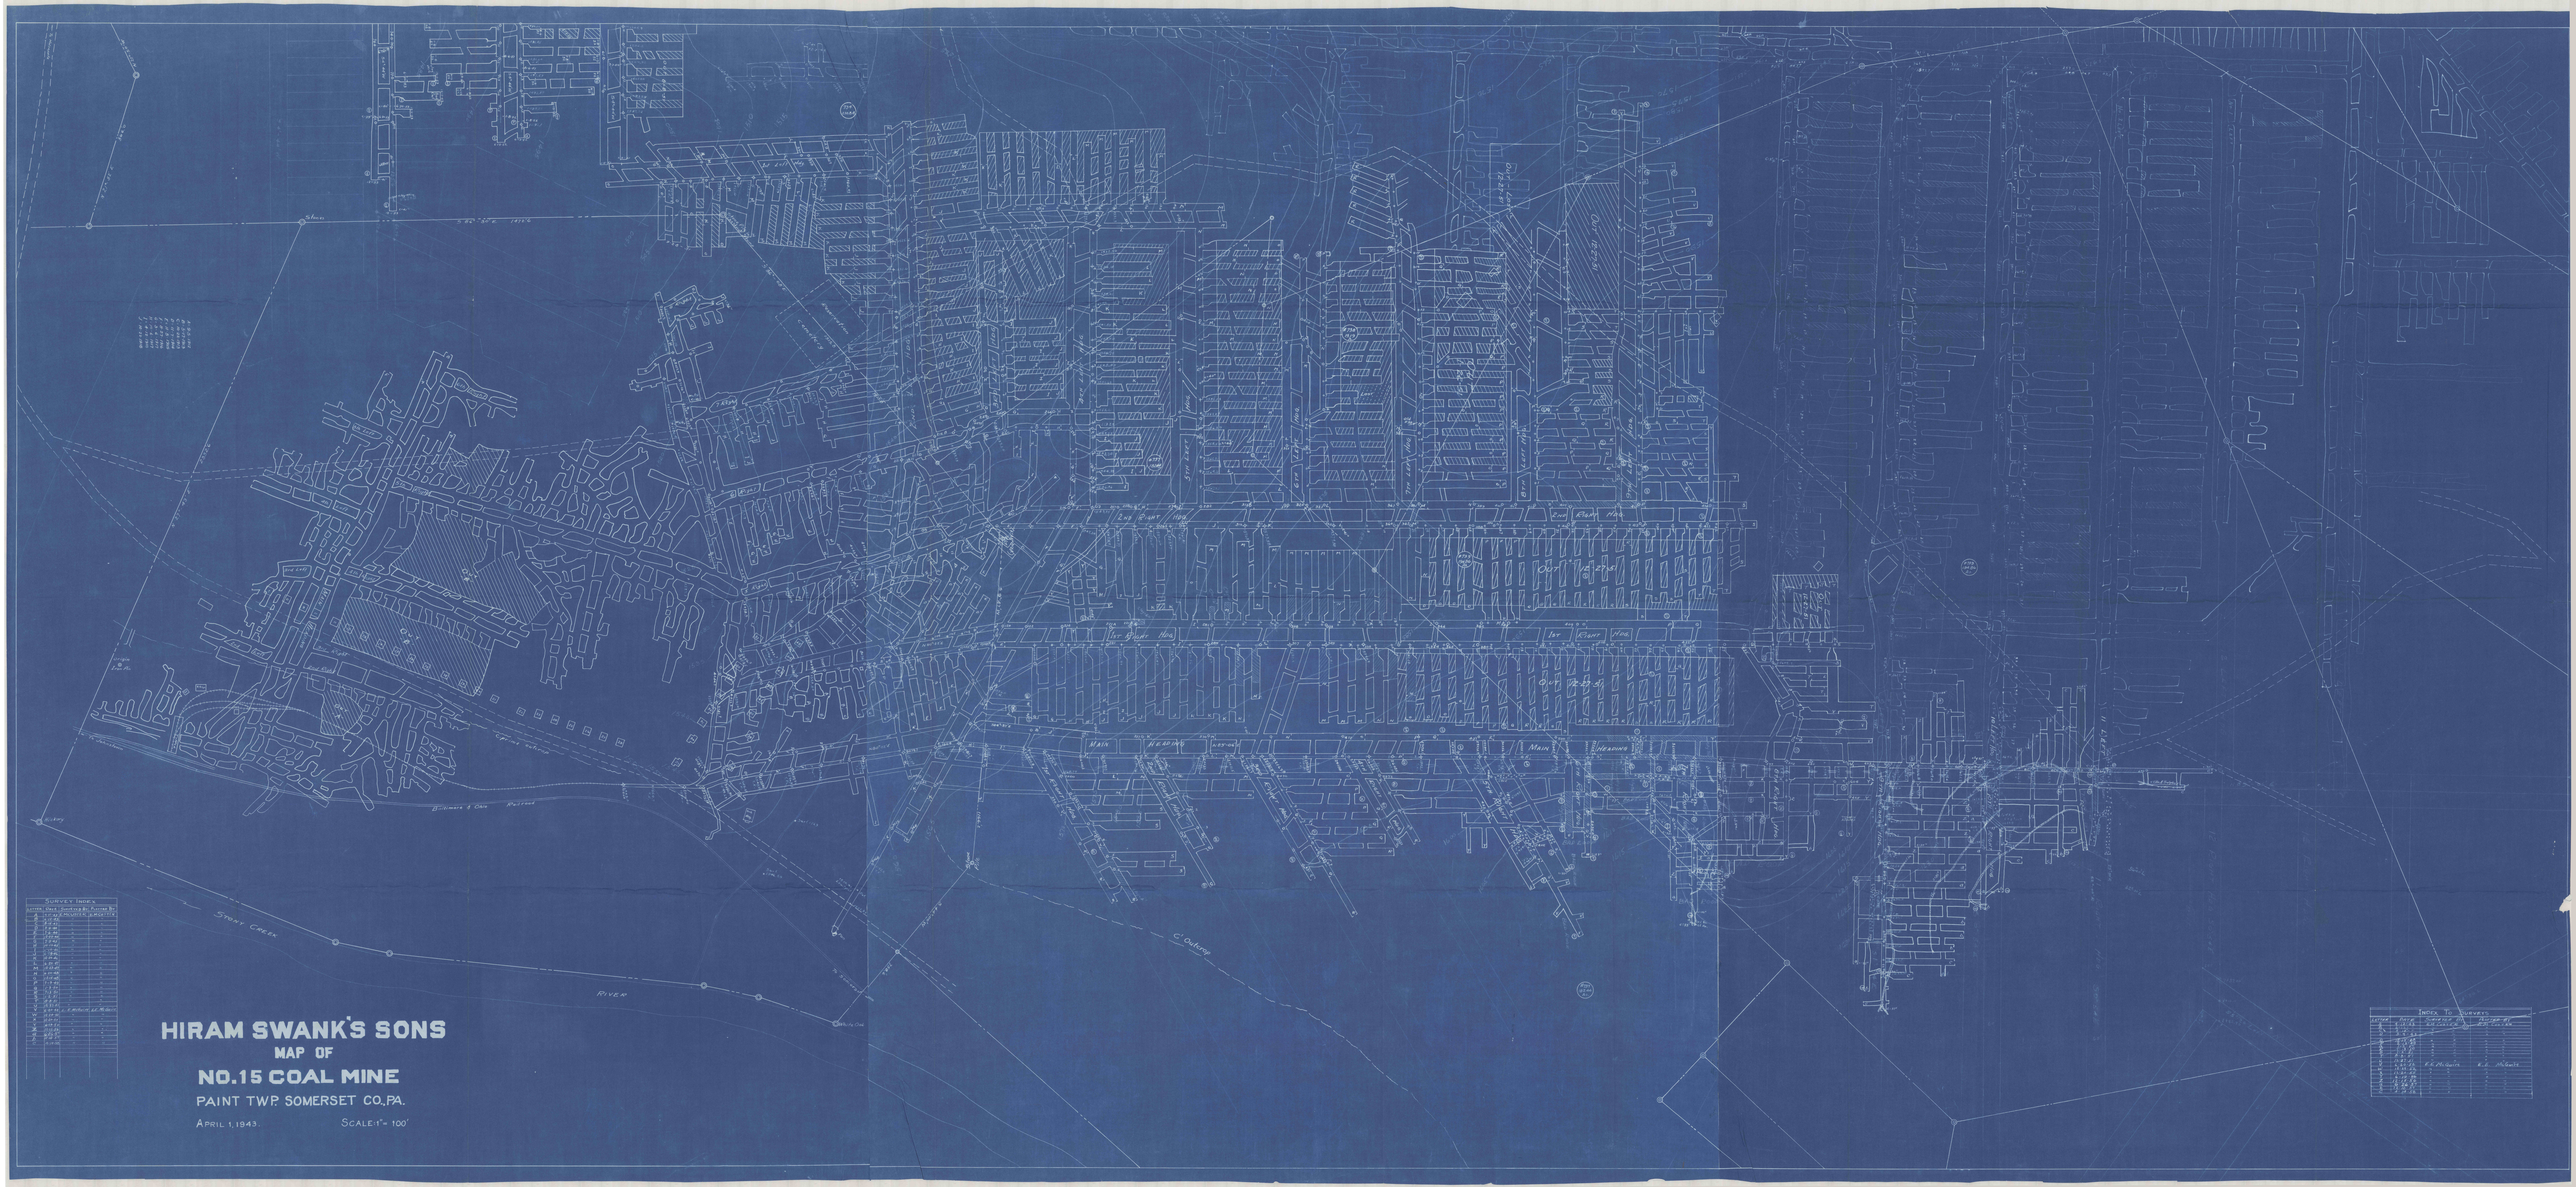
HIRAM SWANK'S SONS
MAP OF
NO. 15 COAL MINE
PAINT TWP. SOMERSET CO. PA.
APRIL 1, 1943.
SCALE: 1" = 100'
SURVEY INDEX
INDEX TO SURVEYS
Stony Creek
River
Main Heading
Left Rear Hdg.
Left Front Hdg.
Right Front Hdg.
Right Rear Hdg.
Baltimore & Ohio Railroad