


SHOEMAKER COAL MINE  
MAP SHOWING WORKINGS OF  
WILMORE NO. 3 COLLIER  
WASHINGTON TWP. CAMBRIA CO. PA.

SCALE 1"=100'

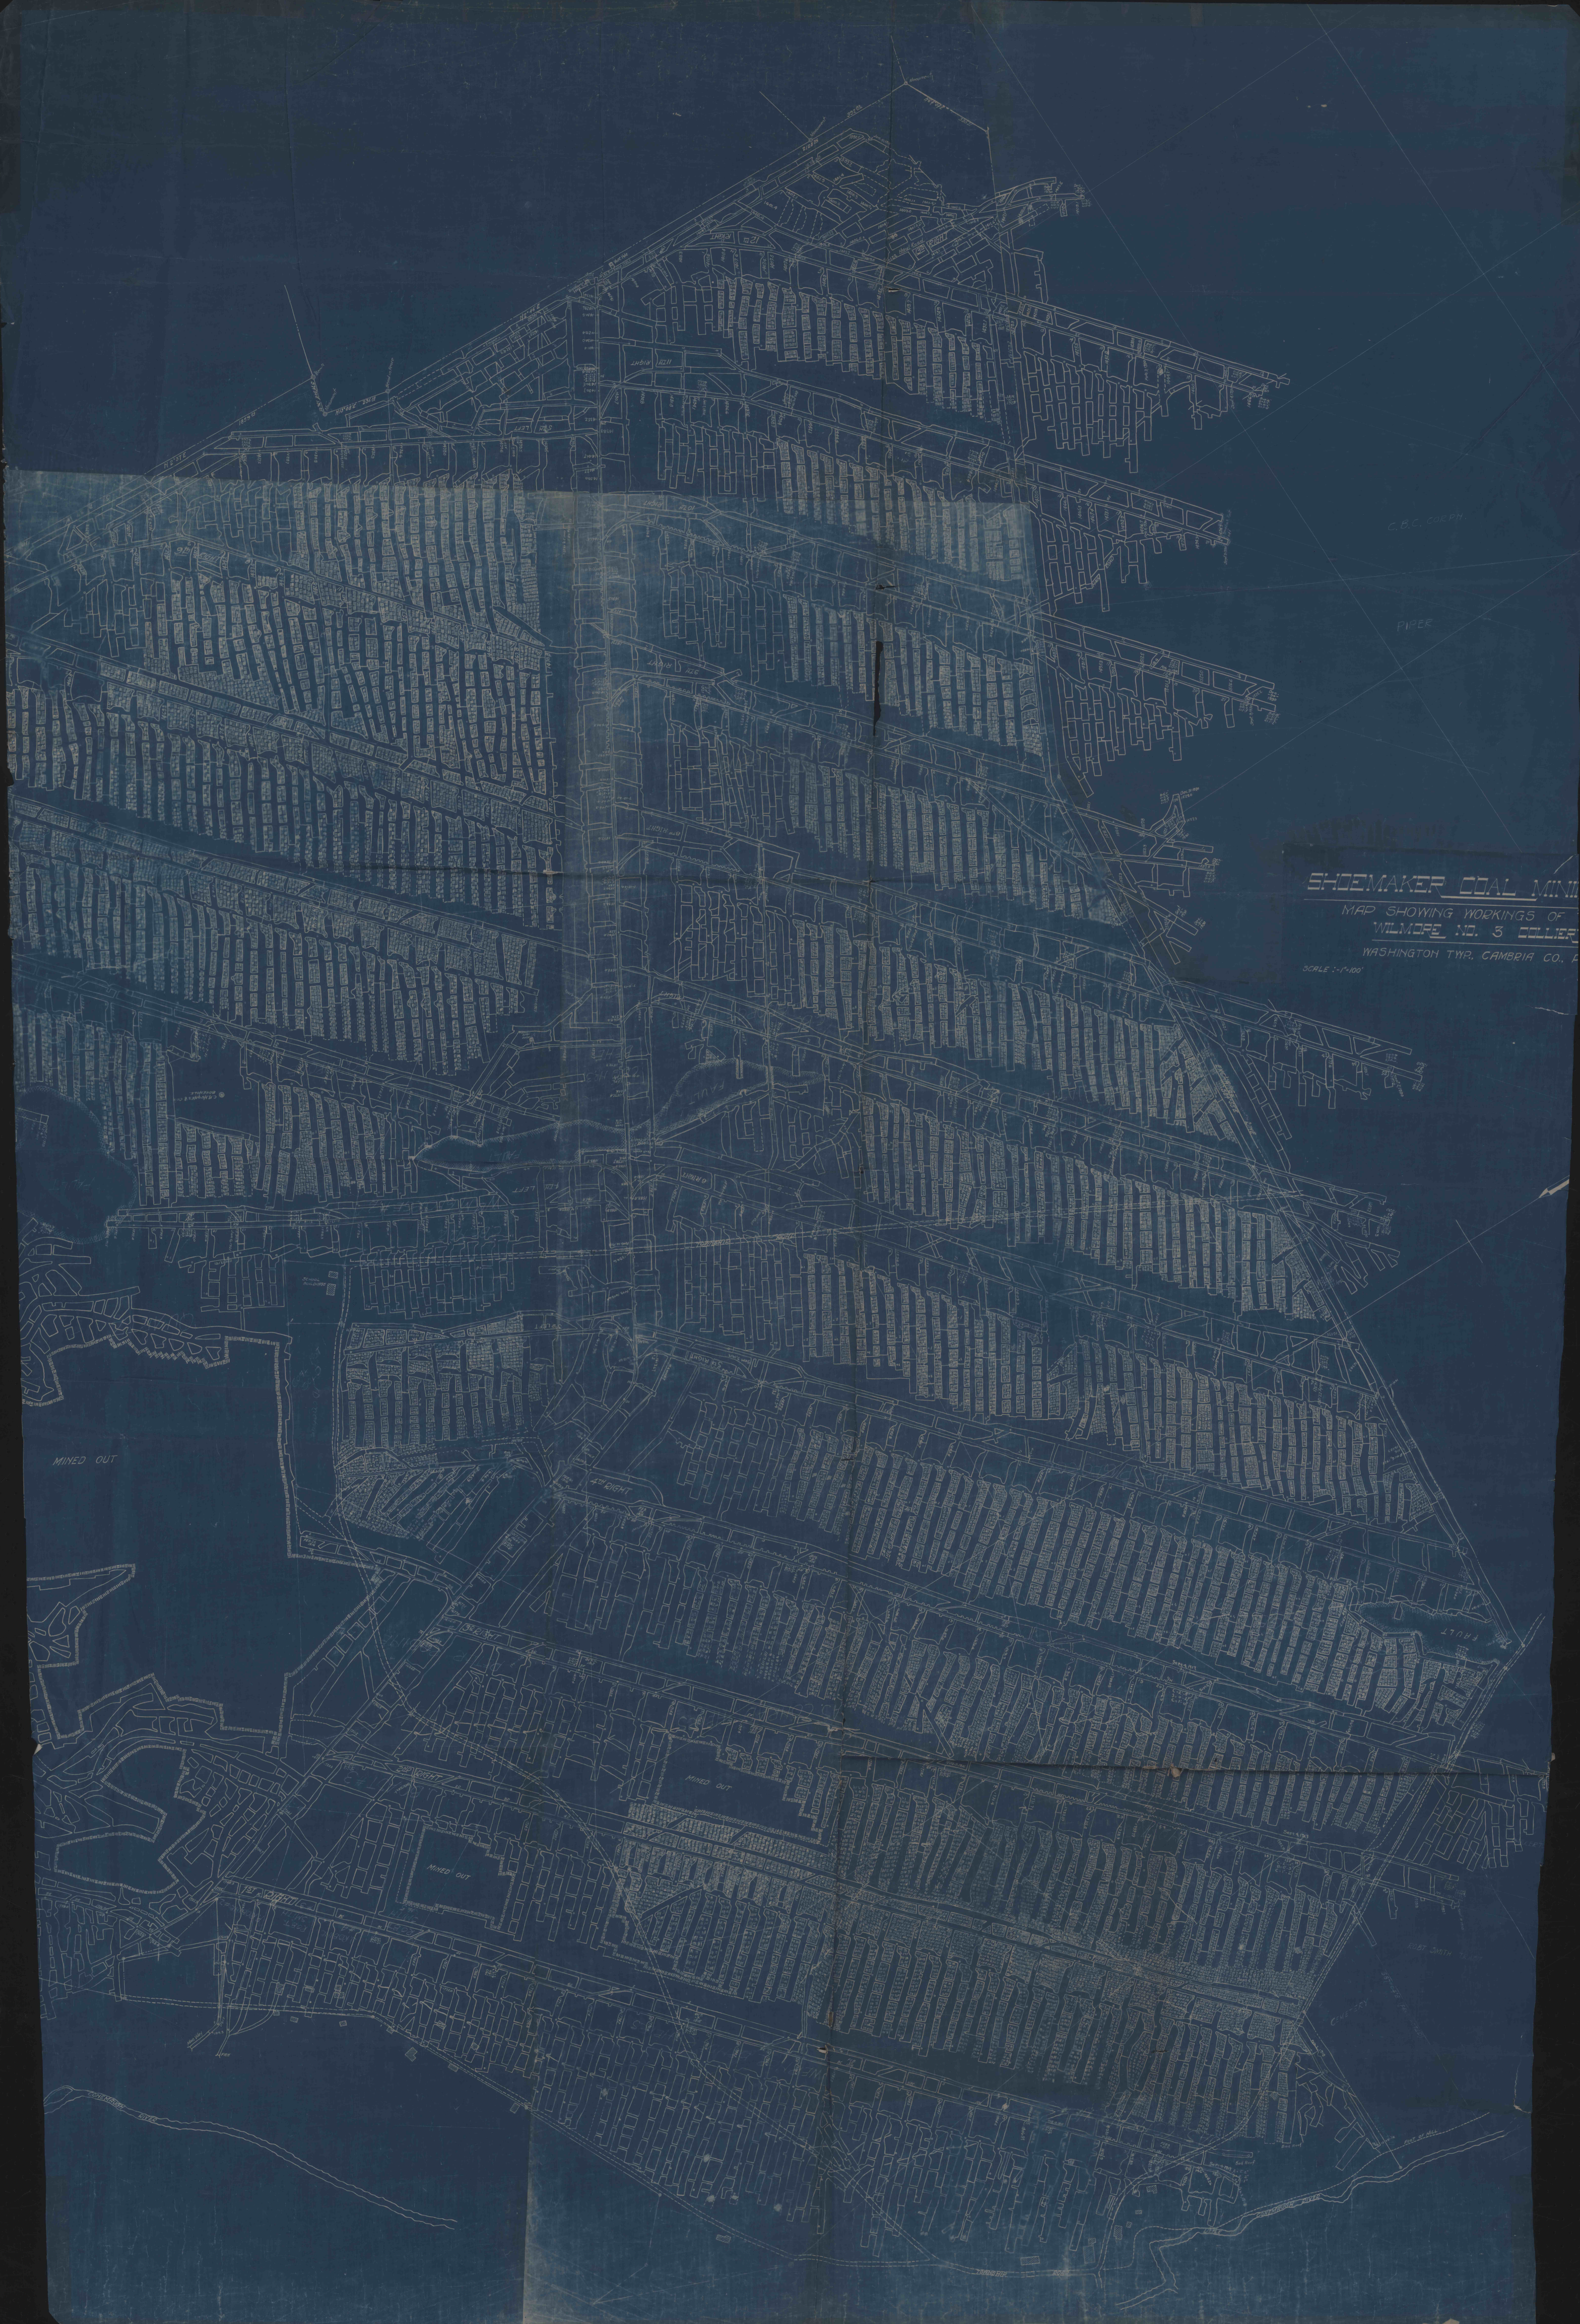

MINED OUT

MINED OUT

MINED OUT

C.C. DEPT

PIPER

FAULT

FAULT

FAULT