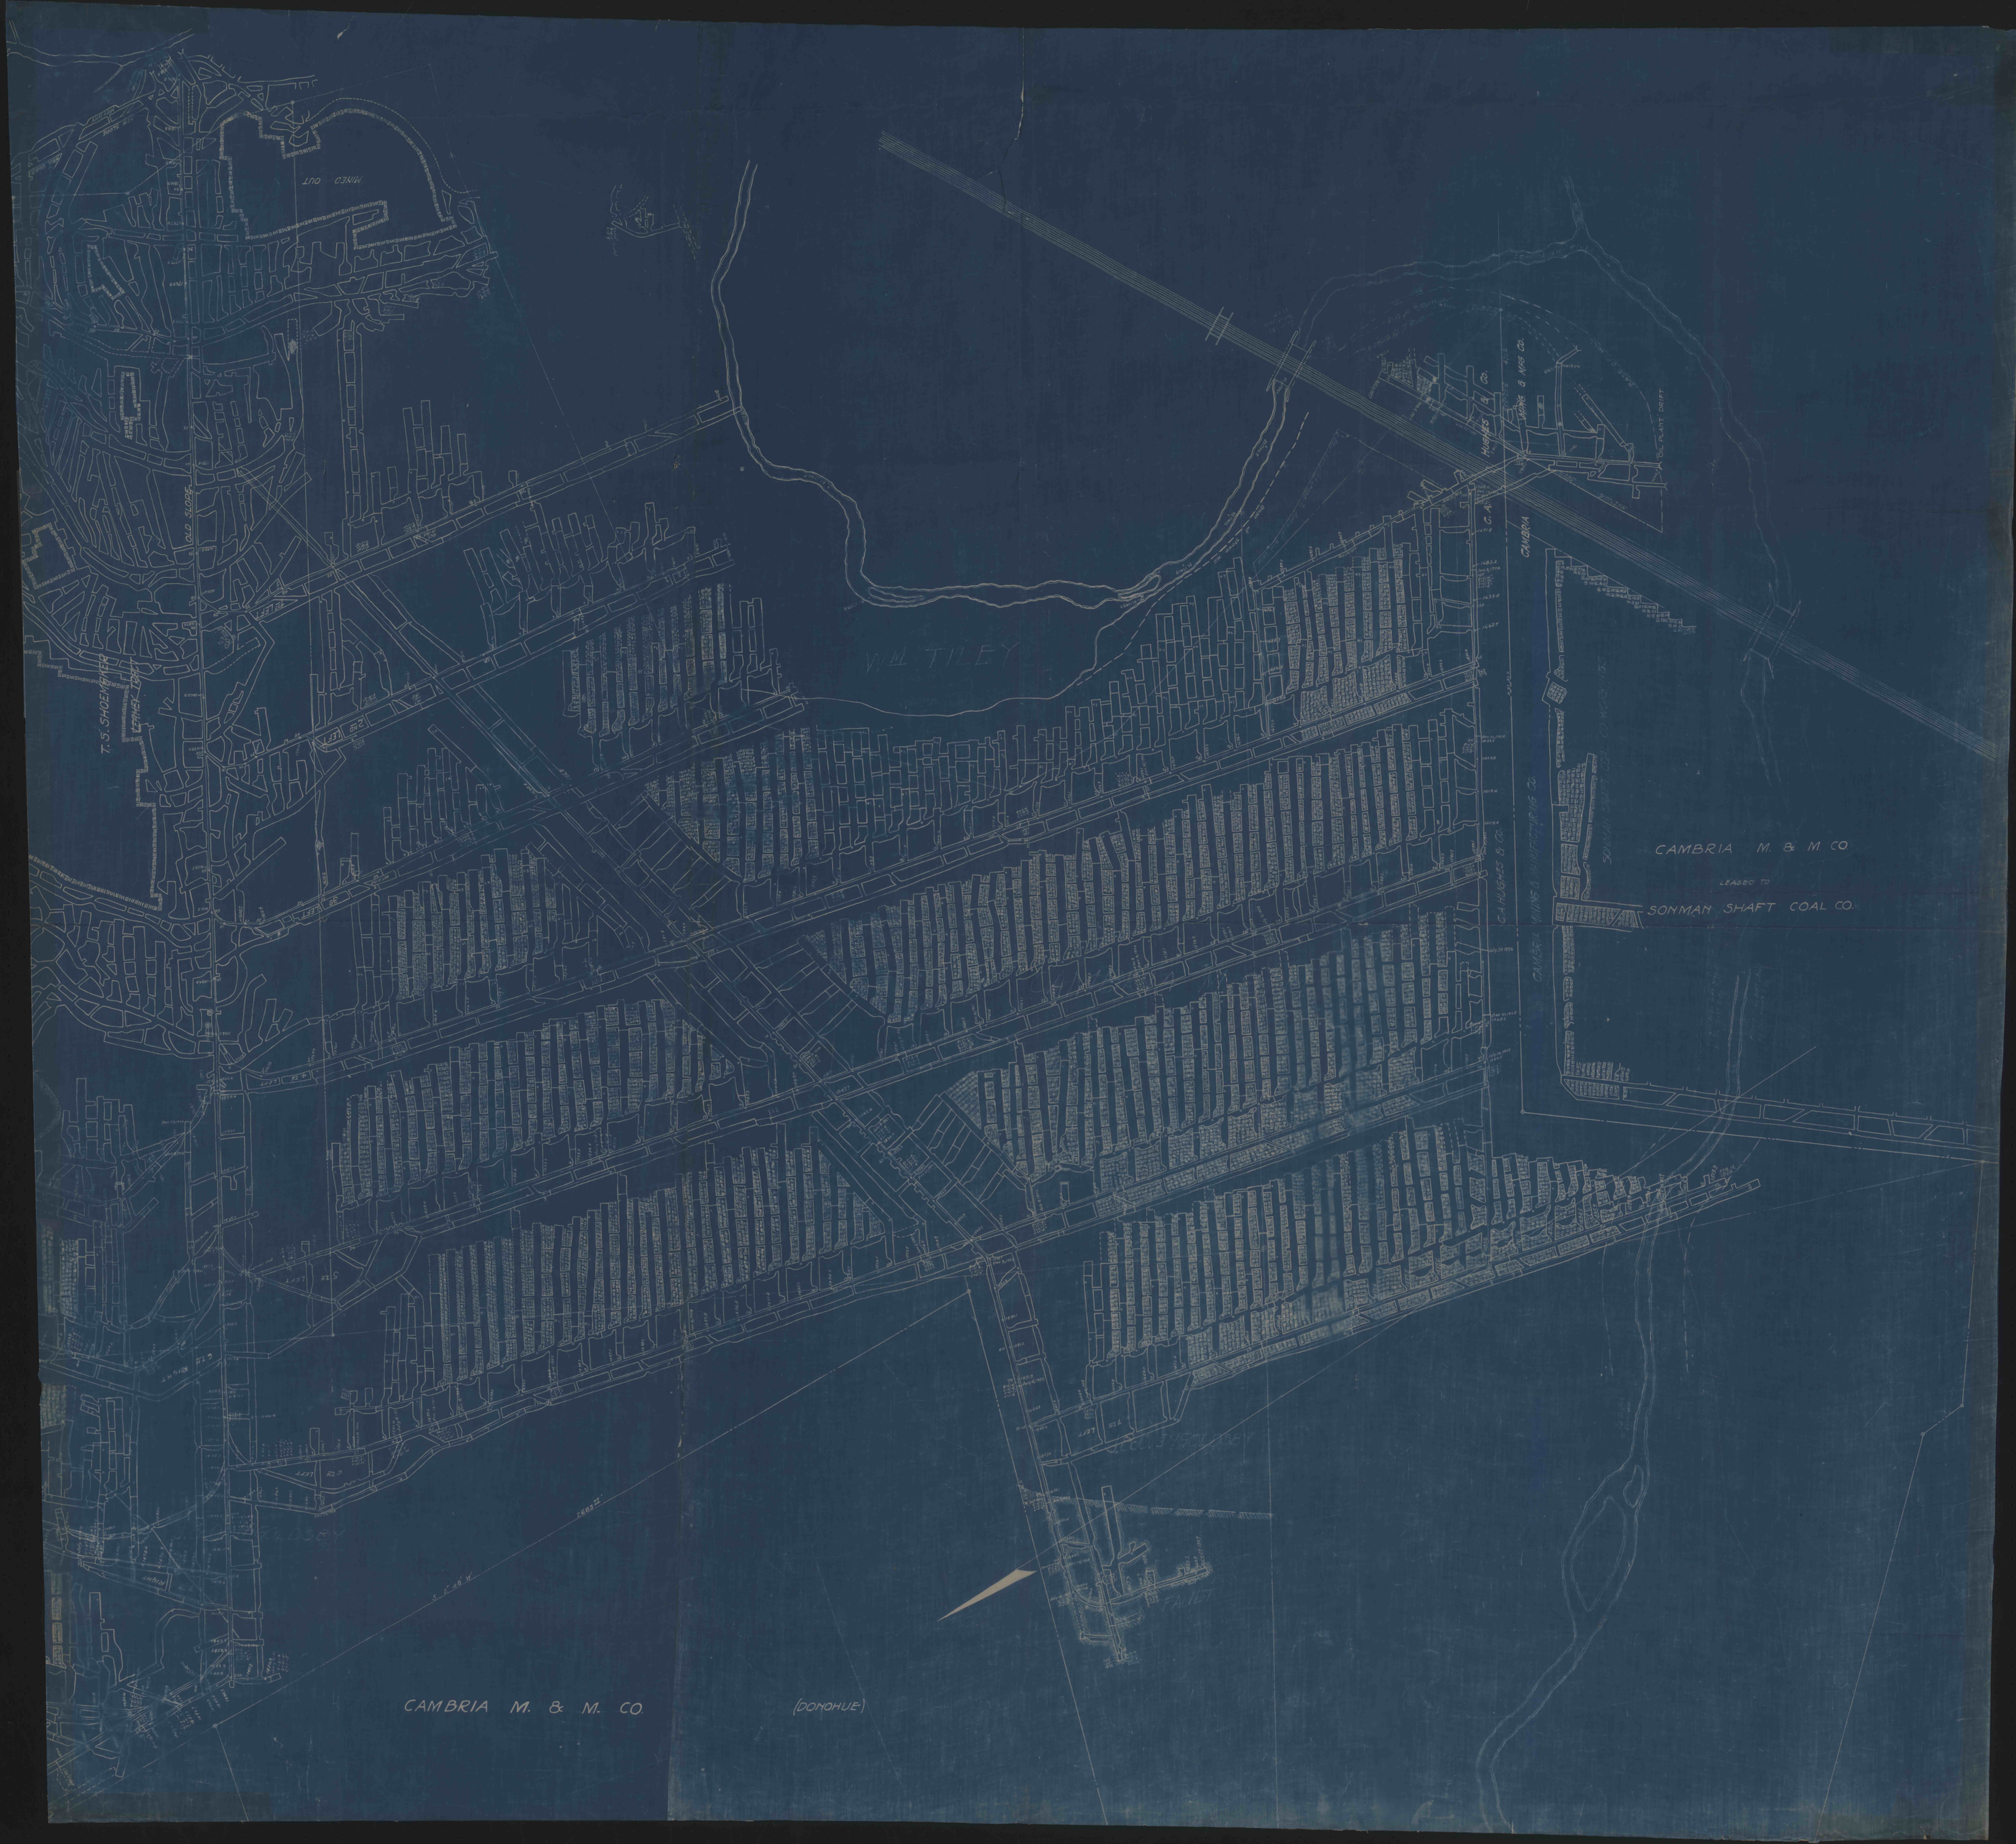
MINED OUT
OLD SLOPE
T. S. SHOEMAKER
LEHEY TRACT
Wm TILEY
HUGHES & CO.
WAGNE & MFG CO.
OIL PLANT DRIFT
CAMBRIA
CAMBRIA M. & M. CO
LEASED TO
SONMAN SHAFT COAL CO.
CAMBRIA M. & M. CO.
(DONOHUE)
FAULT