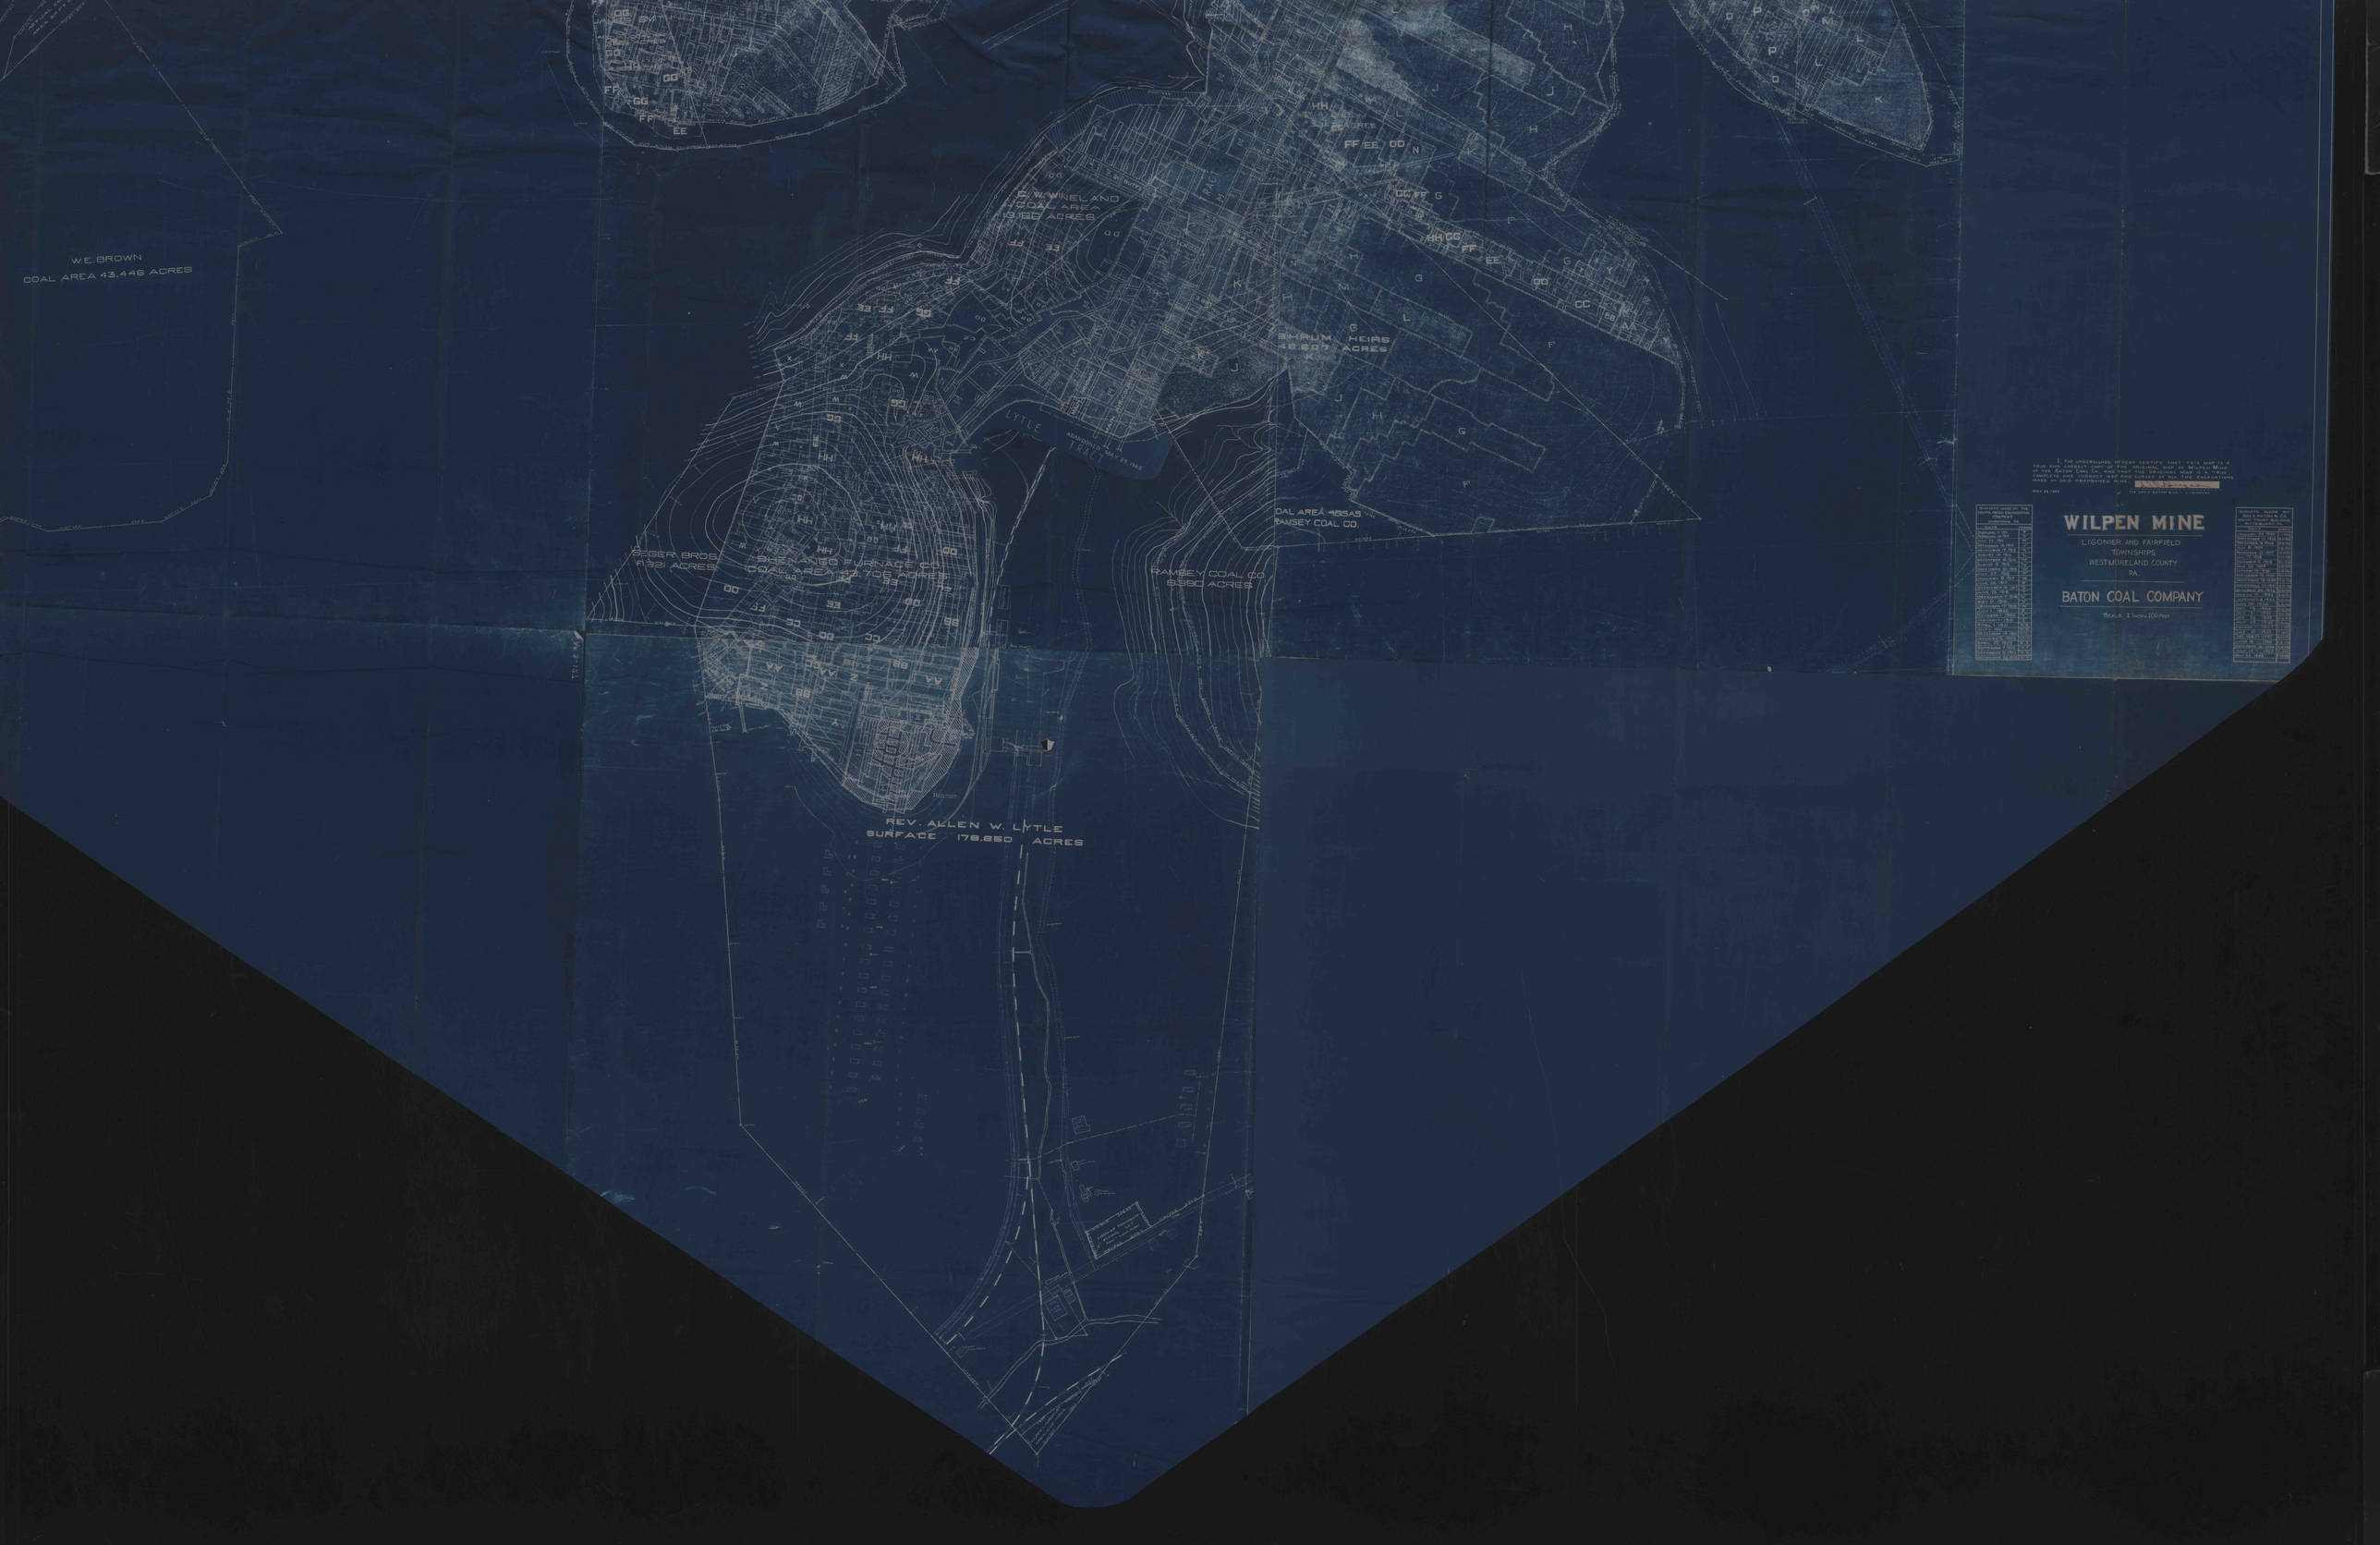
W.E. BROWN
COAL AREA 43,446 ACRES
C. W. WINELAND
COAL AREA
3,180 ACRES
SHRUM HEIRS
48,607 ACRES
LYTLE
TRACT
ABANDONED MAY 21, 1945
COAL AREA 465A5
RAMSEY COAL CO.
SEGER BROS
7,321 ACRES
SHENANGO FURNACE CO
COAL AREA 42,706 ACRES
RAMSEY COAL CO
8,350 ACRES
REV. ALLEN W. LYTLE
SURFACE 178,850 ACRES
WILPEN MINE
LIGONIER AND FAIRFIELD
TOWNSHIPS
WESTMORELAND COUNTY
PA.
BATON COAL COMPANY
SCALE 1 INCH = 100 FEET