


N

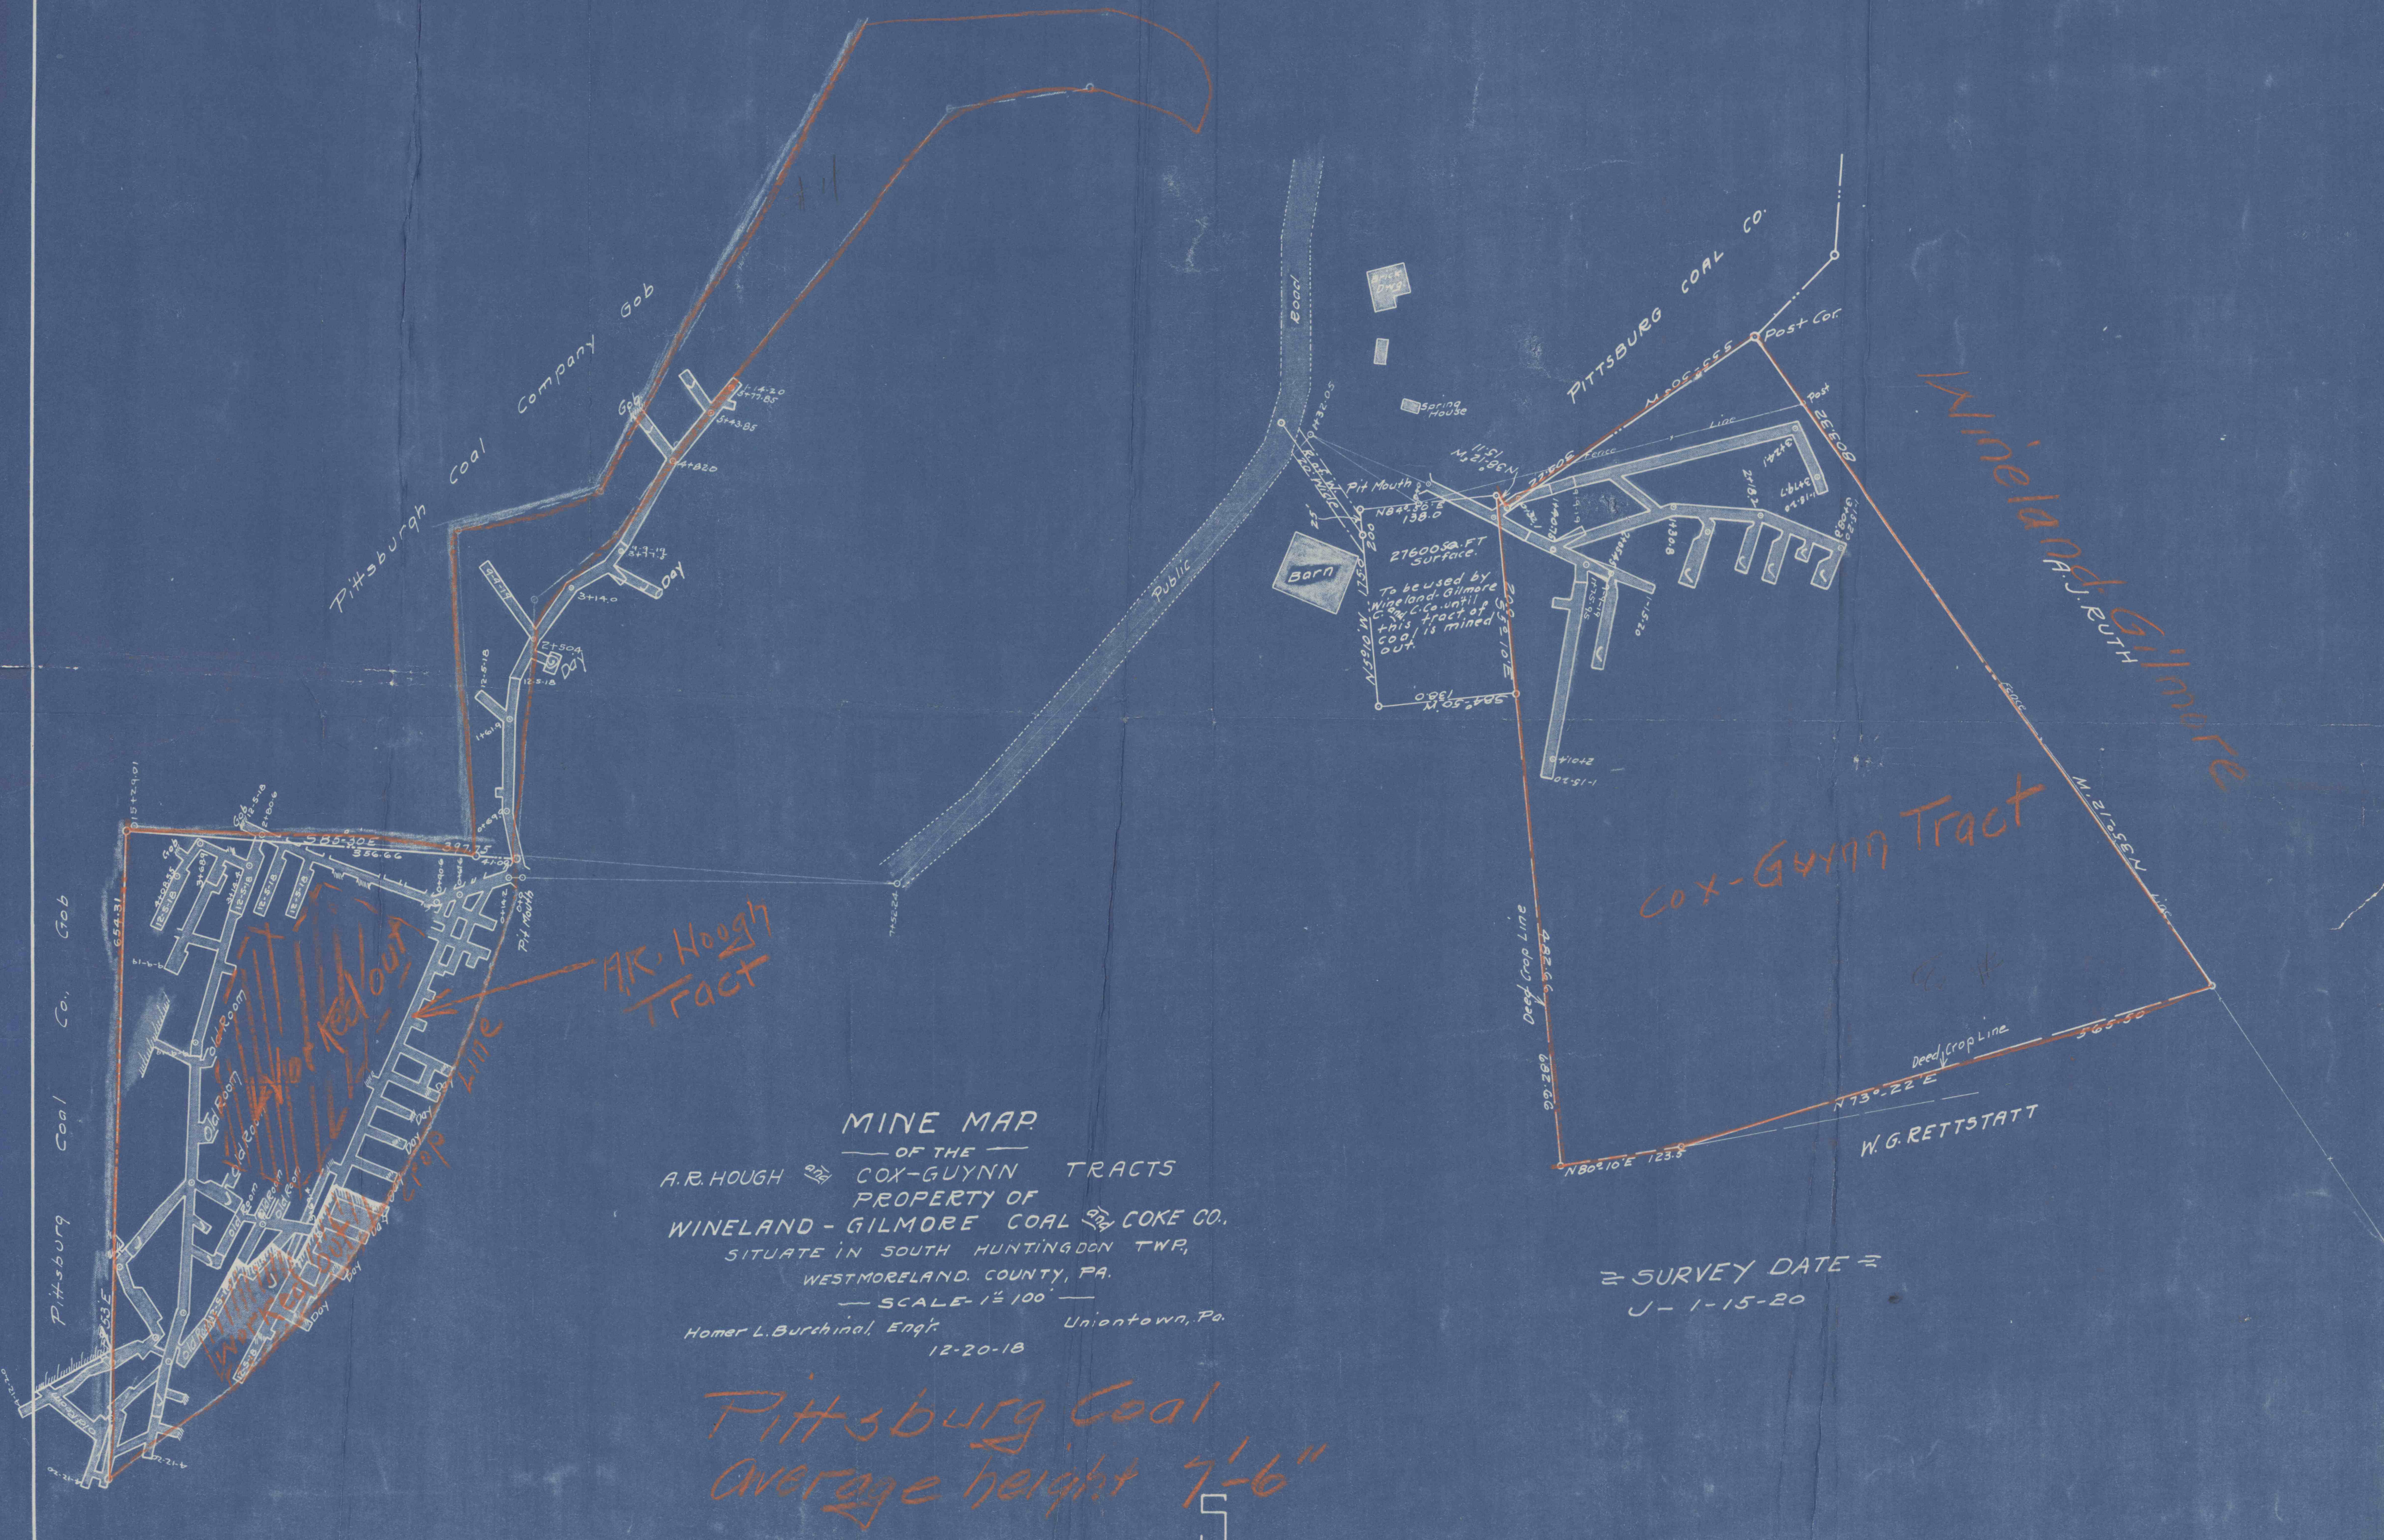

MINE MAP  
 OF THE  
 A.R. HOUGH <sup>227</sup> COX-GUINN TRACTS  
 PROPERTY OF  
 WINELAND - GILMORE COAL <sup>227</sup> COKE CO.,  
 SITUATE IN SOUTH HUNTINGDON TWP,  
 WESTMORELAND COUNTY, PA.  
 SCALE - 1" = 100'  
 Homer L. Burchinal, Engr. Uniontown, Pa.  
 12-20-18

≈ SURVEY DATE ≈  
 J - 1 - 15 - 20

Pittsburg Coal  
 Average height 7'-6"

1 MINE OPENING  
 NAME " WINMORE

Wineland-Gilmore

Cox-Guynn Tract

W. G. RETTSTATT