

Emmett Johnson
Tract No 252
Name
Fred Marshall

Dunkley Coal Co


Josiah Frye
Tract 460

Henry Blough
Tract No 456
Name
Geistown Lions Club

Josiah Frye
Tract No 460
Name
J.I. Whalley

J.F. A...
Tract No 255

LEGEND
[Symbol] MINING COMPLETED
[Symbol] 6 MONTHS ADVANCE 2-29-68-8-29-68
[Symbol] PROPERTY LINE

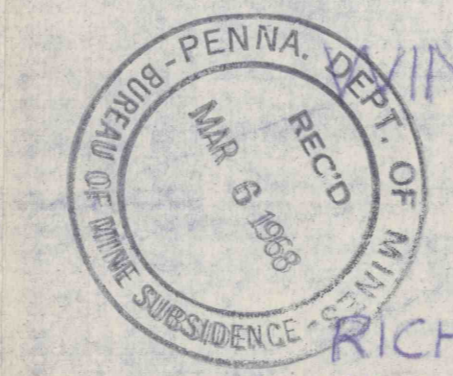

WINDBER HIGH GRADE COAL CO
WYATT NO 7 MINE
C PRIME SEAM
RICHLAND TWP
SCALE 1"=100'
DEC 11 1952

P.E. Emman
R.P.E. 7074

State Highway

FIELD COPY

PRODUCTION # 2265-214
262-16-1952
Cambria Co

