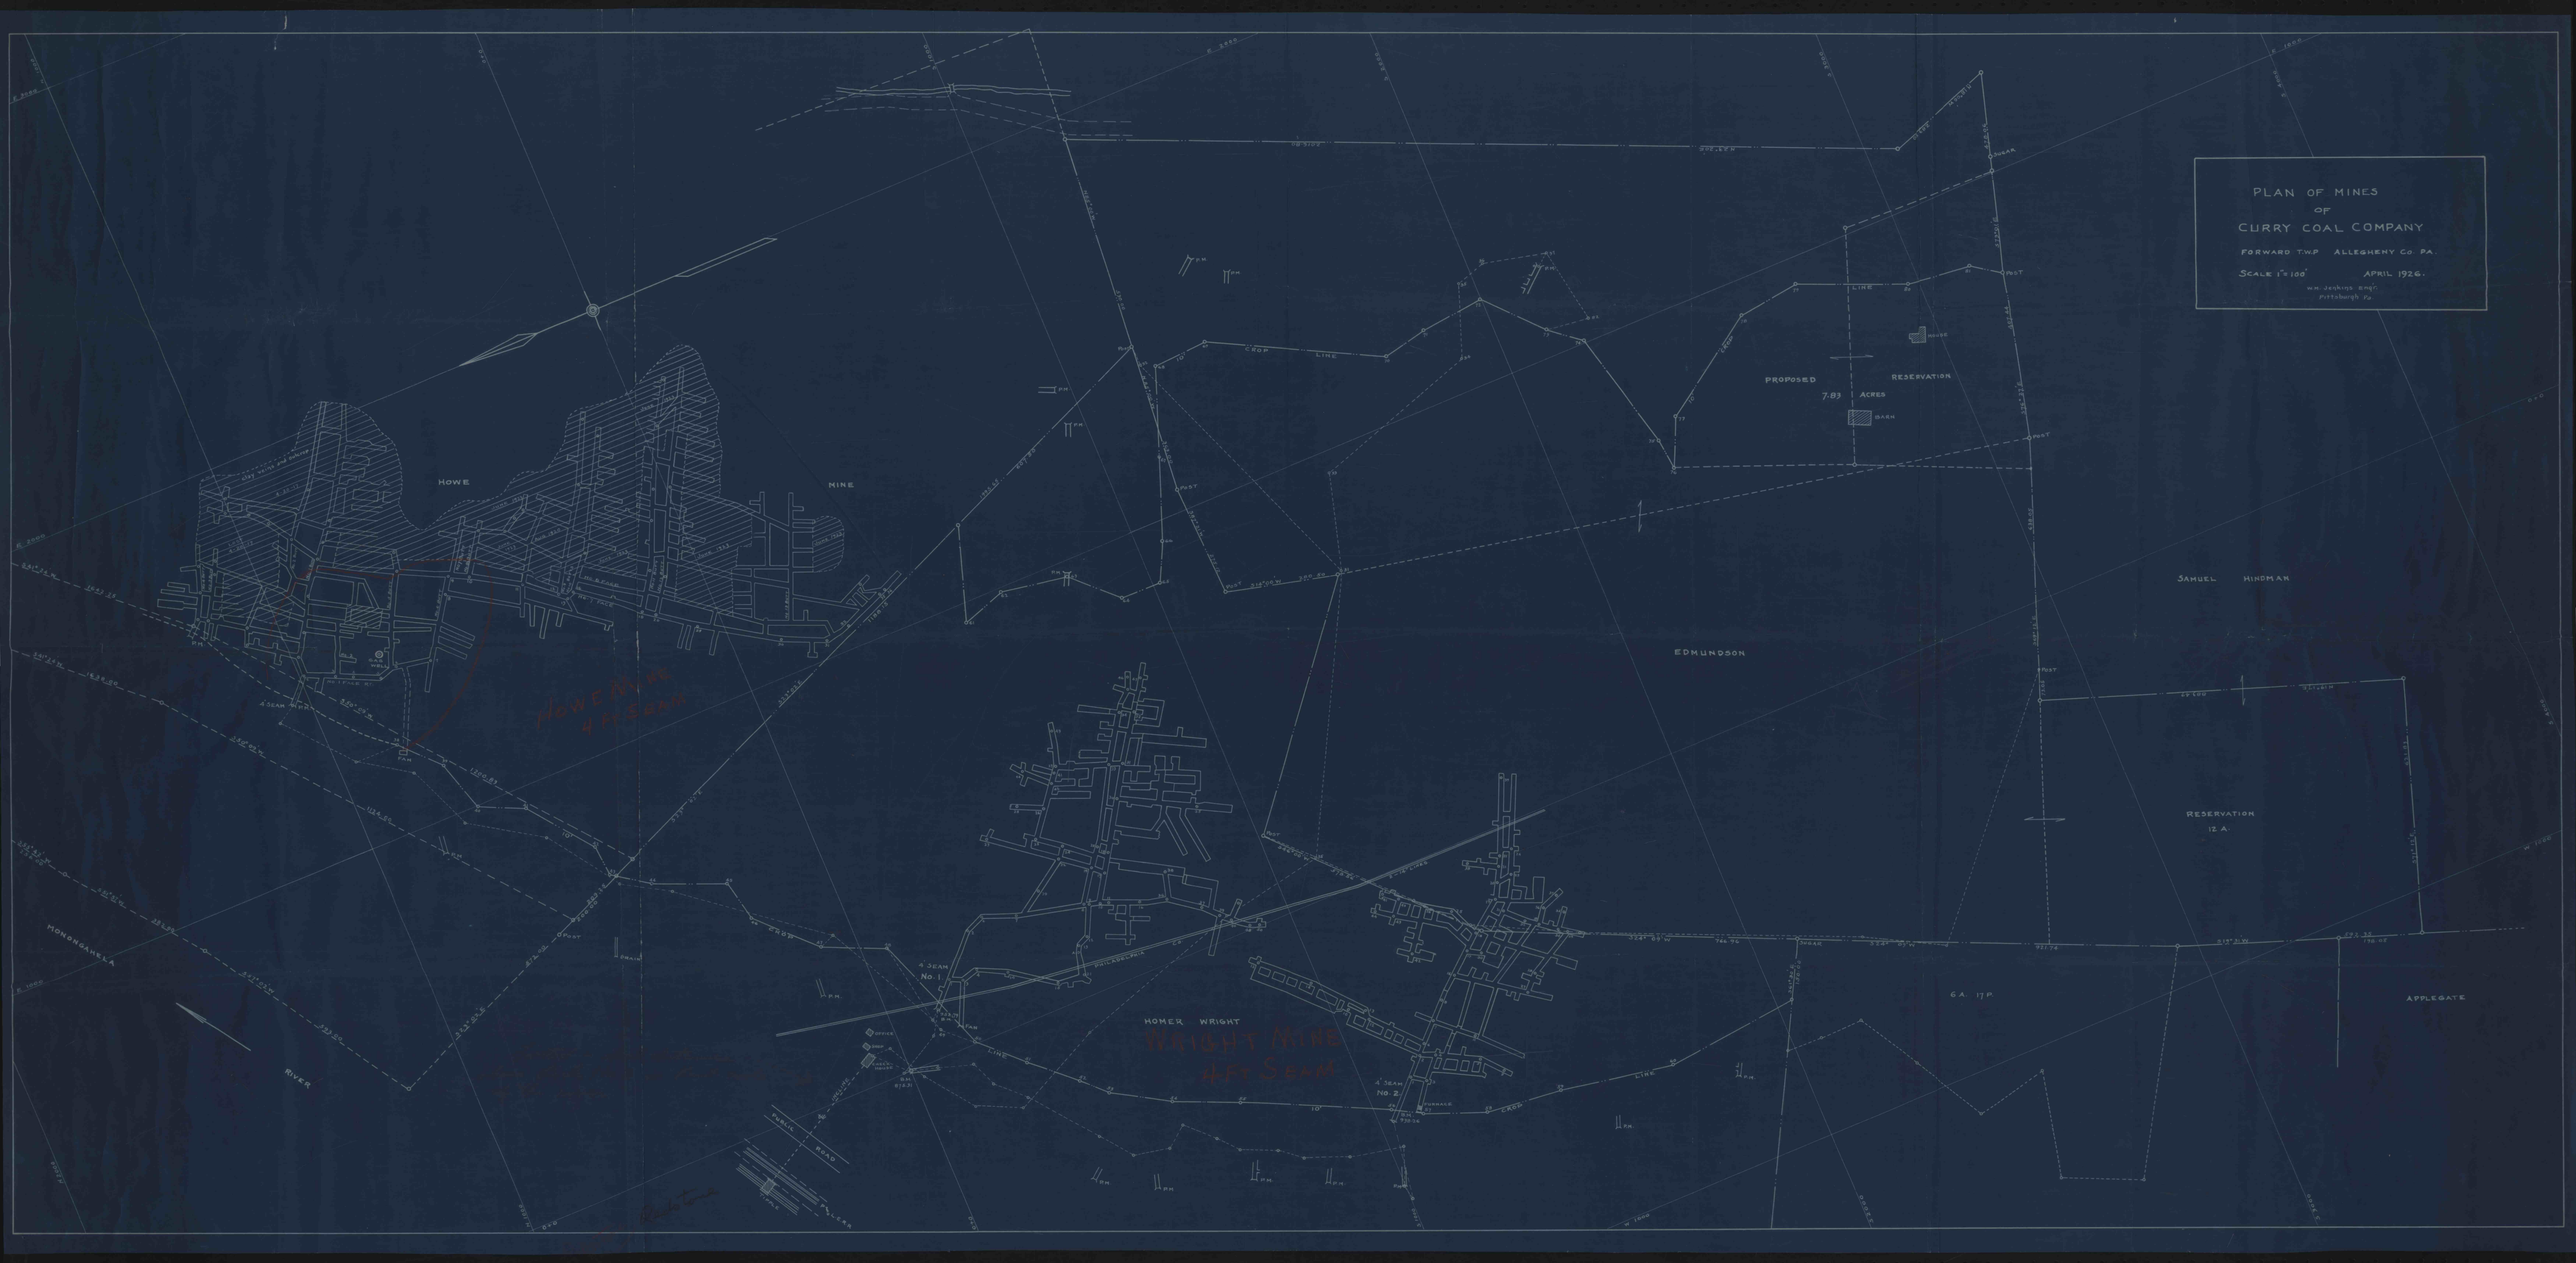
PLAN OF MINES
OF
CURRY COAL COMPANY
FORWARD T.WP ALLEGHENY Co. PA.
SCALE 1"= 100' APRIL 1926.
WM. Jenkins Engr.
Pittsburgh Pa.
HOWE
MINE
HOWE MINE
4 FT SEAM
PROPOSED
RESERVATION
7.83
ACRES
BARN
HOUSE
CROP
LINE
EDMUNDSON
SAMUEL HINDMAN
RESERVATION
12 A.
APPLEGATE
G.A. 17 P.
HOMER WRIGHT
WRIGHT MINE
4 FT SEAM
A SEAM
No. 1
A SEAM
No. 2
OFFICE
SHOP
SCALE HOUSE
TIPPLE
FURNACE
PUBLIC ROAD
MONONGAHELA
RIVER