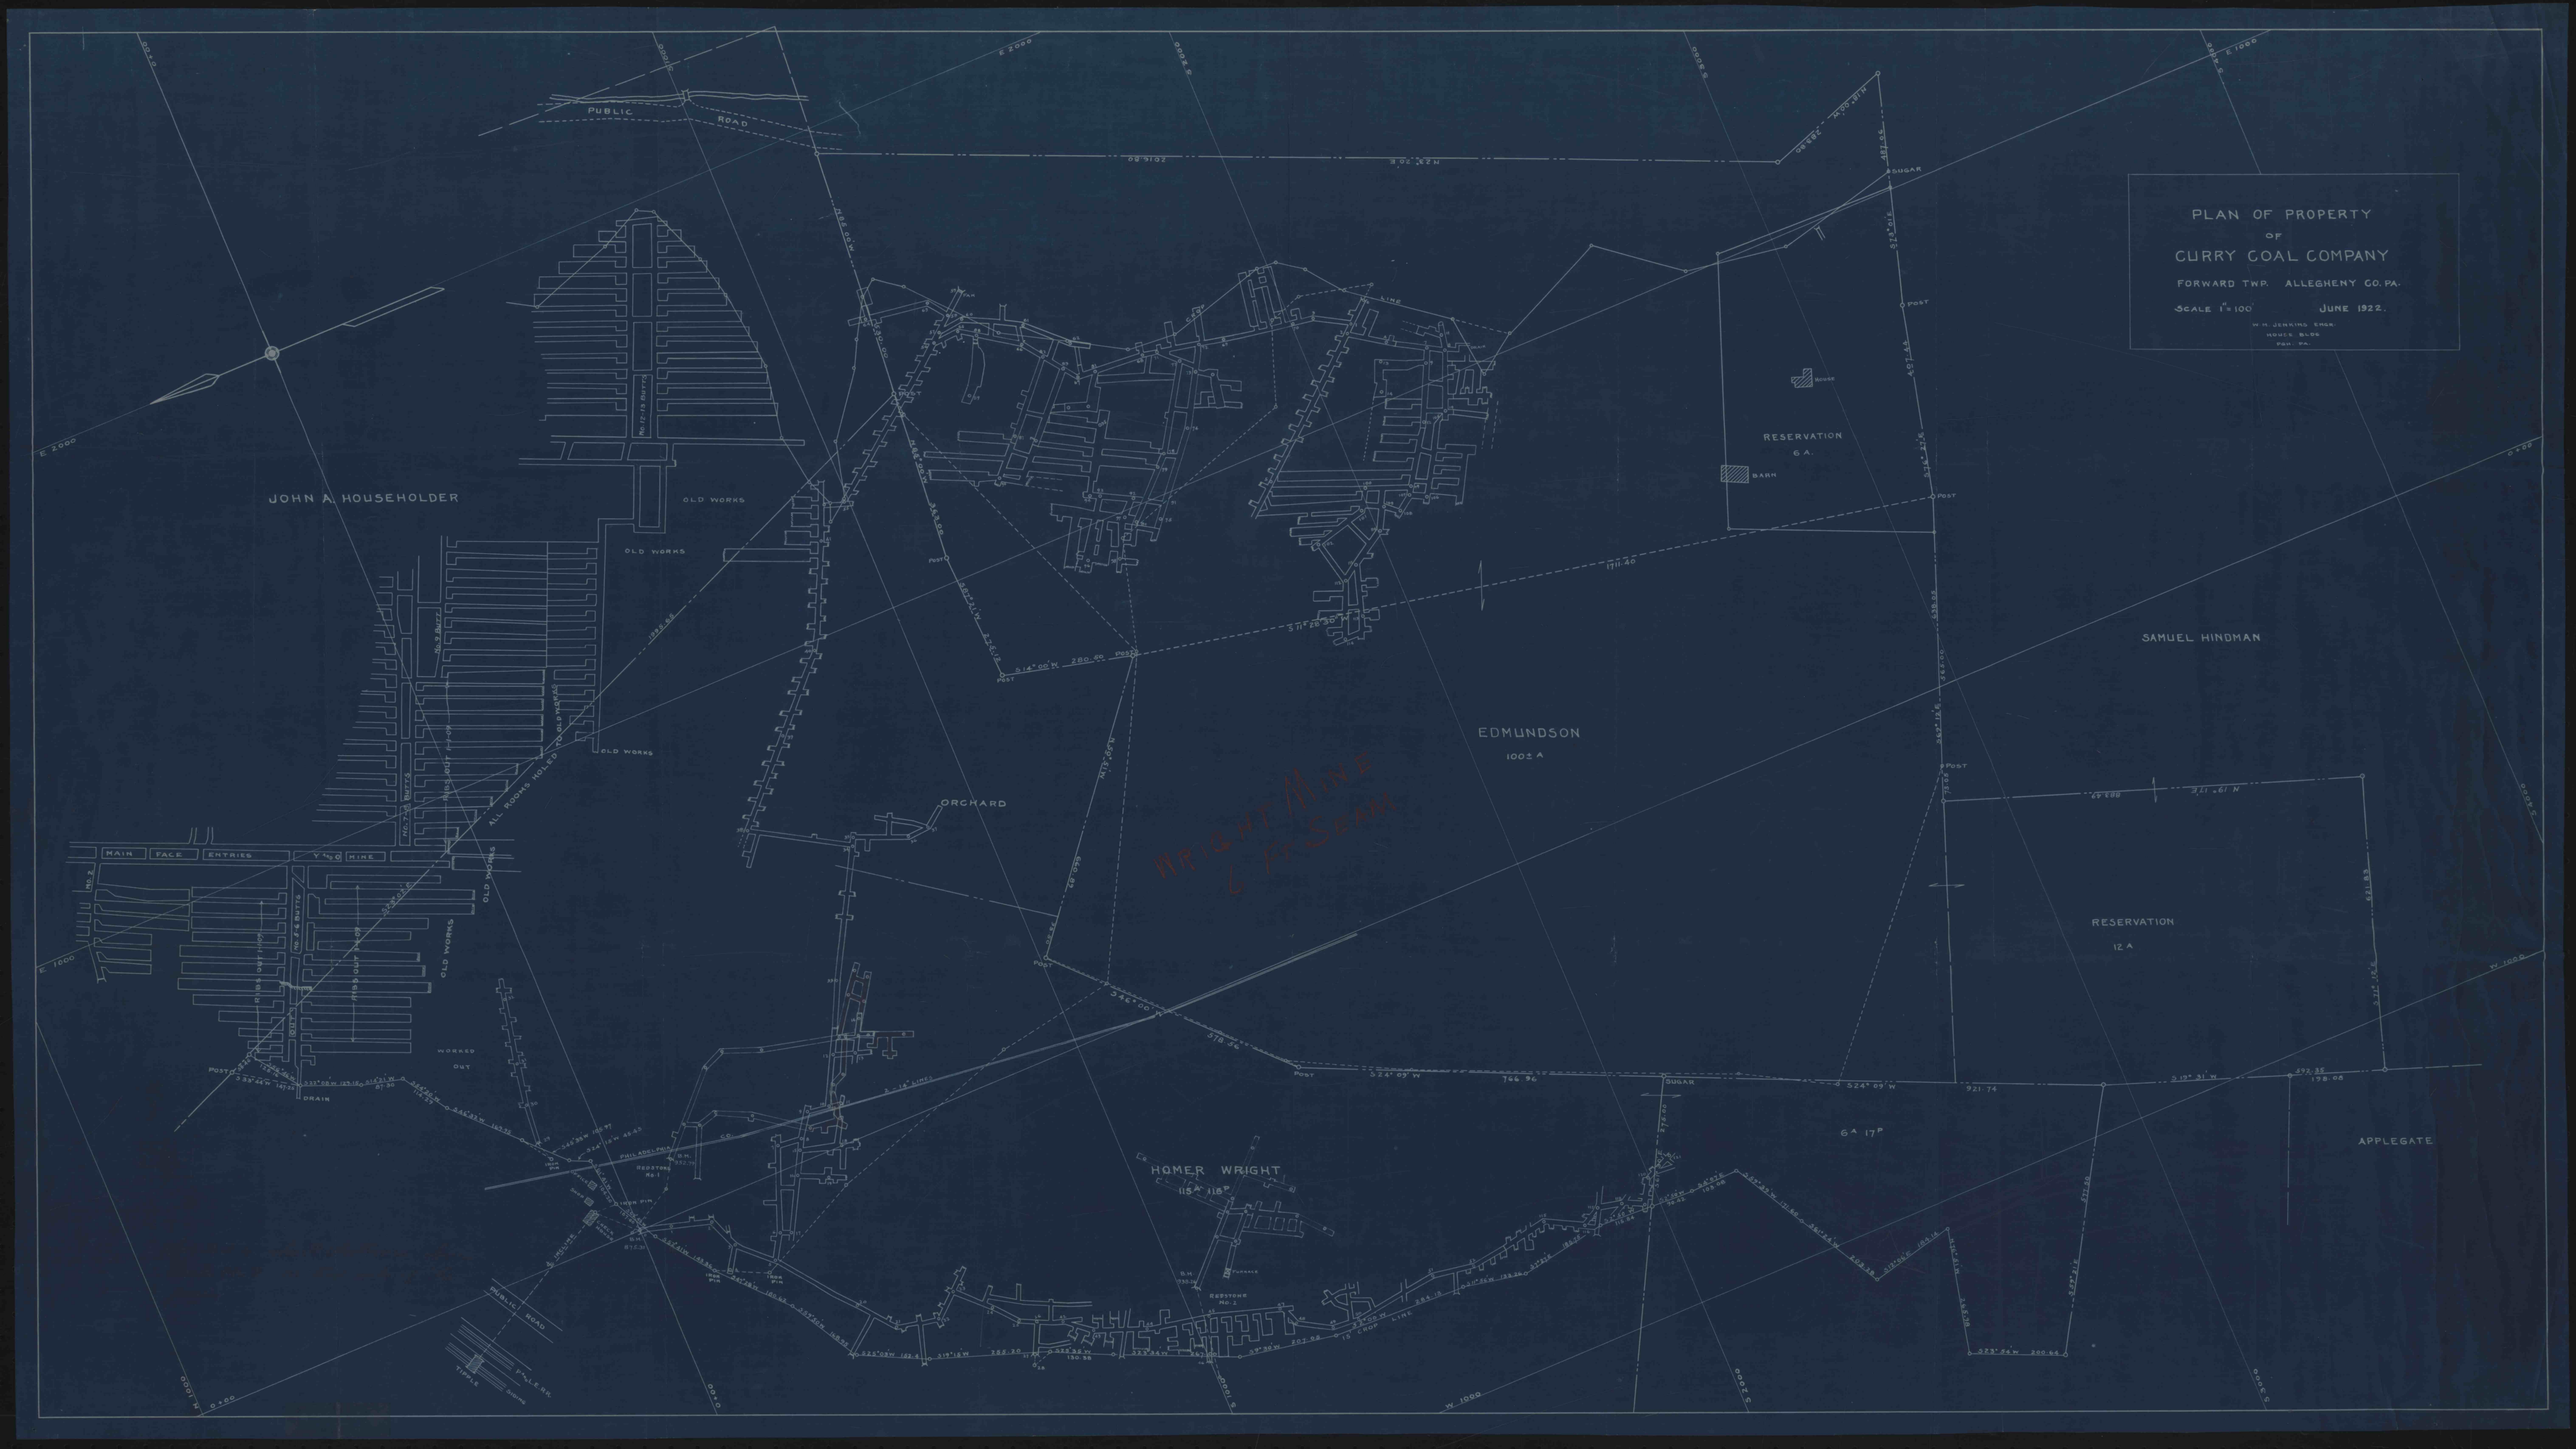
PLAN OF PROPERTY
OF
CURRY COAL COMPANY
FORWARD TWP. ALLEGHENY CO. PA.
SCALE 1" = 100' JUNE 1922.
W. H. JENKINS ENGR.
PGH. PA.
PUBLIC ROAD
JOHN A. HOUSEHOLDER
OLD WORKS
OLD WORKS
OLD WORKS
OLD WORKS
OLD WORKS
ALL ROOMS HOLED TO OLD WORKS
MAIN FACE ENTRIES
Y to O MINE
WORKED OUT
WORKED OUT
DRAIN
ORCHARD
EDMUNDSON
100± A
SAMUEL HINDMAN
RESERVATION
6 A.
BARN
HOUSE
POST
SUGAR
RESERVATION
12 A
6A 17P
APPLEGATE
HOMER WRIGHT
115A 118P
REPSTONE No. 1
REPSTONE No. 2
PHILADELPHIA CO.
PUBLIC ROAD
TIPPLE
TUNNEL
CROP LINE
WRIGHT MINE
L Fr SEAM