


258
WYAN OLIPHANT

250
FIT 10250

OLIPHANT'S PROPERTY

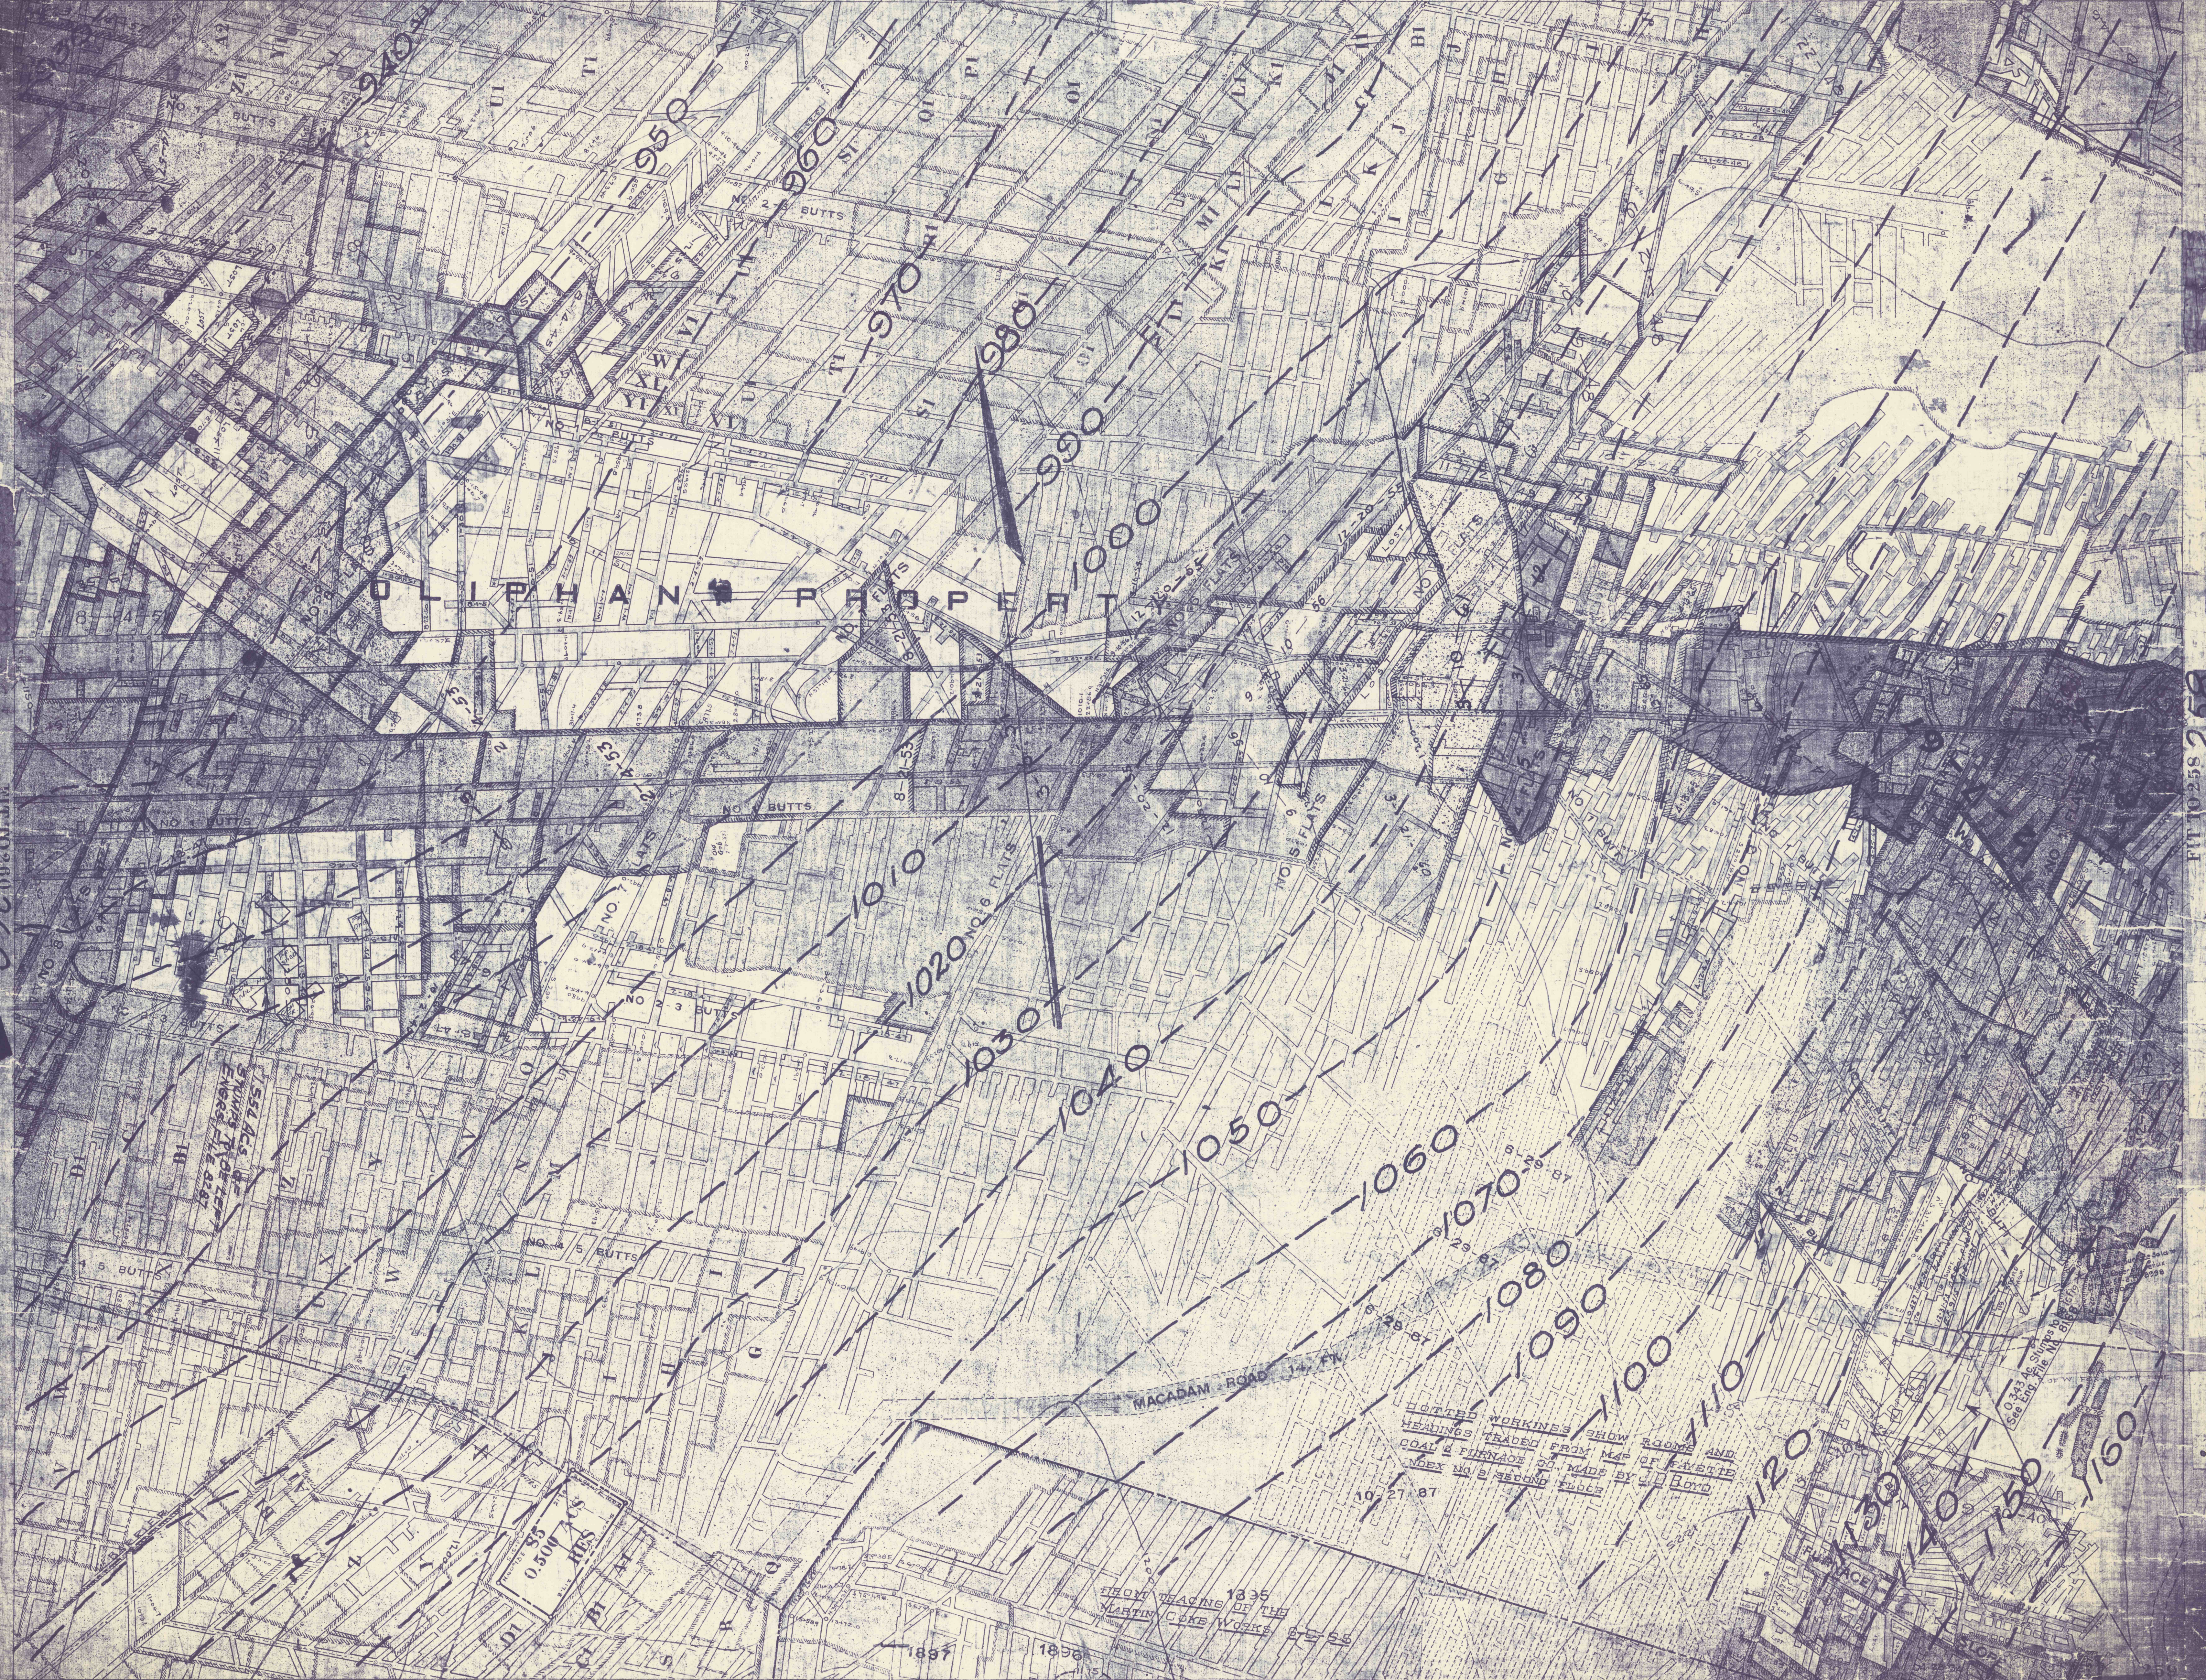

260
FIT 10260

258
FIT 10258

270
FIT 10270

259