


WYNN 280
TITLE SHEET

270
FIT TO 270

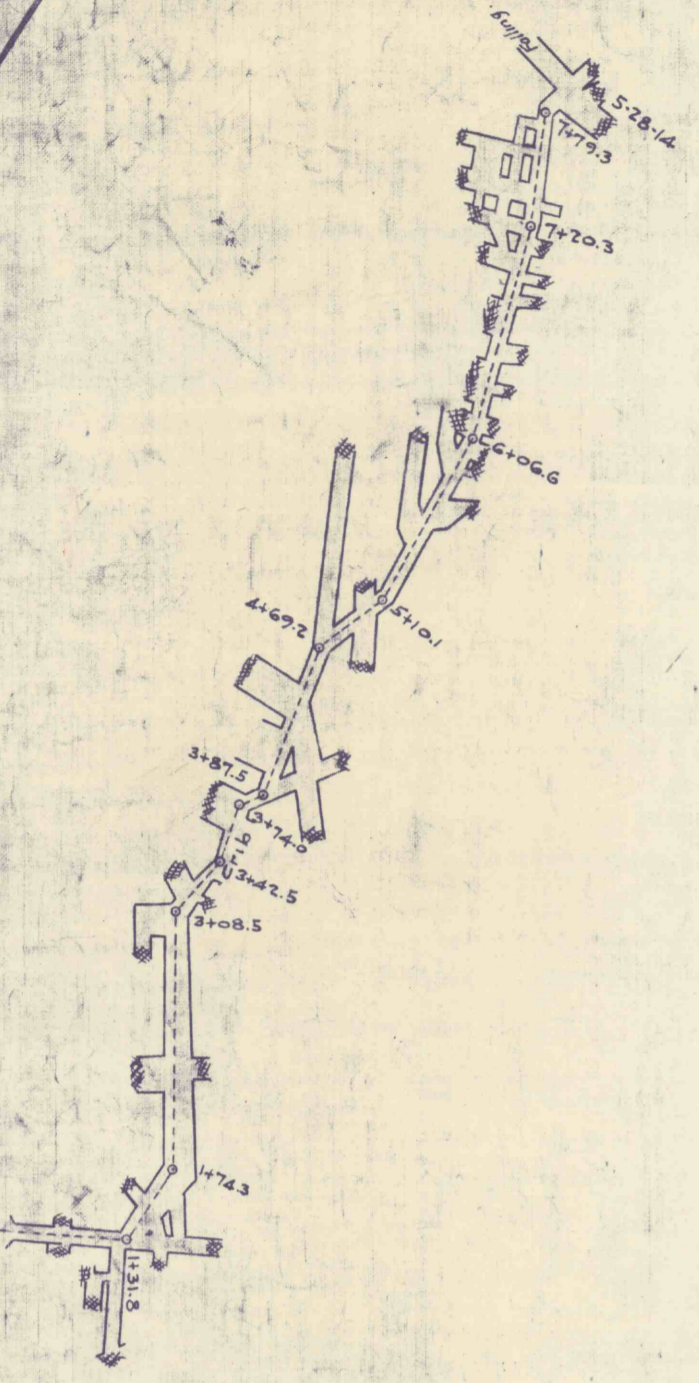

WYNN MINE

OF THE
H. C. FRICK COKE CO.

GEORGES TWP. - FAYETTE CO. - PA.

DATUM OF LEVELS 16.1 FT. BELOW MEAN TIDE AT SANDY HOOK

SCALE 1"=100'

DATE OF SURVEYS

1-23-1892	A	9-5-1907	A-1	1-5-1910	A-2	S.J.P.	4-9-1918	A-3	R.H.
3-24-1892	B	12-12-1907	B-1	4-5-1910	B-2	A.S.	10-9-1918	B-3	A.S.
11-1-1892	C	5-22-1903	D-1	10-9-1910	C-2	T.S.	4-2-1919	C-3	R.H.
10-18-1892	D	5-22-1903	E-1	10-9-1910	D-2	T.S.	10-6-1919	D-3	R.H.
12-1-1892	E	5-22-1903	F-1	1-4-1911	E-2	T.S.	4-9-1920	E-3	R.H.
12-24-1894	F	5-21-1904	G-1	1-4-1911	F-2	T.S.	10-11-1920	F-3	R.H.
3-25-1895	G	9-20-1904	H-1	6-28-1911	G-2	T.S.	2-16-1921	G-3	R.H.
5-28-1895	H	1-30-1905	H-1	10-4-1911	H-2	T.S.	10-9-1922	H-3	R.H.
10-21-1895	I	5-4-1905	I-1	1-4-1912	I-2	A.S.	4-3-1923	I-3	R.H.
1-15-1896	J	8-4-1905	J-1	4-3-1912	J-2	T.S.	10-2-1923	J-3	A.S.
3-6-1896	K	11-4-1905	K-1	7-2-1912	K-2	A.S.	4-23-1924	K-3	R.H.
1-4-1898	L	2-4-1906	L-1	10-5-1912	L-2	T.S.	4-7-1925	L-3	R.H.
4-11-1898	M	6-26-1906	M-1	1-2-1913	M-2	A.S.	3-5-1926	M-3	A.S.
7-5-1898	N	10-18-1906	N-1	J.T.	4-2-1913	N-2	J.Z.		
10-5-1898	O	1-23-1907	O-1	T.S.	7-3-1913	O-2	A.S.		
12-21-1898	P	4-6-1907	P-1	J.T.	10-3-1913	P-2	J.Z.		
5-23-1899	Q	7-9-1907	Q-1	T.S.	1-1-1914	Q-2	J.Z.		
8-17-1899	R	10-8-1907	R-1	J.T.	4-3-1914	R-2	J.Z.		
11-22-1899	S	1-1-1908	S-1	T.S.	7-9-1914	S-2	J.Z.		
2-27-1900	T	4-7-1908	T-1	T.S.	10-3-1914	T-2	J.Z.		
5-15-1900	U	7-9-1908	U-1	T.S.	11-10-1914	U-2	J.Z.		
5-8-1901	V	10-2-1908	V-1	T.S.	10-5-1915	V-2	T.S.		
8-26-1901	W	12-29-1909	W-1	W.R.	4-6-1916	W-2	A.S.		
11-18-1901	X	4-5-1909	X-1	J.T.	10-4-1916	X-2	A.S.		
		7-9-1909	Y-1	W.R.	4-4-1917	Y-2	F.Y.		
6-21-1902	Z	10-8-1909	Z-1	W.S.	10-5-1917	Z-2	F.Y.		

262	261	260	259
213	212	211	210
282	281	TITLE SHEET	

11 SHEETS - FIT THUS.