

STEWART HRS
AREA 12,866 ACRES
IN FEEL

LOUIS SNYDER

FURNACE COS MINE
SURFACE SOLD TO
SAMUEL MCCOY
AREA 11,733 ACS


WORKED OUT
SURFACE CONVEYED BY UNITED STATES STEEL CORP. TO
RUANE COKE CO. AUG. 6, 1957 E.F. 9773
TOTAL AREA 14,253 ACS.
DWG. 14-D-813

SURFACE SOLD 6-26-73
TO DOCK MICKENS
AREA 5,000 ACRES
Eggs' File #4477 12-D-1405

SOLD FEB 15, 1939 TO
GEORGE V. KUNTZ
AREA 1,828 ACRES
Eggs' File #7200 14-C-61

FAIRCHANCE MINE

FAIRCHANCE
BORO
3-31-66
7-31-67
11-30-65
2-26-65

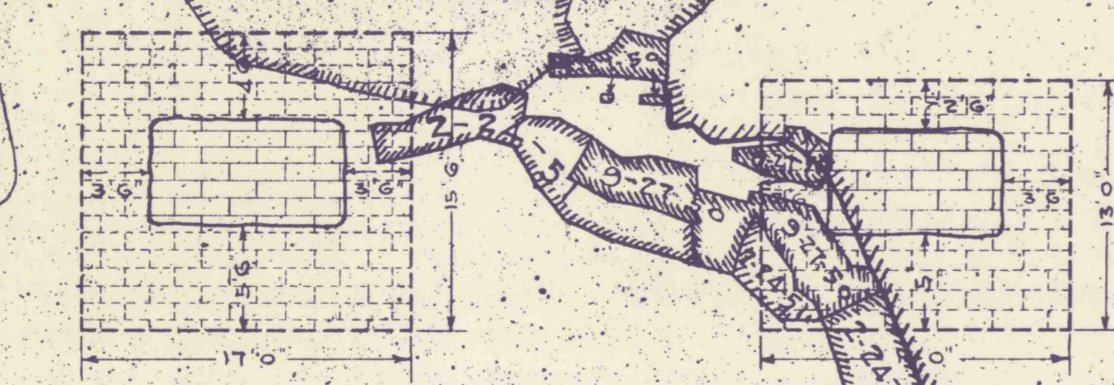

DAM NO. 2
LOCATION - MANWAY STA 2150+62' LOCATION - SLOPE HEADING STA. 1032+11'
THICKNESS AT TOP - 3 FT. THICKNESS AT TOP - 3' 0"
BOTTOM - 4 FT. BOTTOM - 3' 6"
CONSTRUCTION - RED BRICK LAID IN CEMENT MORTAR
COMPLETED - 2-21-12

Information taken from print accompanying letter of Supl. Police
to J.P.K.M. dated 2-26-12

RIGHT OF WAY FOR 4" PIPE LINE GRANTED 10-20-16 TO STAR GAS CO.