


Maple Sterling Coal Work

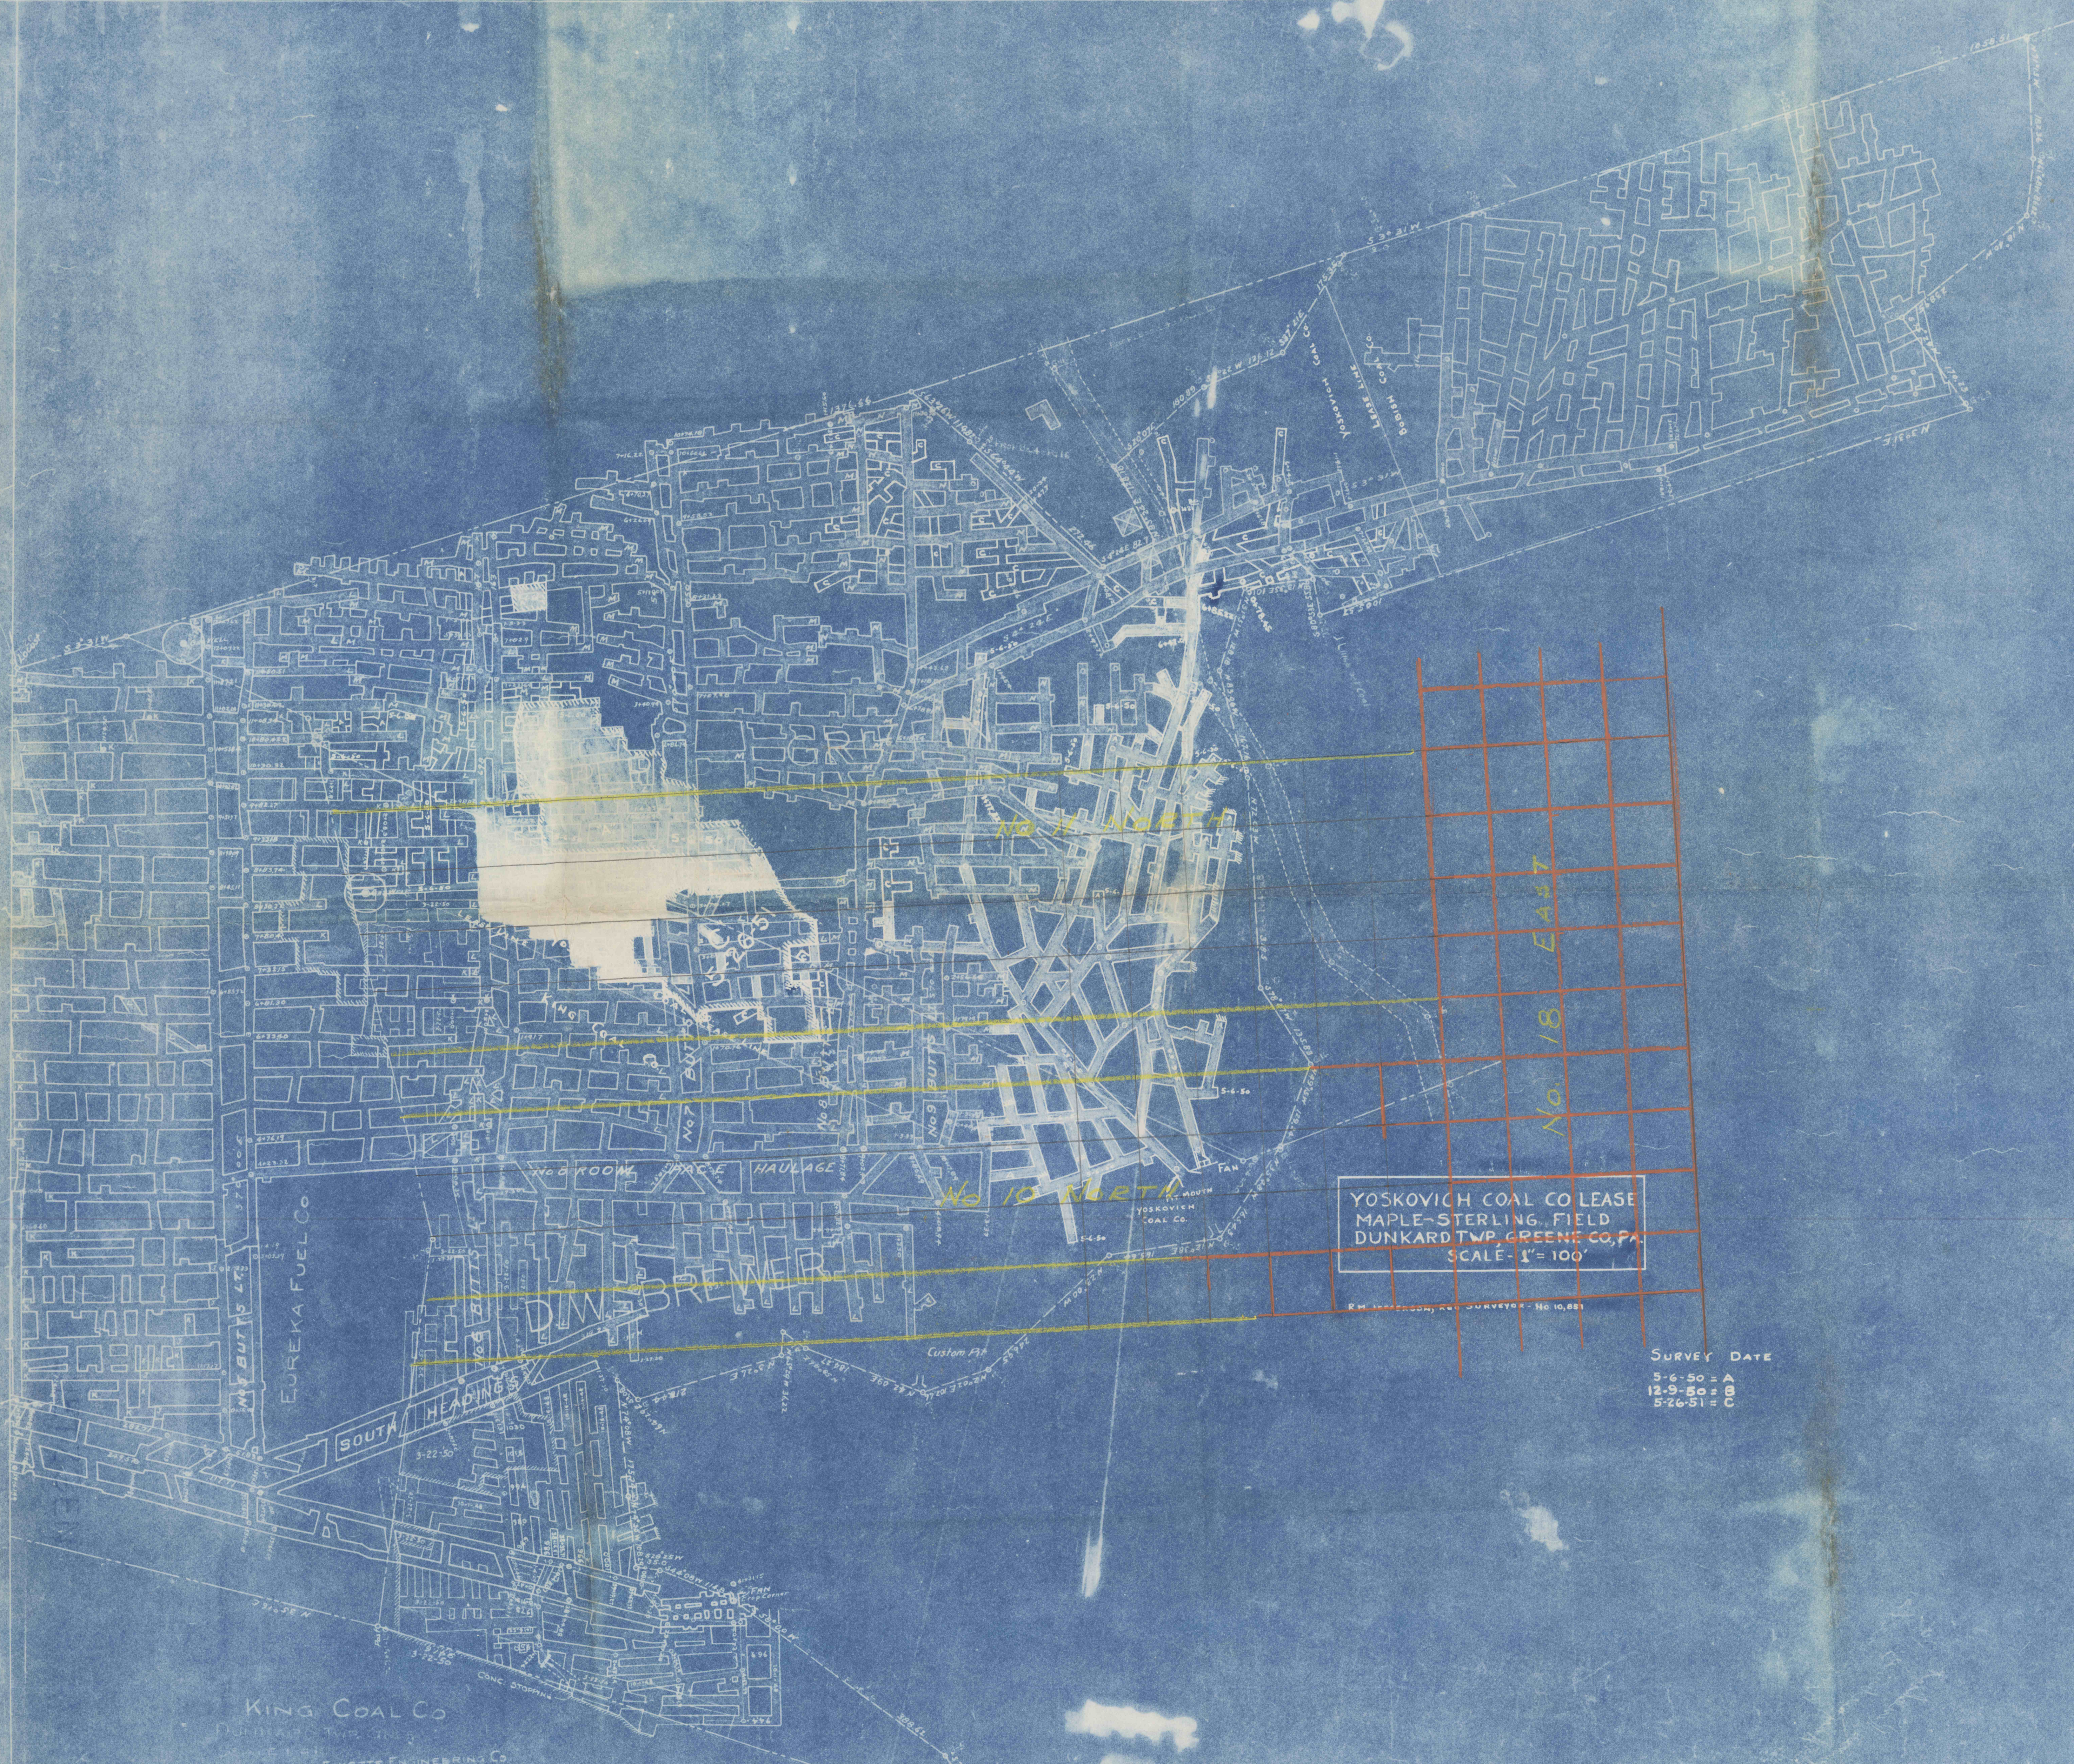

YOSKOVICH COAL CO LEASE
 MAPLE-STERLING FIELD
 DUNKARD TWP. GREENE CO., PA.
 SCALE - 1" = 100'

SURVEY DATE
 5-6-50 = A
 12-9-50 = B
 5-26-51 = C

KING COAL CO
 DUNKARD TWP. GREENE CO.
 FAYETTE ENGINEERING CO.

Maple Sterling Coal Work