


L.R. 32054

SMALL TRIBUTARY

50' BRACKER

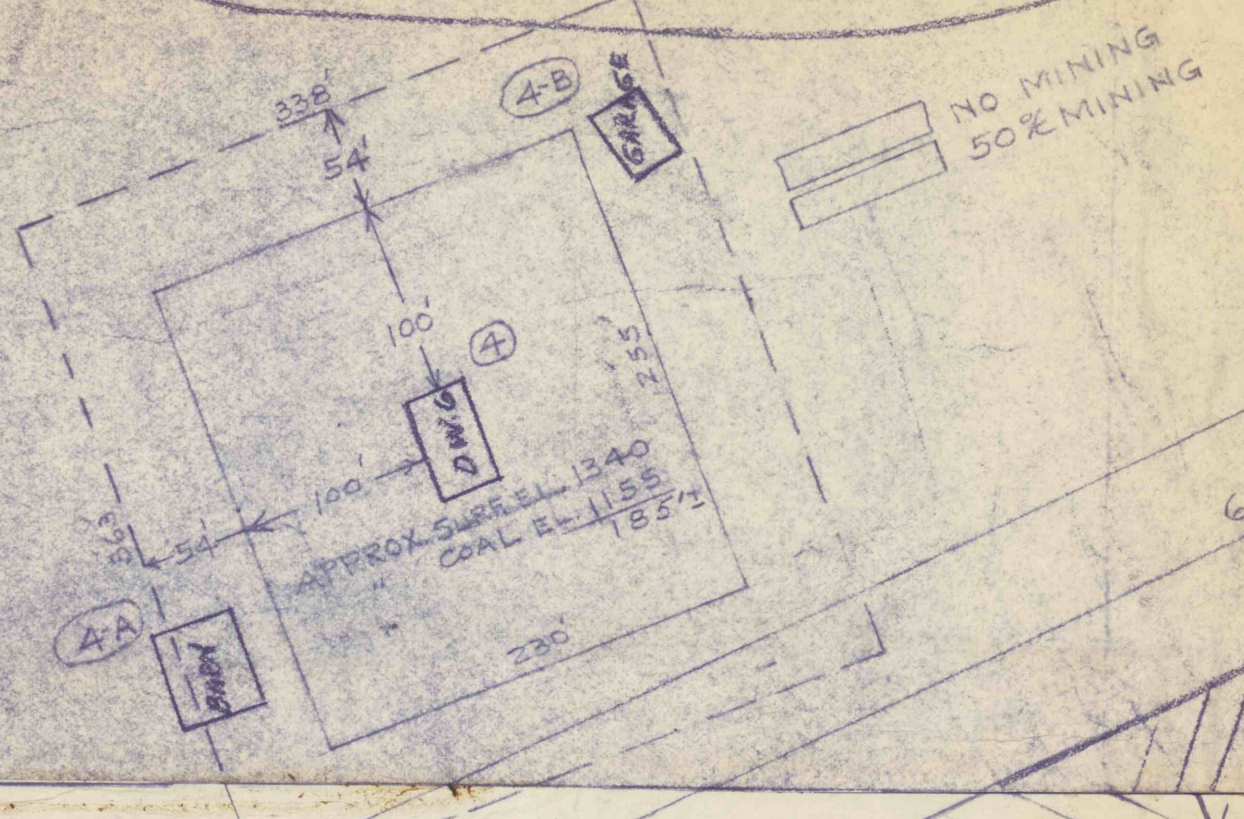


60' 0" 24' WIDE

10-25-67

5-17-68

7-16-66

RIGHT - 1700'

20' 0" 10' 0" 10' 0"

74' WIDE

JOSHUA SHANK TR.  
KENNETH SHANK SURF

MINING COMPLETED

4-25-67

J.C. FYOCK TR.  
PENNA ELECTRIC CO SURF

ANNA ALLEN TR.  
PENNA ELECTRIC CO SURF

YANITY NO. 1 MINE

CREEK

LICK


TWO

J.M. COLMAN TR.  
PA ELEC CO SURF

J.C. FYOCK TR.  
PENNA ELECTRIC CO SURF

LEGEND

- PROPOSED 6 MONTHS DEVELOPMENT
- MINED OUT AREA

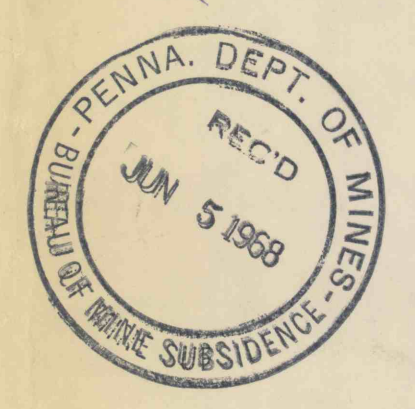

ABANDONED MINE MAP  
YANITY BROTHERS COAL COMPANY

NO. 1 MINE, "B" SEAM OPERATIC  
CHERRY HILL TWP, INDIANA CO.  
SCALE 1"=100'

DATE LAST WORKED - 5-17-68

MAP AND PROPERTY SURVEY BY JACK HARRIS  
FINAL SURVEY BY JOHN C. PASMORE

30  
81

SEAL