


SAVE STUMPS PER  
4-E-921 E.F. 8559


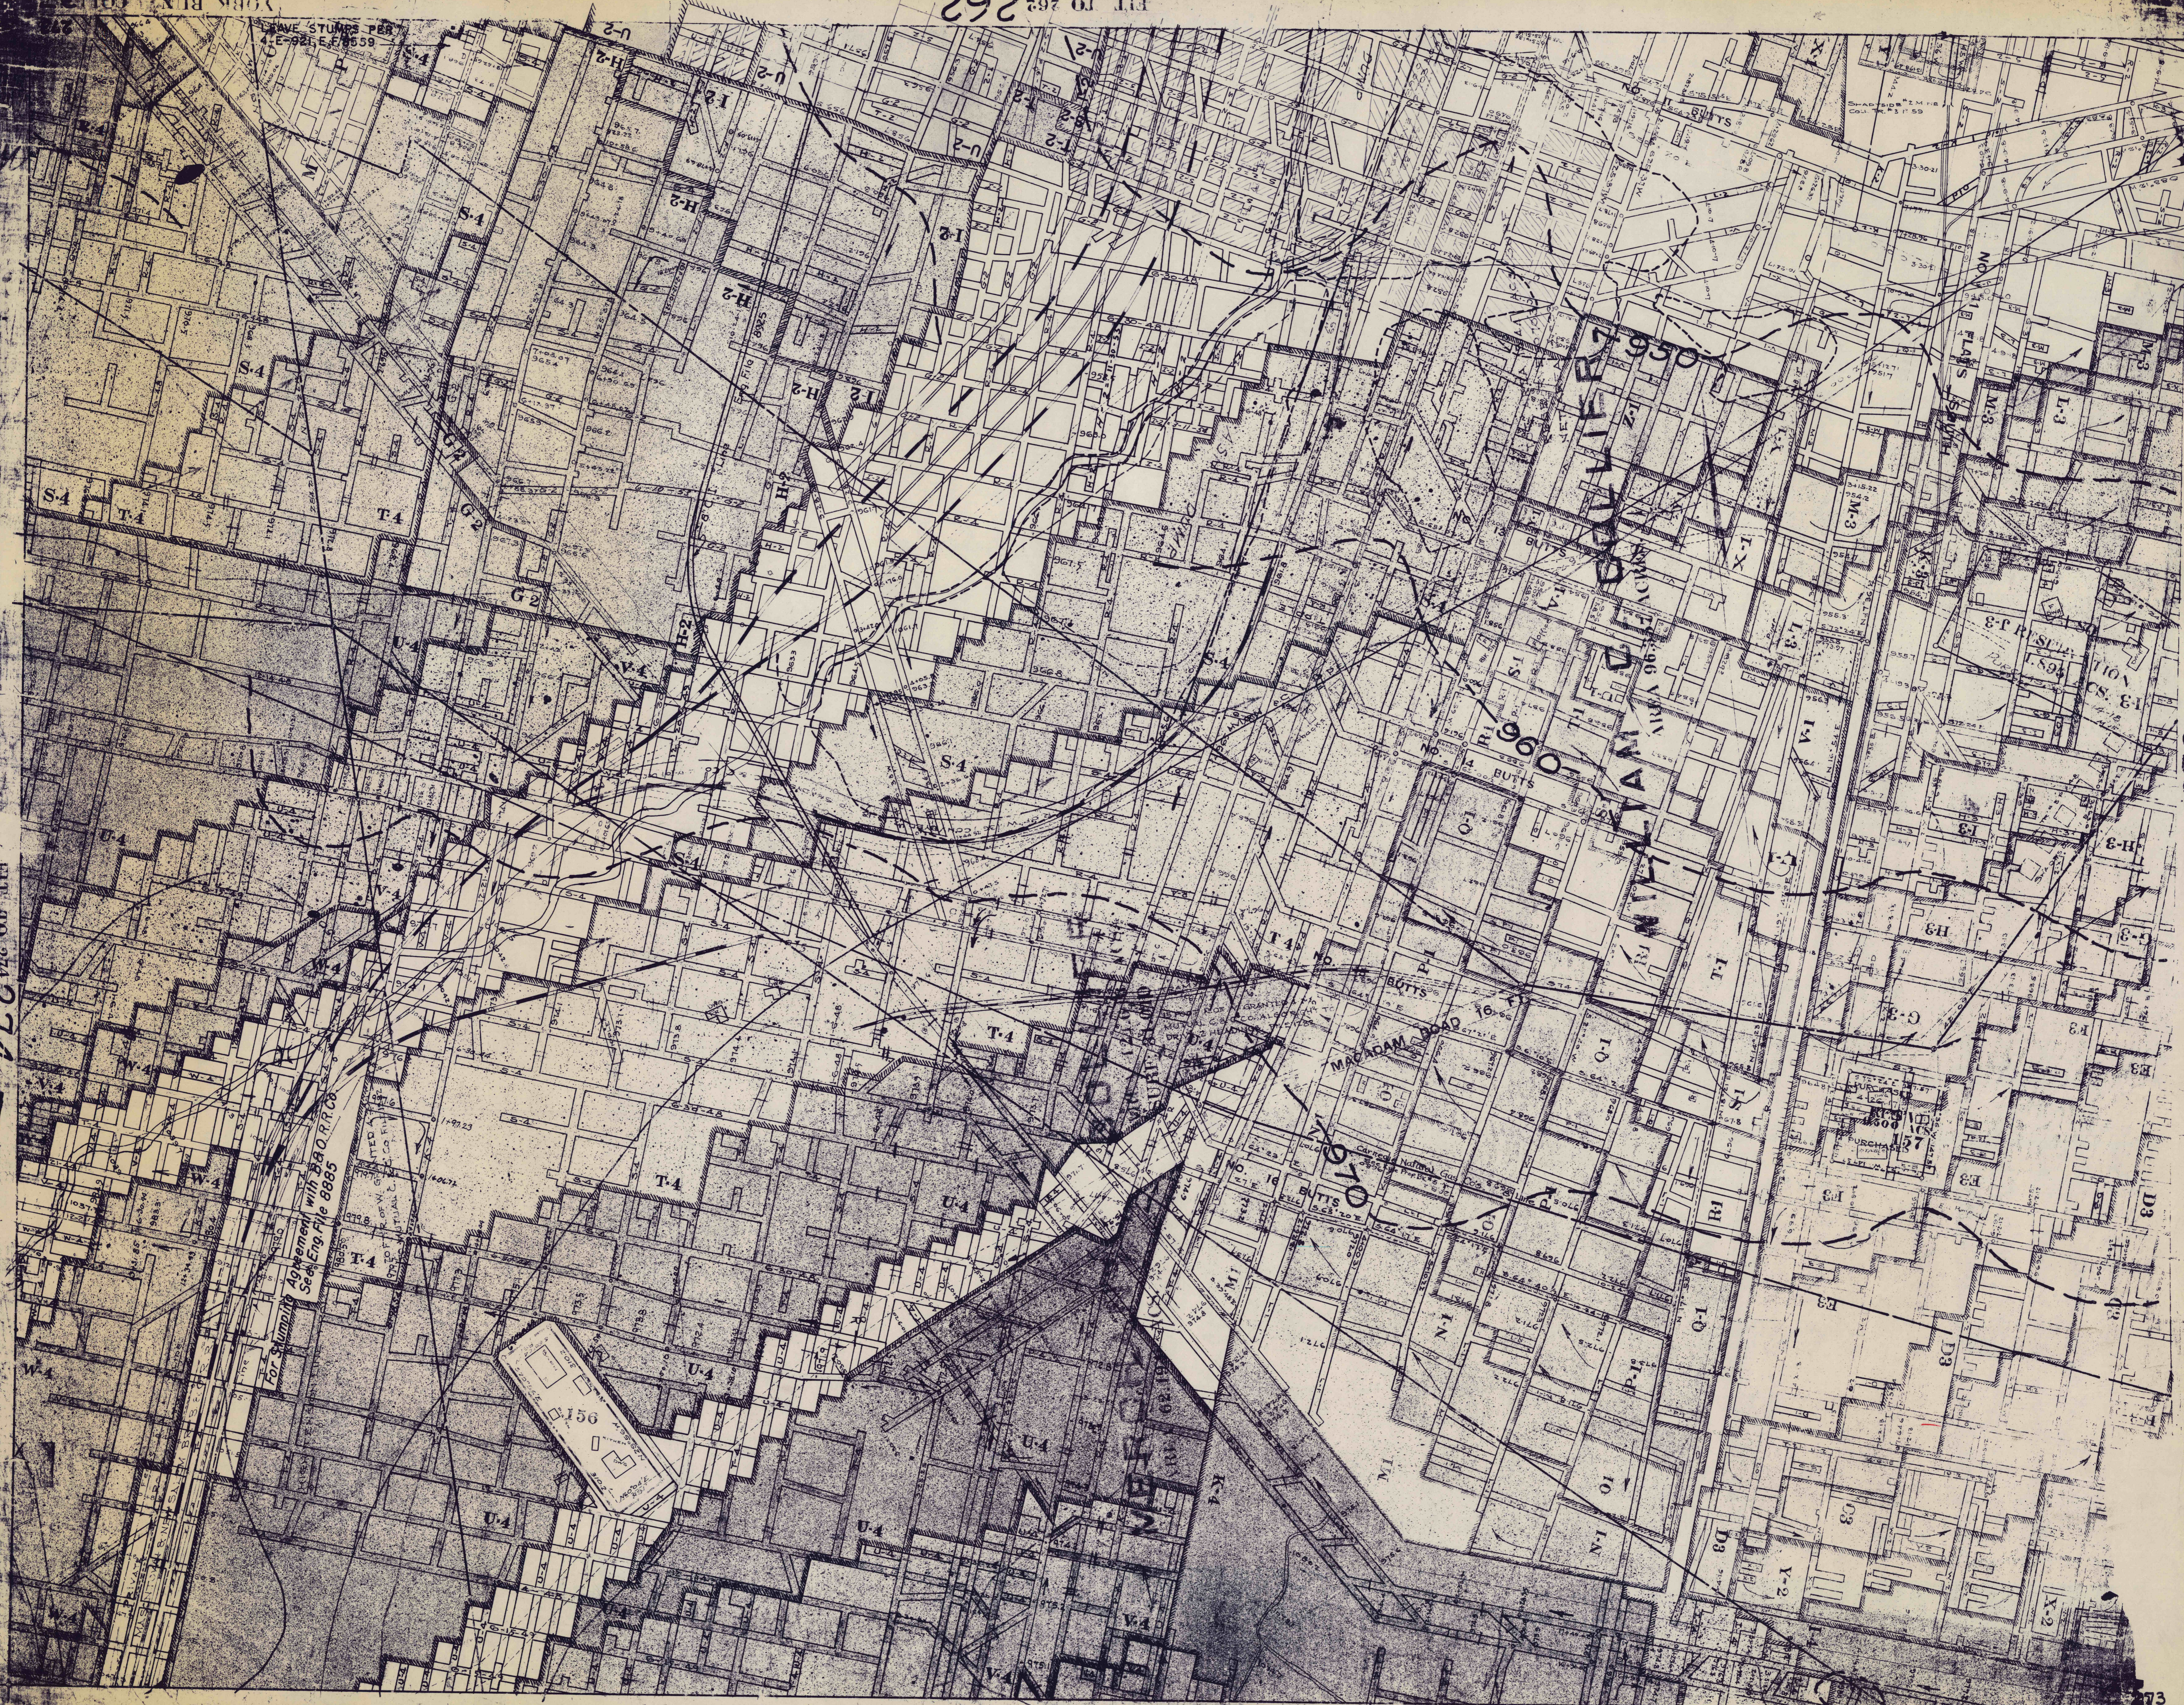

For Stumping Agreement with B&O R.R. Co. See Eng. File 8885


MADAM ROAD