



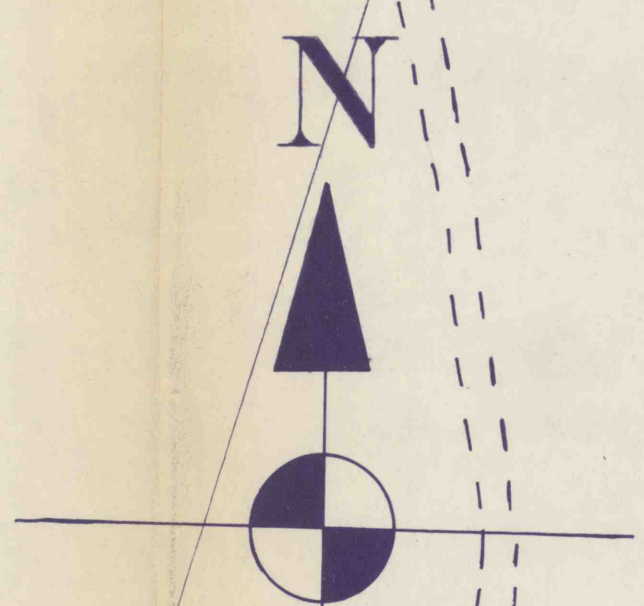


Mine Map
YOUNG No. 1-MINE
FREEDOM MINING CO., INC.
 ALLEGHENY TOWNSHIP, BUTLER COUNTY, PENNSYLVANIA
 Scale: 1"=100'

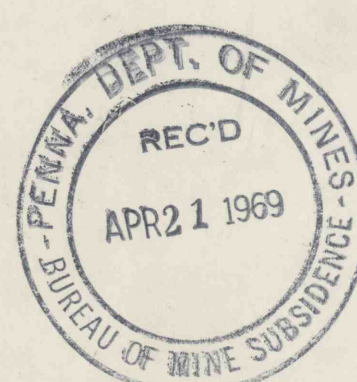

FIELD COPY

- LEGEND**
- CONTEMPLATED MINING 4/1/63 to 01/1/63
 - MINING COMPLETED AREA
 - PROTECTED STRUCTURES
 - SUPPORT AREA - NO MINING
 - 50% MINING

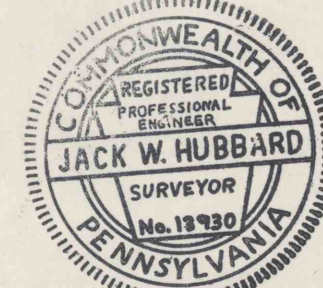

Jack W. Hubbard
 4-18-69

MATCH LINE SHEET ONE & TWO

J. MARSHALL