


Maple Sterling Coal Work

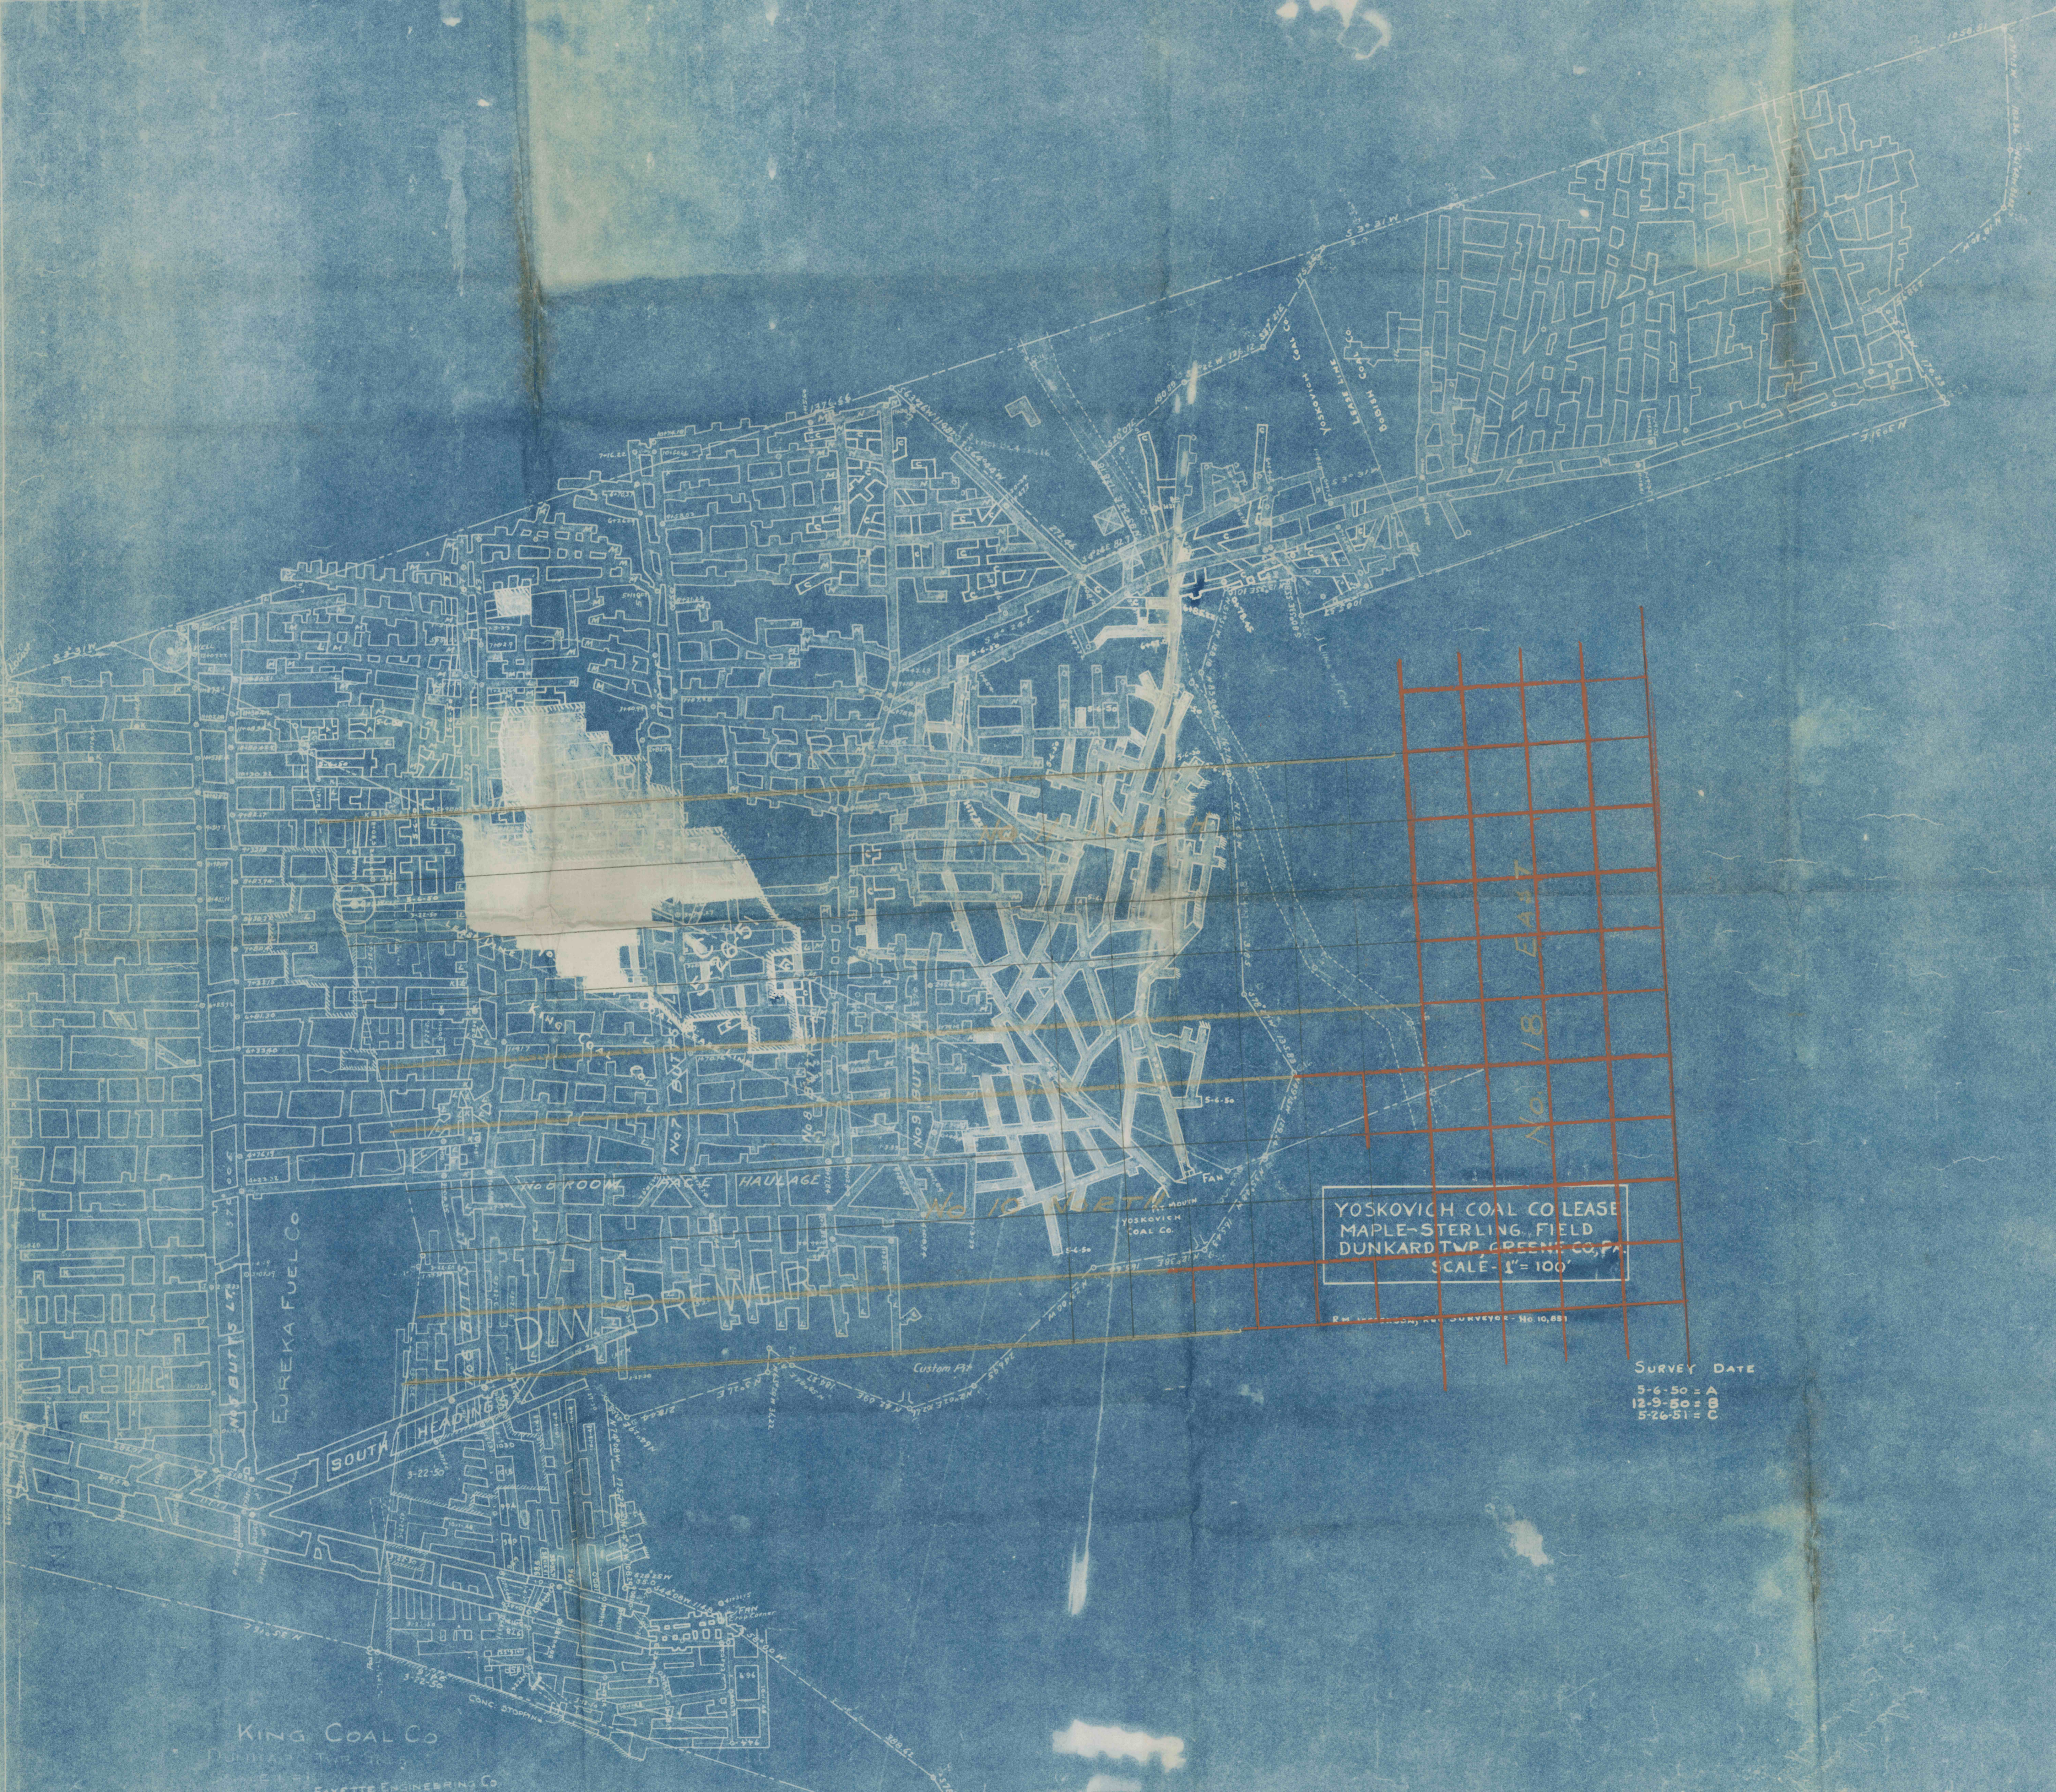

YOSKOVICH COAL CO LEASE  
 MAPLE-STERLING FIELD  
 DUNKARD TWP. GREENE CO., PA.  
 SCALE - 1" = 100'

R.M. [unclear] SURVEYOR - No. 10,881

SURVEY DATE  
 5-6-50 = A  
 12-9-50 = B  
 5-26-51 = C

KING COAL CO  
 DUNKARD TWP. GREENE CO., PA.  
 FAYETTE ENGINEERING CO.

Maple Sterling Coal Work