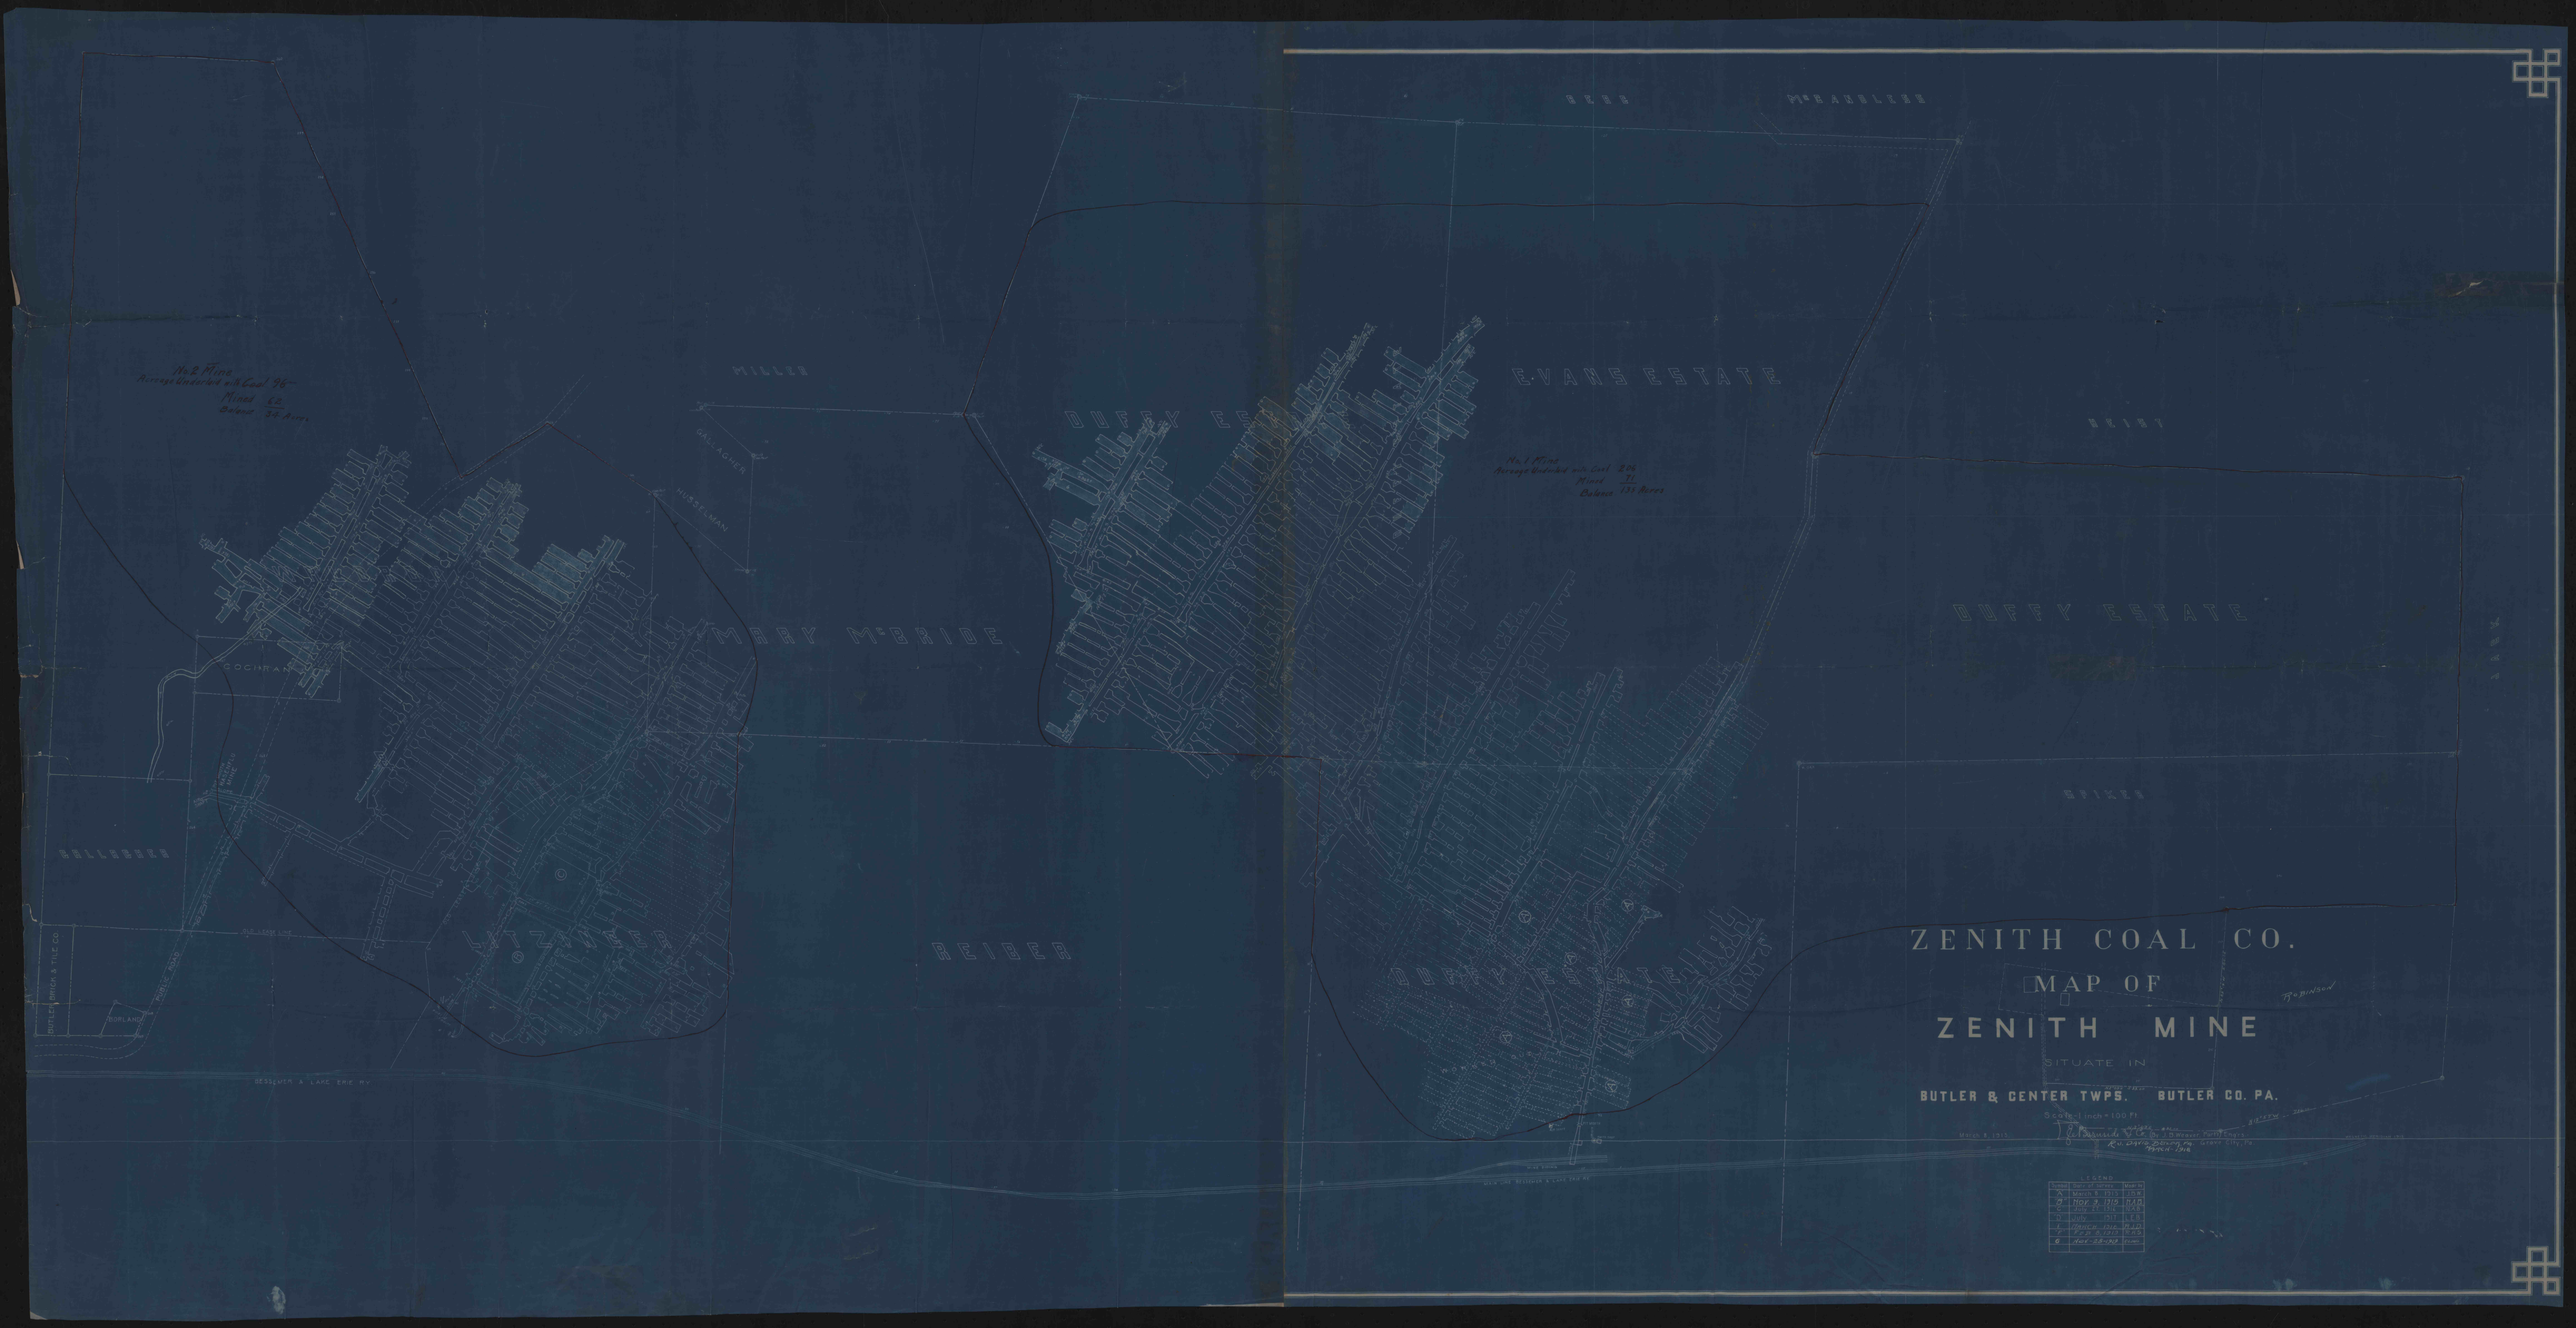
MILLER
GALLAGHER
HUSSELMAN
MARY McBRIDE
COCHRAN
REIBER
BELLSBURG
BUTLER WATER & TILE CO.
PUBLIC ROAD
WORLAND
BESSEMER & LAKE ERIE RY.
EVANS ESTATE
DUFFY ESTATE
McCANDLESS
ZENITH COAL CO.
MAP OF
ZENITH MINE
SITUATE IN
BUTLER & CENTER TWPS. BUTLER CO. PA.
Scale 1 Inch = 100 Ft.
March 8, 1913.
Surveyed by W. C. & D. Dawson, Civil Engrs.
Ex. Duffy Bldg. Pa. Grove City Pa.
March 1913
RECORD
No. 1 Mine
Acreage Undermined with Coal 96
Mined 62
Balance 34 Acres
No. 2 Mine
Acreage Undermined with Coal 326
Mined 71
Balance 131 Acres