


PROPERTY MAP  
OF  
**ZETH COAL CO.**  
IN BROAD TOP TOWNSHIP, BEDFORD CO., PENNA.

SCALE: 1" = 100'

W.A. SILLIMAN  
ENGINEER  
ALTOONA, PA.

1946

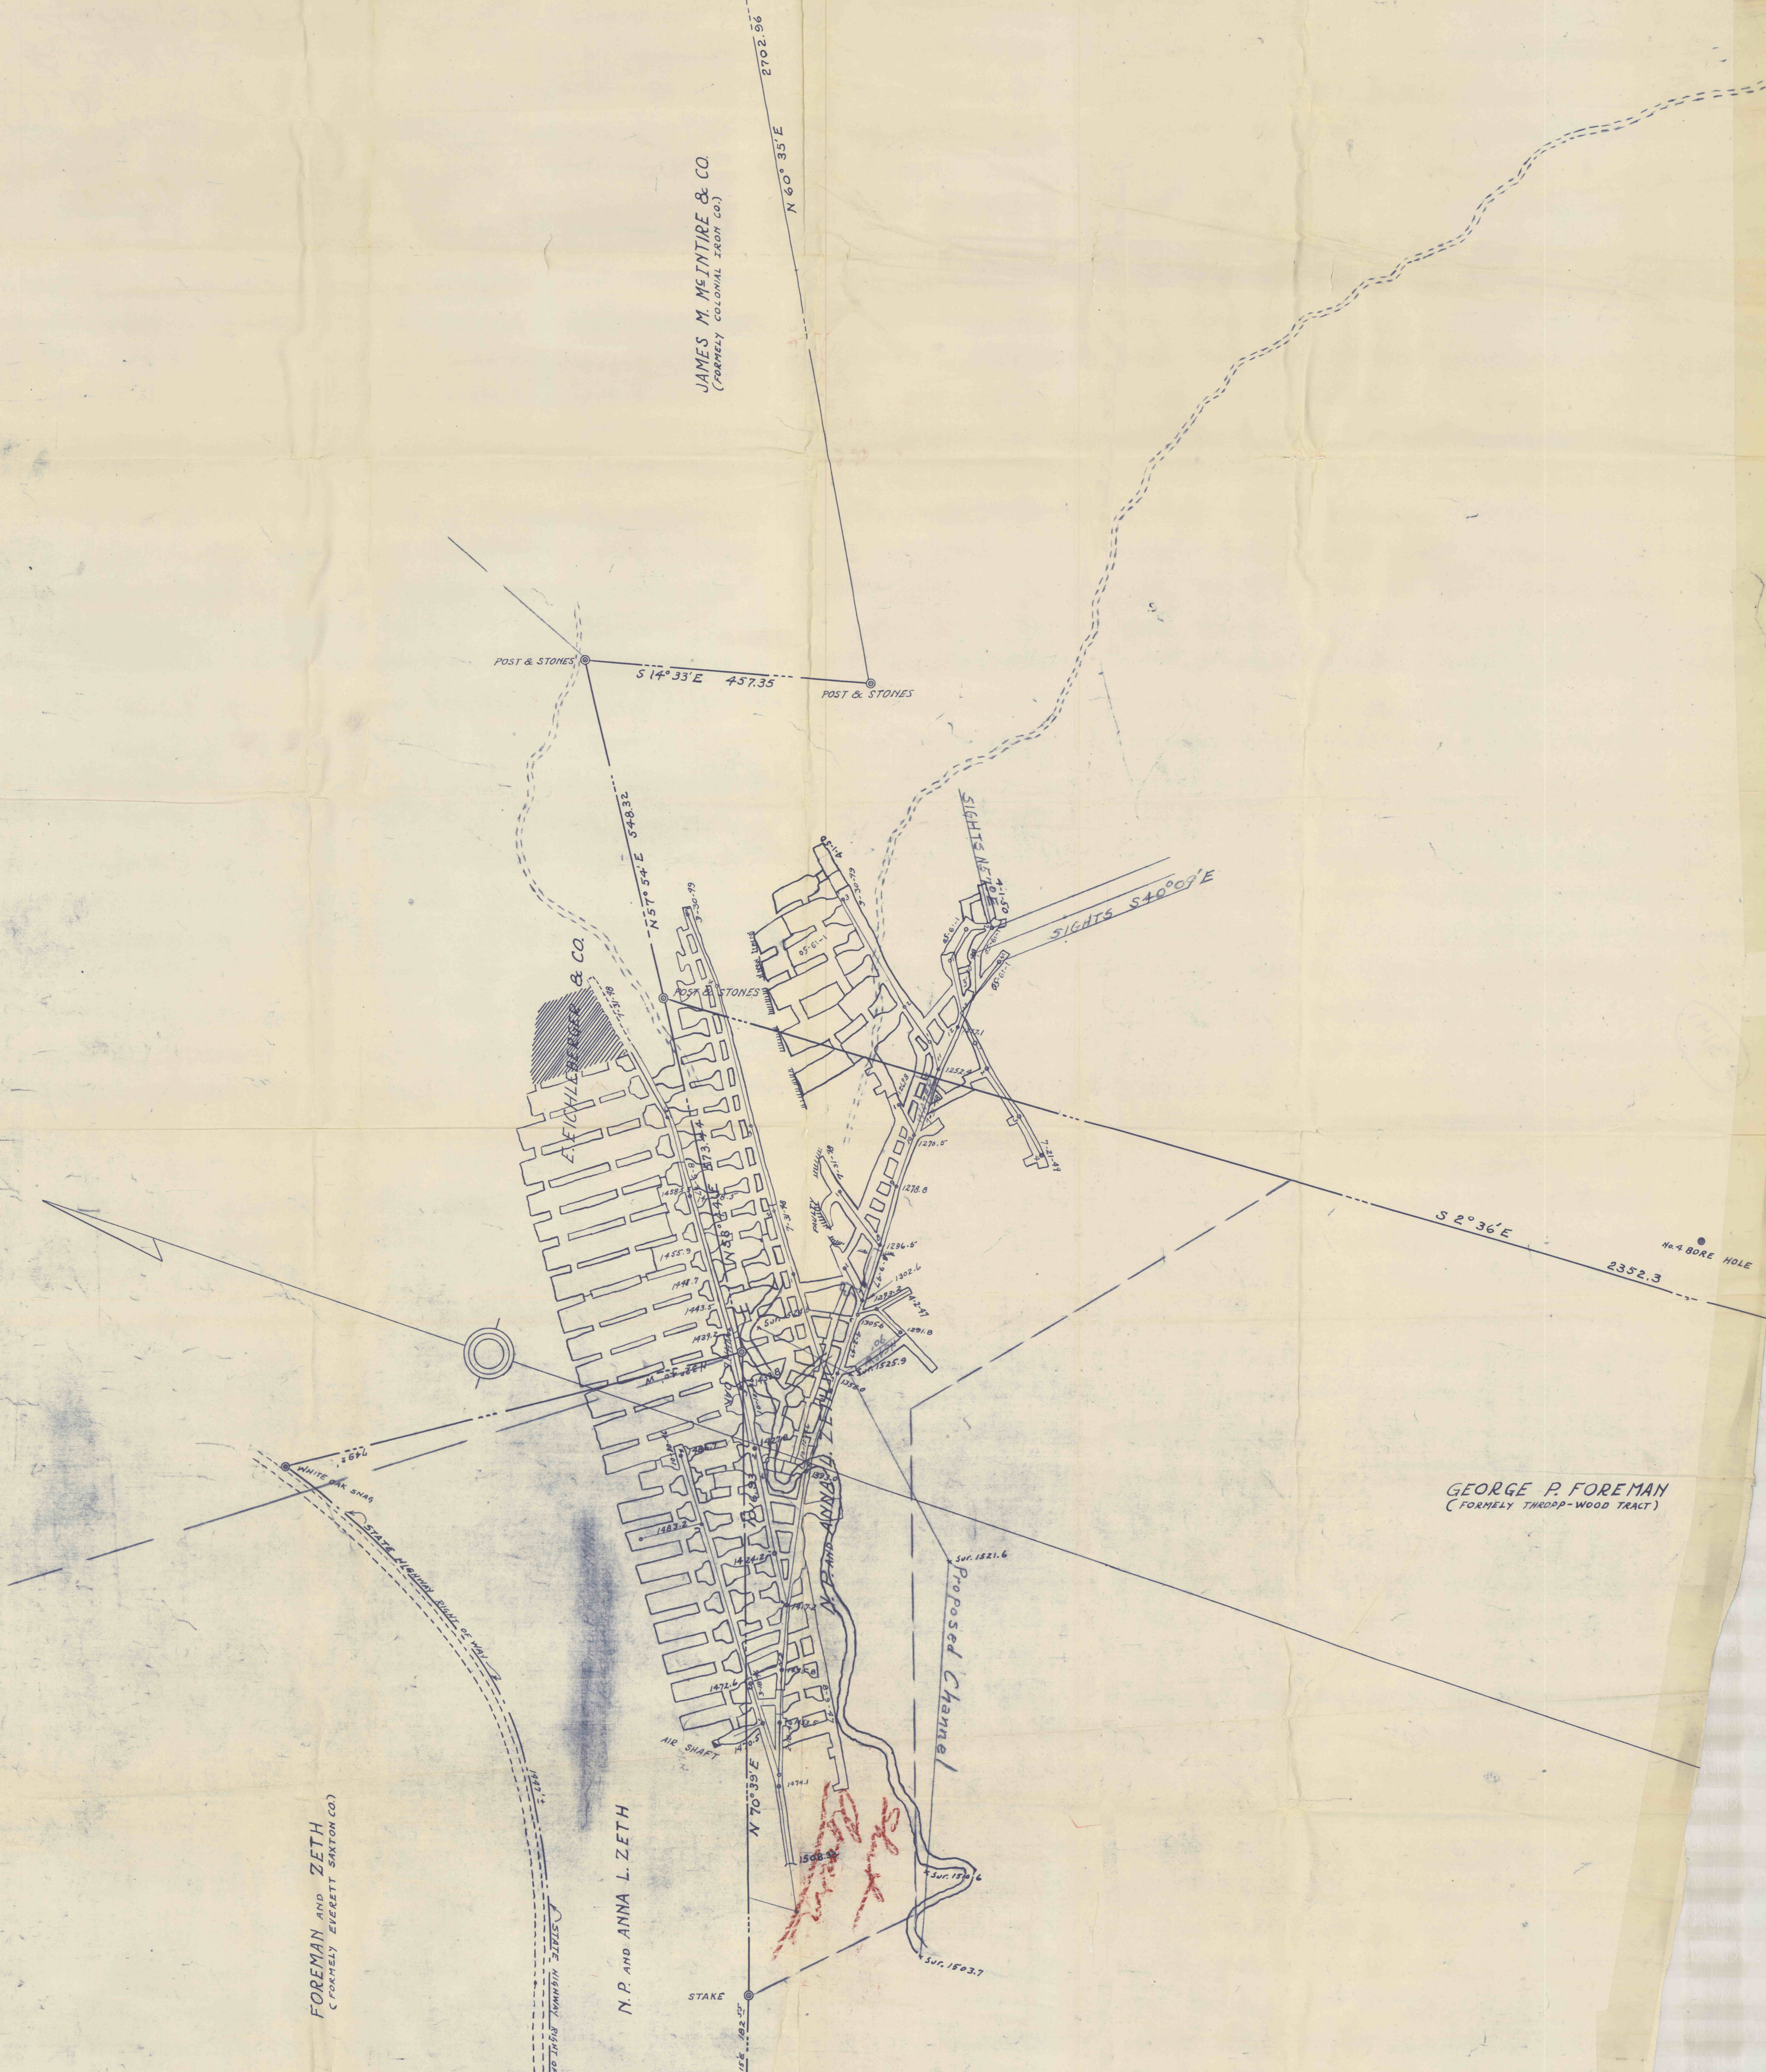

GEORGE P. FOREMAN  
(FORMERLY THROOP-WOOD TRACT)

FOREMAN AND ZETH  
(FORMERLY EVERETT SEXTON CO.)

M.P. AND ANNA L. ZETH