



Dunkard Mining Co. Mine No. 2
Location Based on Map Provided by Others

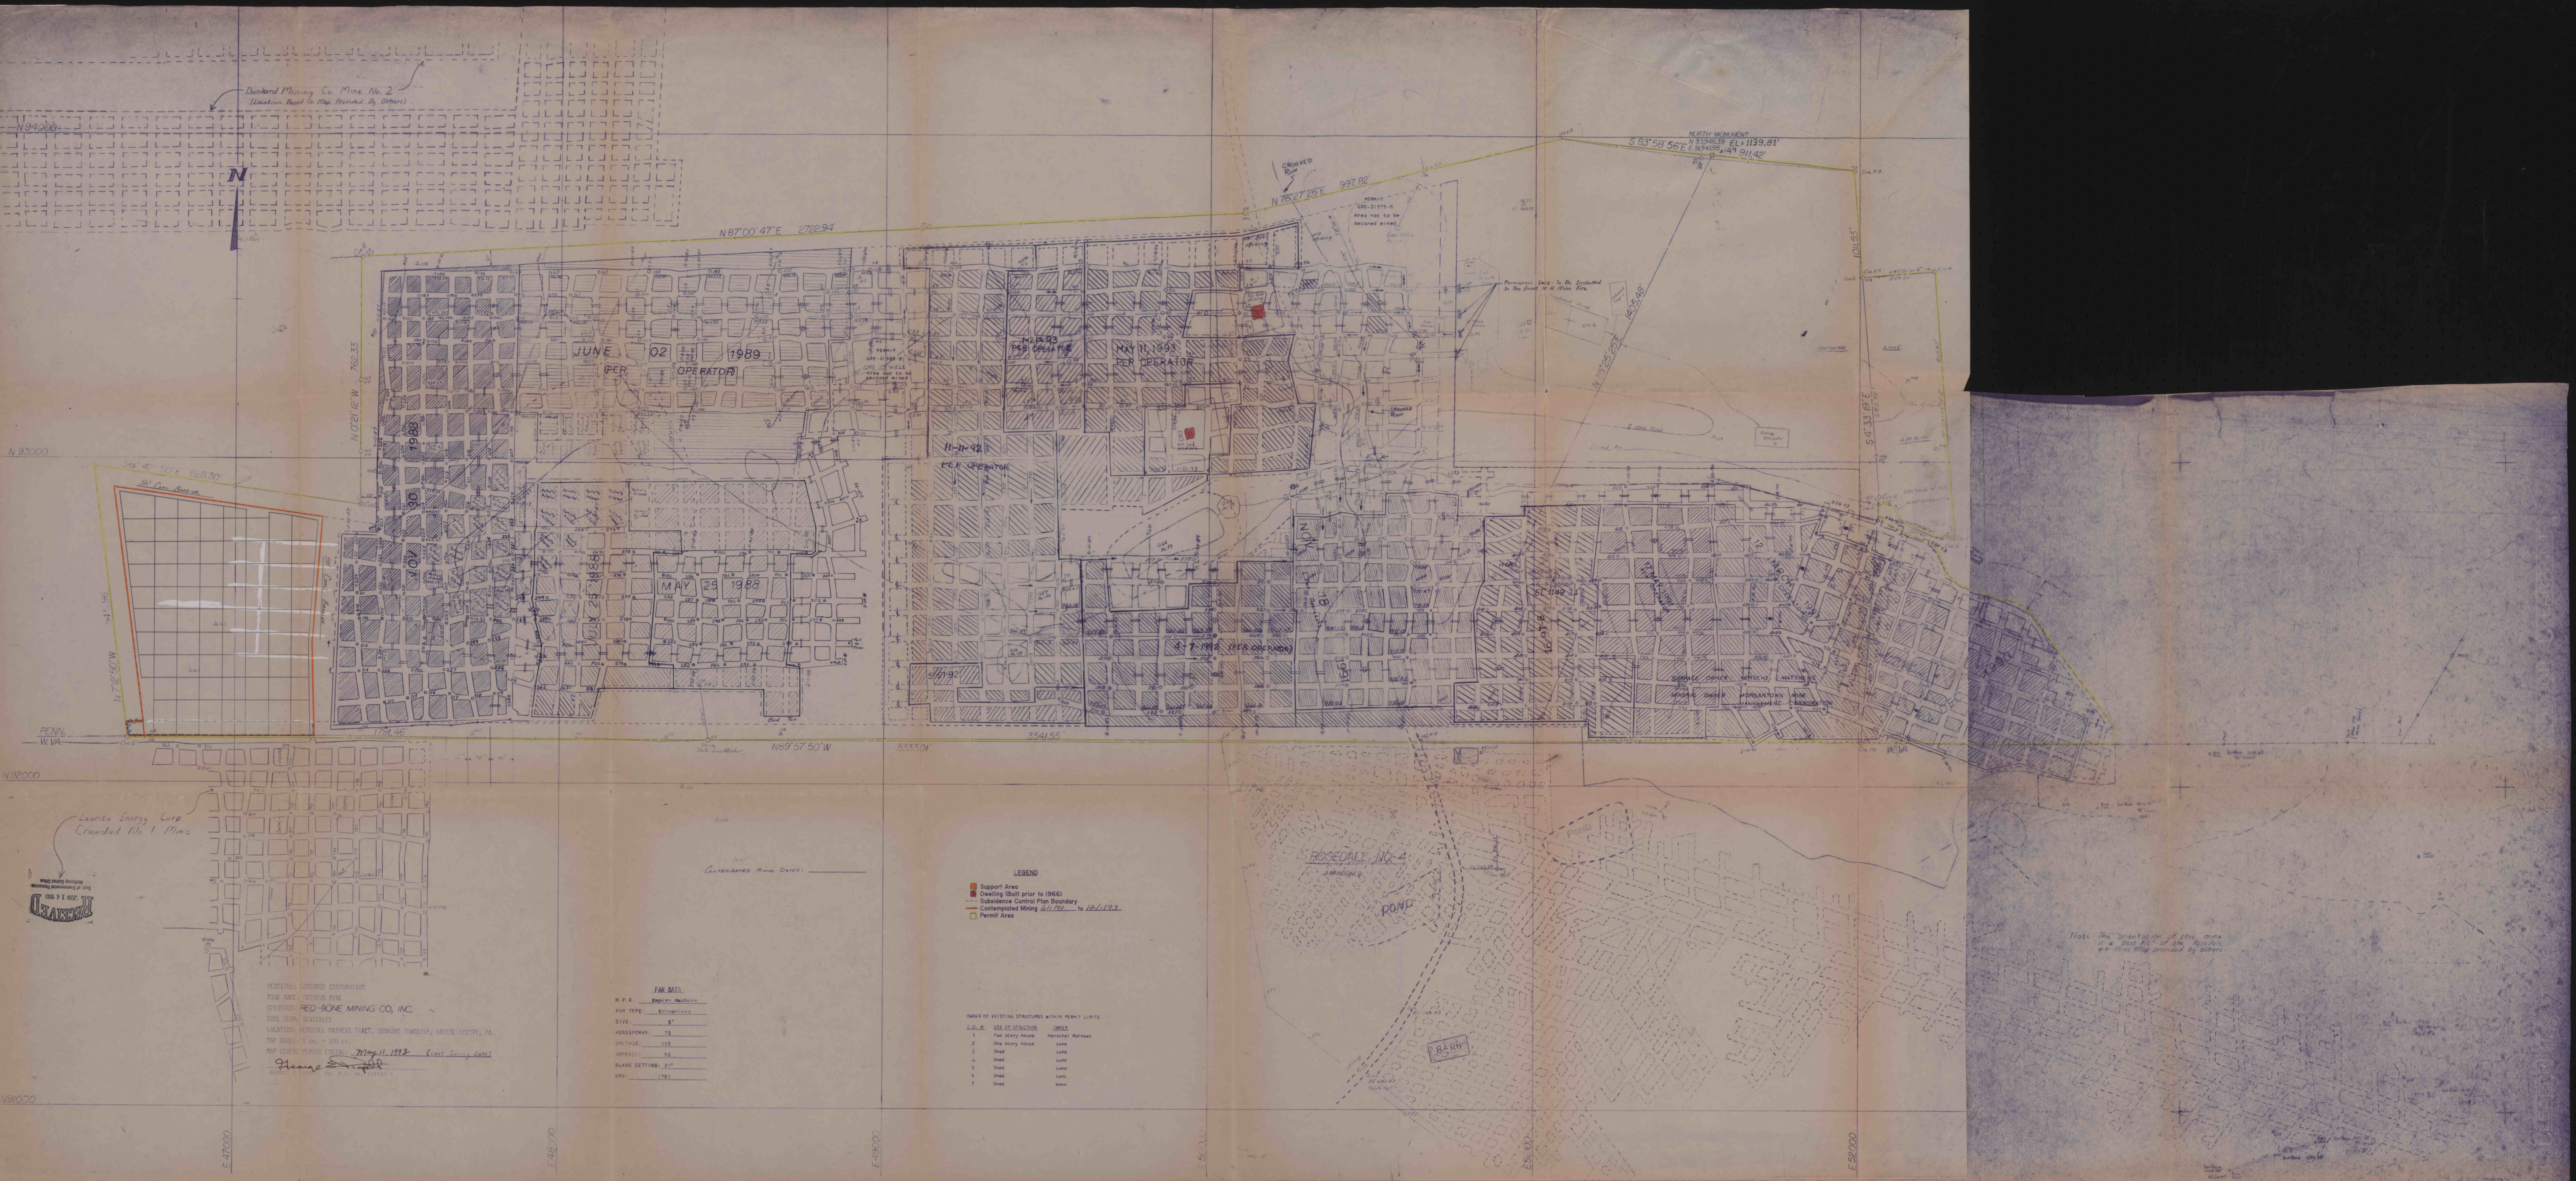

Laura Energy Corp
Crowdell No. 1 Mine

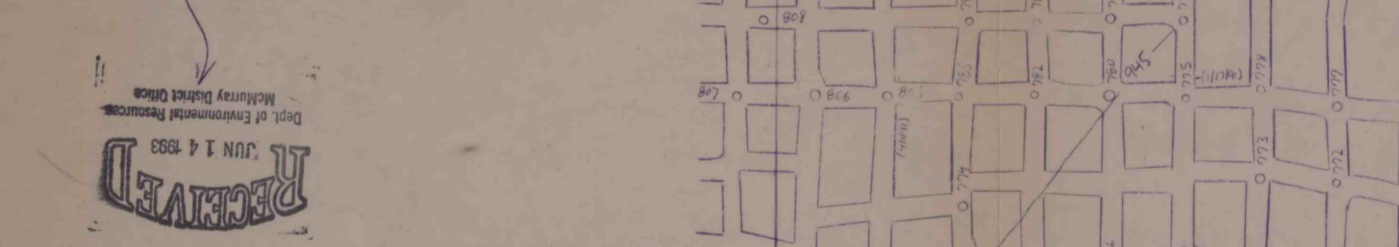

PERMITTEE: SUCONEX CORPORATION
MINE NAME: PATHEUS MINE
OPERATOR: RED-BONE MINING CO., INC.
COAL SEAM: SEVENLEY
LOCATION: HERSCHEL PATHEUS TRACT, DUNKARD TOWNSHIP, GREENE COUNTY, PA.
POP SCALE: 1" = 100' ±
POP COVERED PERIOD: May 11, 1987 (Last Survey Date)
Heane

FAN DATA

M.P.#	100171
FAN TYPE	ECHEMATIC
SIZE	5'
HORNSPOWER	75
VOLTAGE	60
AMPERES	52
BLADE SETTING	32"
RPM	1265

- LEGEND
- Support Area
 - Dwelling (Built prior to 1966)
 - Subsidence Control Plan Boundary
 - Contemplated Mining 12/1/88 to 12/1/97
 - Permit Area

OWNER OF EXISTING STRUCTURES WITHIN PERMIT LIMITS

NO.	USE OF STRUCTURE	DATES
1	Two story house	HERSCHEL PATHEUS
2	One story house	same
3	Shed	same
4	Shed	same
5	Shed	same
6	Shed	same
7	Shed	same

Note: The location of this mine is a best fit of the available map data provided by others.