



LEGEND

PROP LINE

MINED AFTER APRIL 27, 1966


PROPOSED MINING 6 MONTH PERIOD

PERIOD ENDING July 25, 1967

SURFACE STRUCTURES

AREA TO BE STUMPED

SCALE 1" = 100'

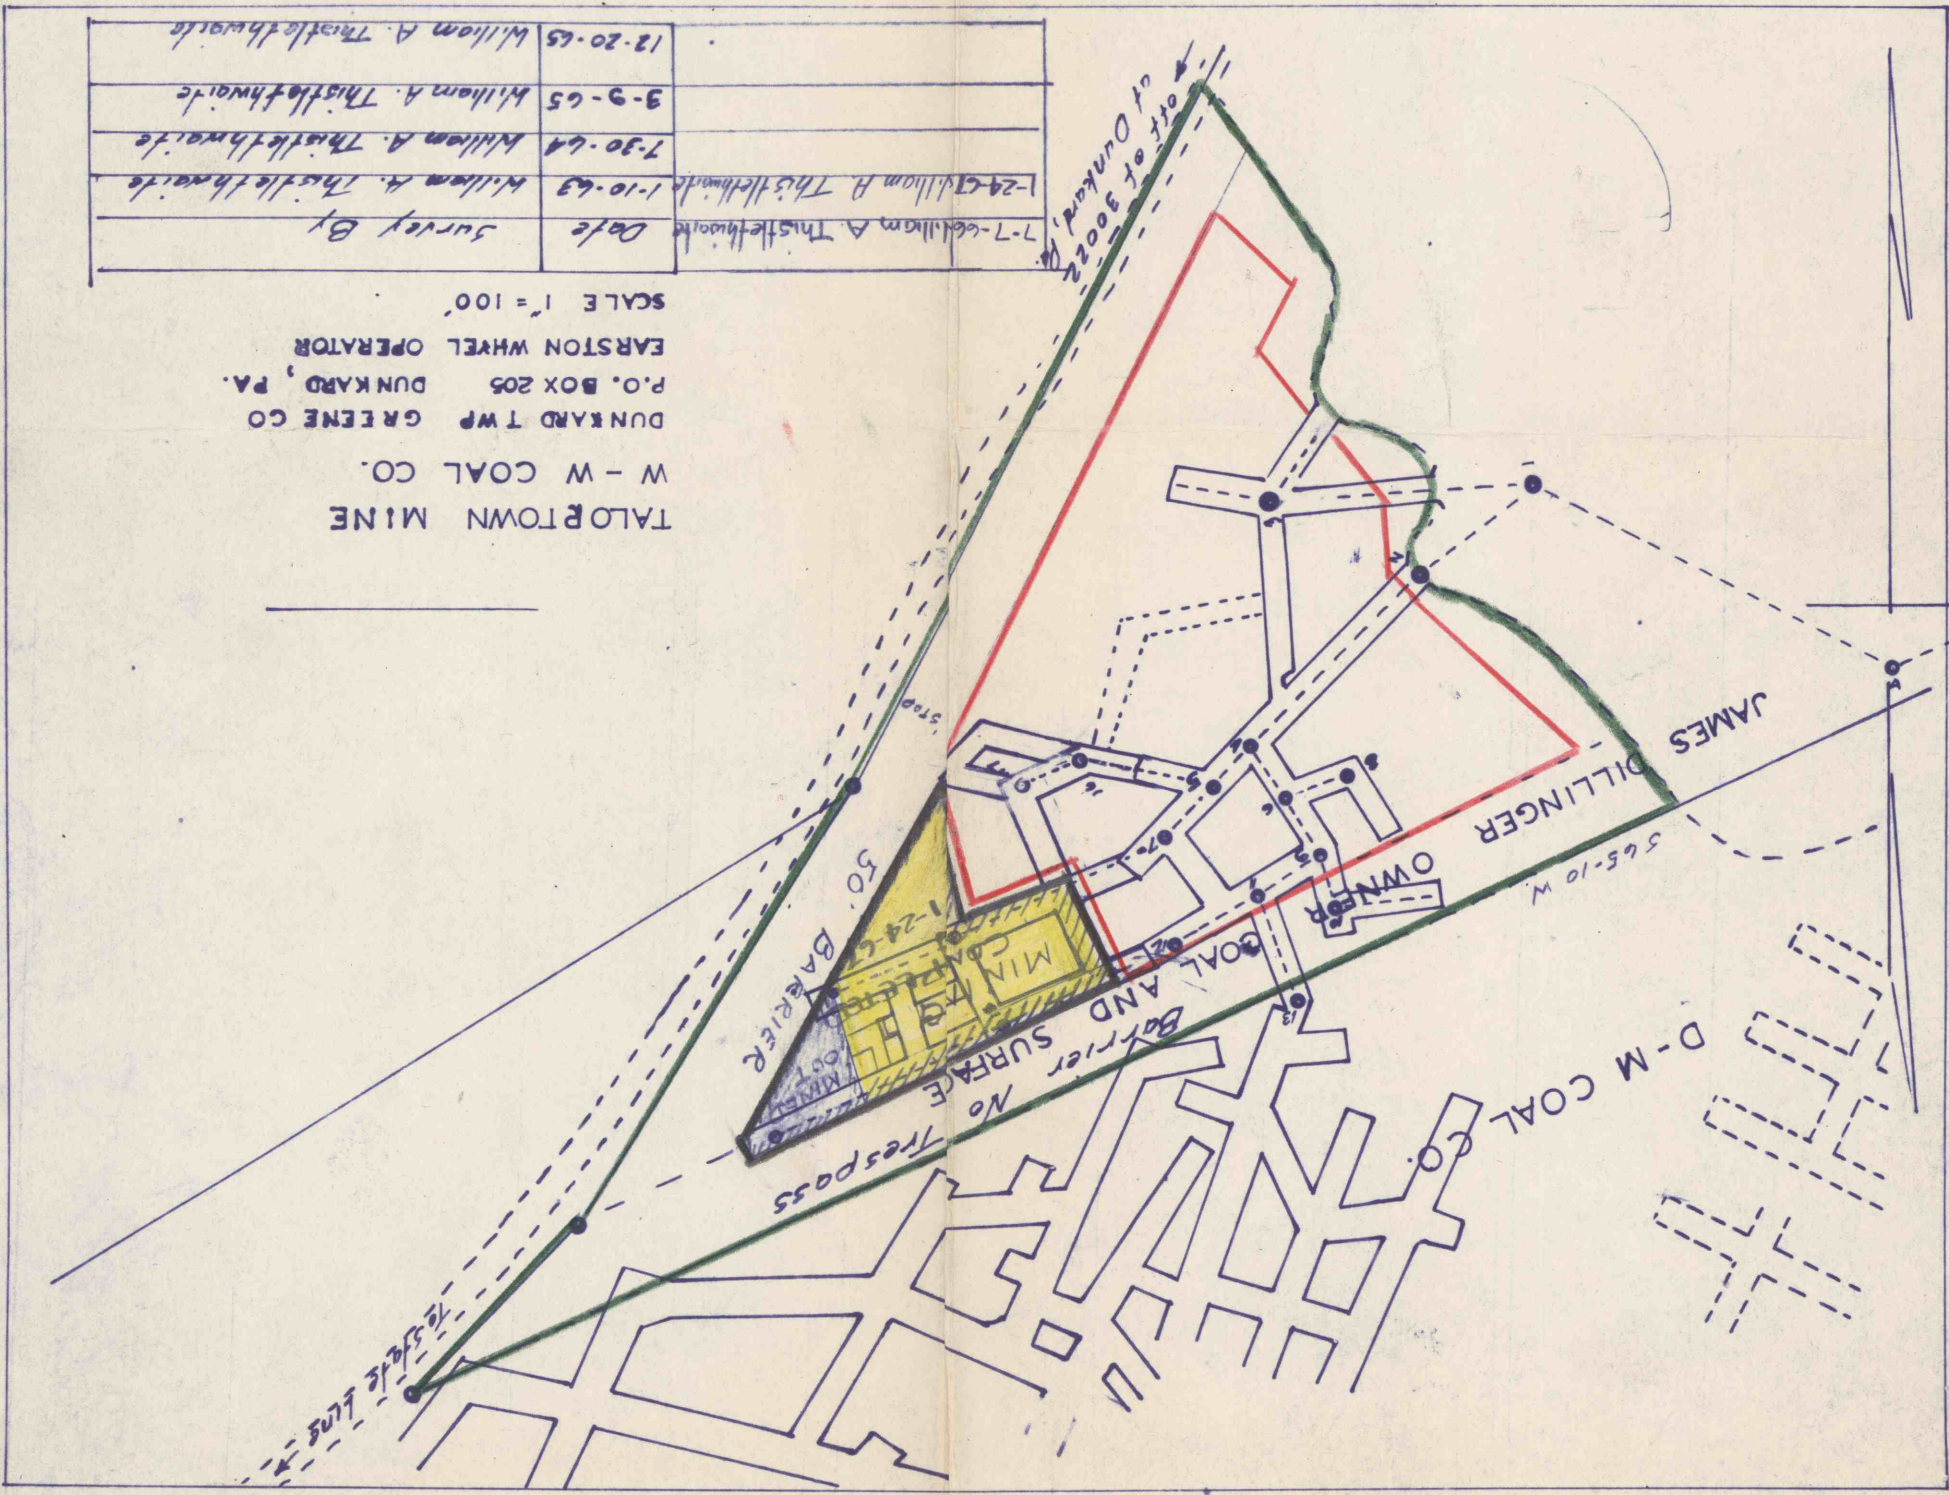

Date	Survey By
7-7-66	William A. Thistlethwaite
1-24-67	William A. Thistlethwaite
1-10-63	William A. Thistlethwaite
7-30-64	William A. Thistlethwaite
3-9-65	William A. Thistlethwaite
12-20-65	William A. Thistlethwaite

TALOP TOWN MINE
 W - W COAL CO.
 DUNKARD TWP GREENE CO
 P.O. BOX 205 DUNKARD, PA.
 EARSTON WHEEL OPERATOR
 SCALE 1" = 100'