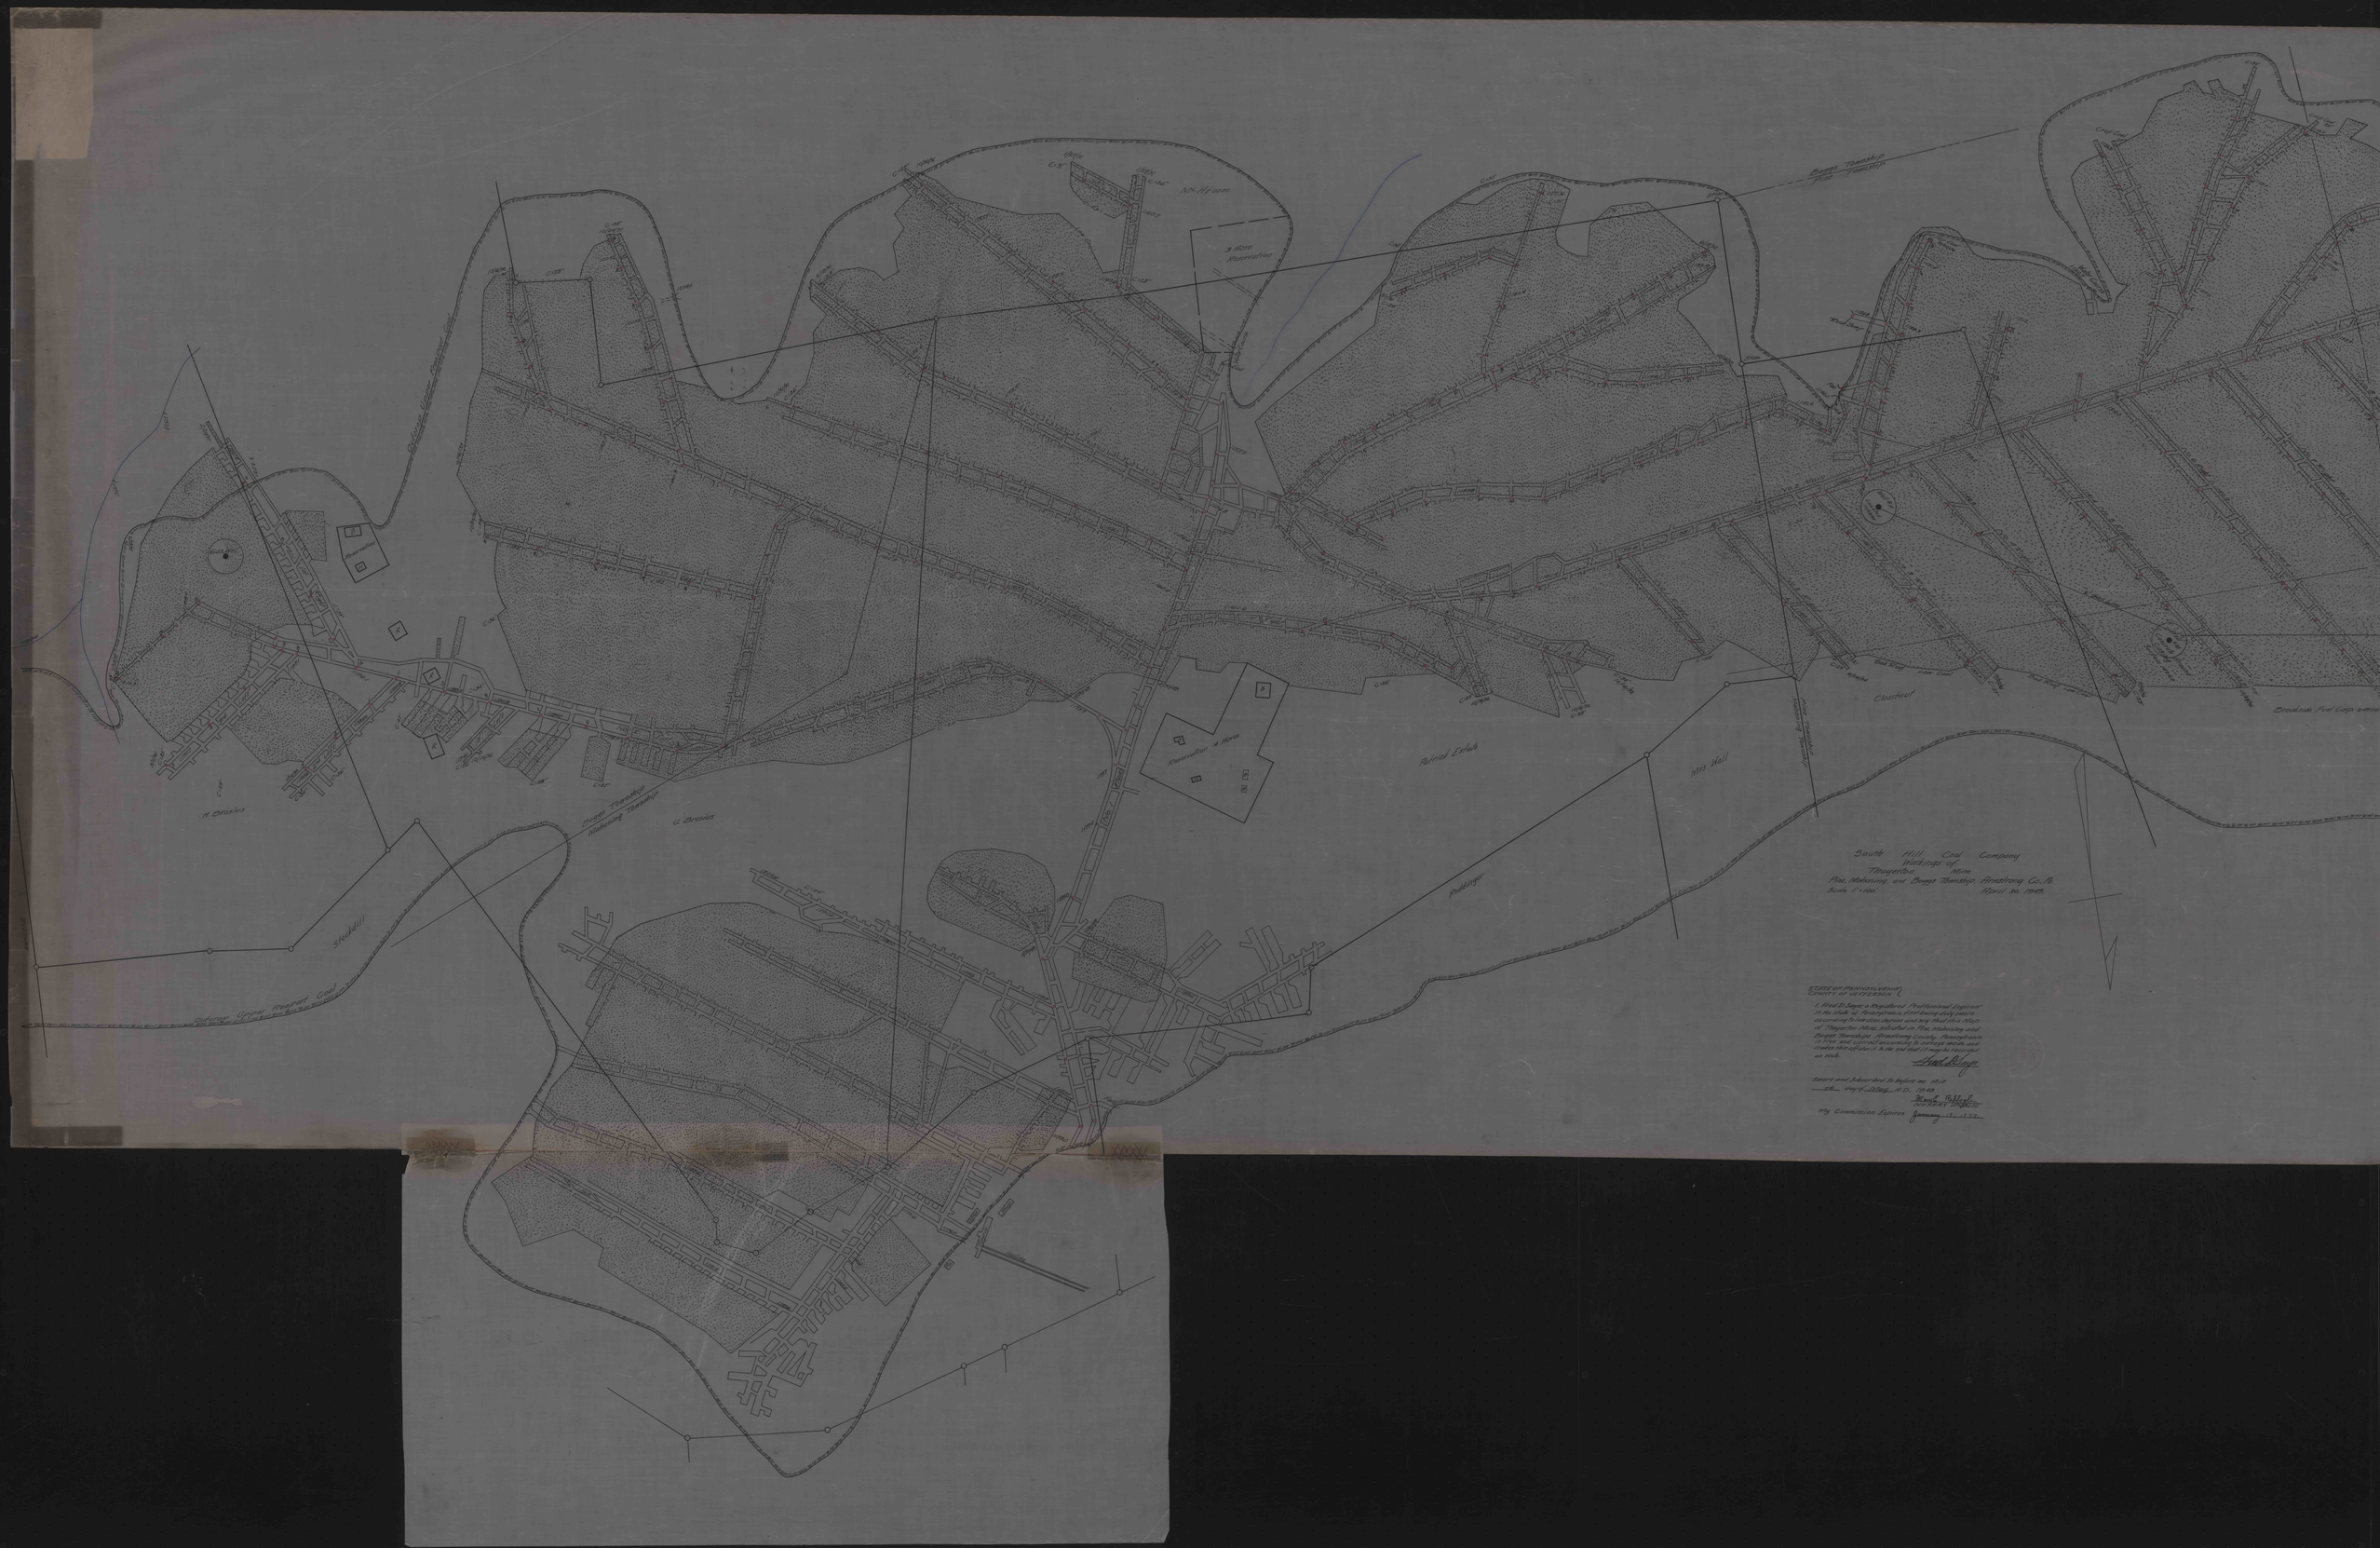
Pittsburgh Upper Freeport Coal Co.
Mt. Hope
3 Mile Reservoir
Boggs Township
Pittsburgh Upper Freeport Coal Co.
Shadehill
A. Brosius
C. Brosius
Reservoir 4 Mile
Pelrod Estate
Mts Hall
Cherrywood
Brookside Fuel Corp.
Railroad
South Hill Coal Company
Workings of
Rox, Mahoning, and Boggs Township, Armstrong Co. Pa.
Scale 1" = 100'
April 30, 1948.
STATE OF PENNSYLVANIA
COUNTY OF JEFFERSON
I, Fred D. Sage a Registered Professional Engineer in the state of Pennsylvania, do hereby depose according to law, this deposition and say that this Map of Thorpe Mine situated in the Township and Boggs Township, Armstrong County, Pennsylvania is true and correct according to surveys made and under this office, I to the best that I may be know and so both.
Sworn and Subscribed to before me this
day of May A.D. 1948
My Commission Expires January