


J. WAKEFIELD

D. WOODS

J. WAKEFIELD

GARFIELD REFRACTORIES CO.

T.S. LYNN

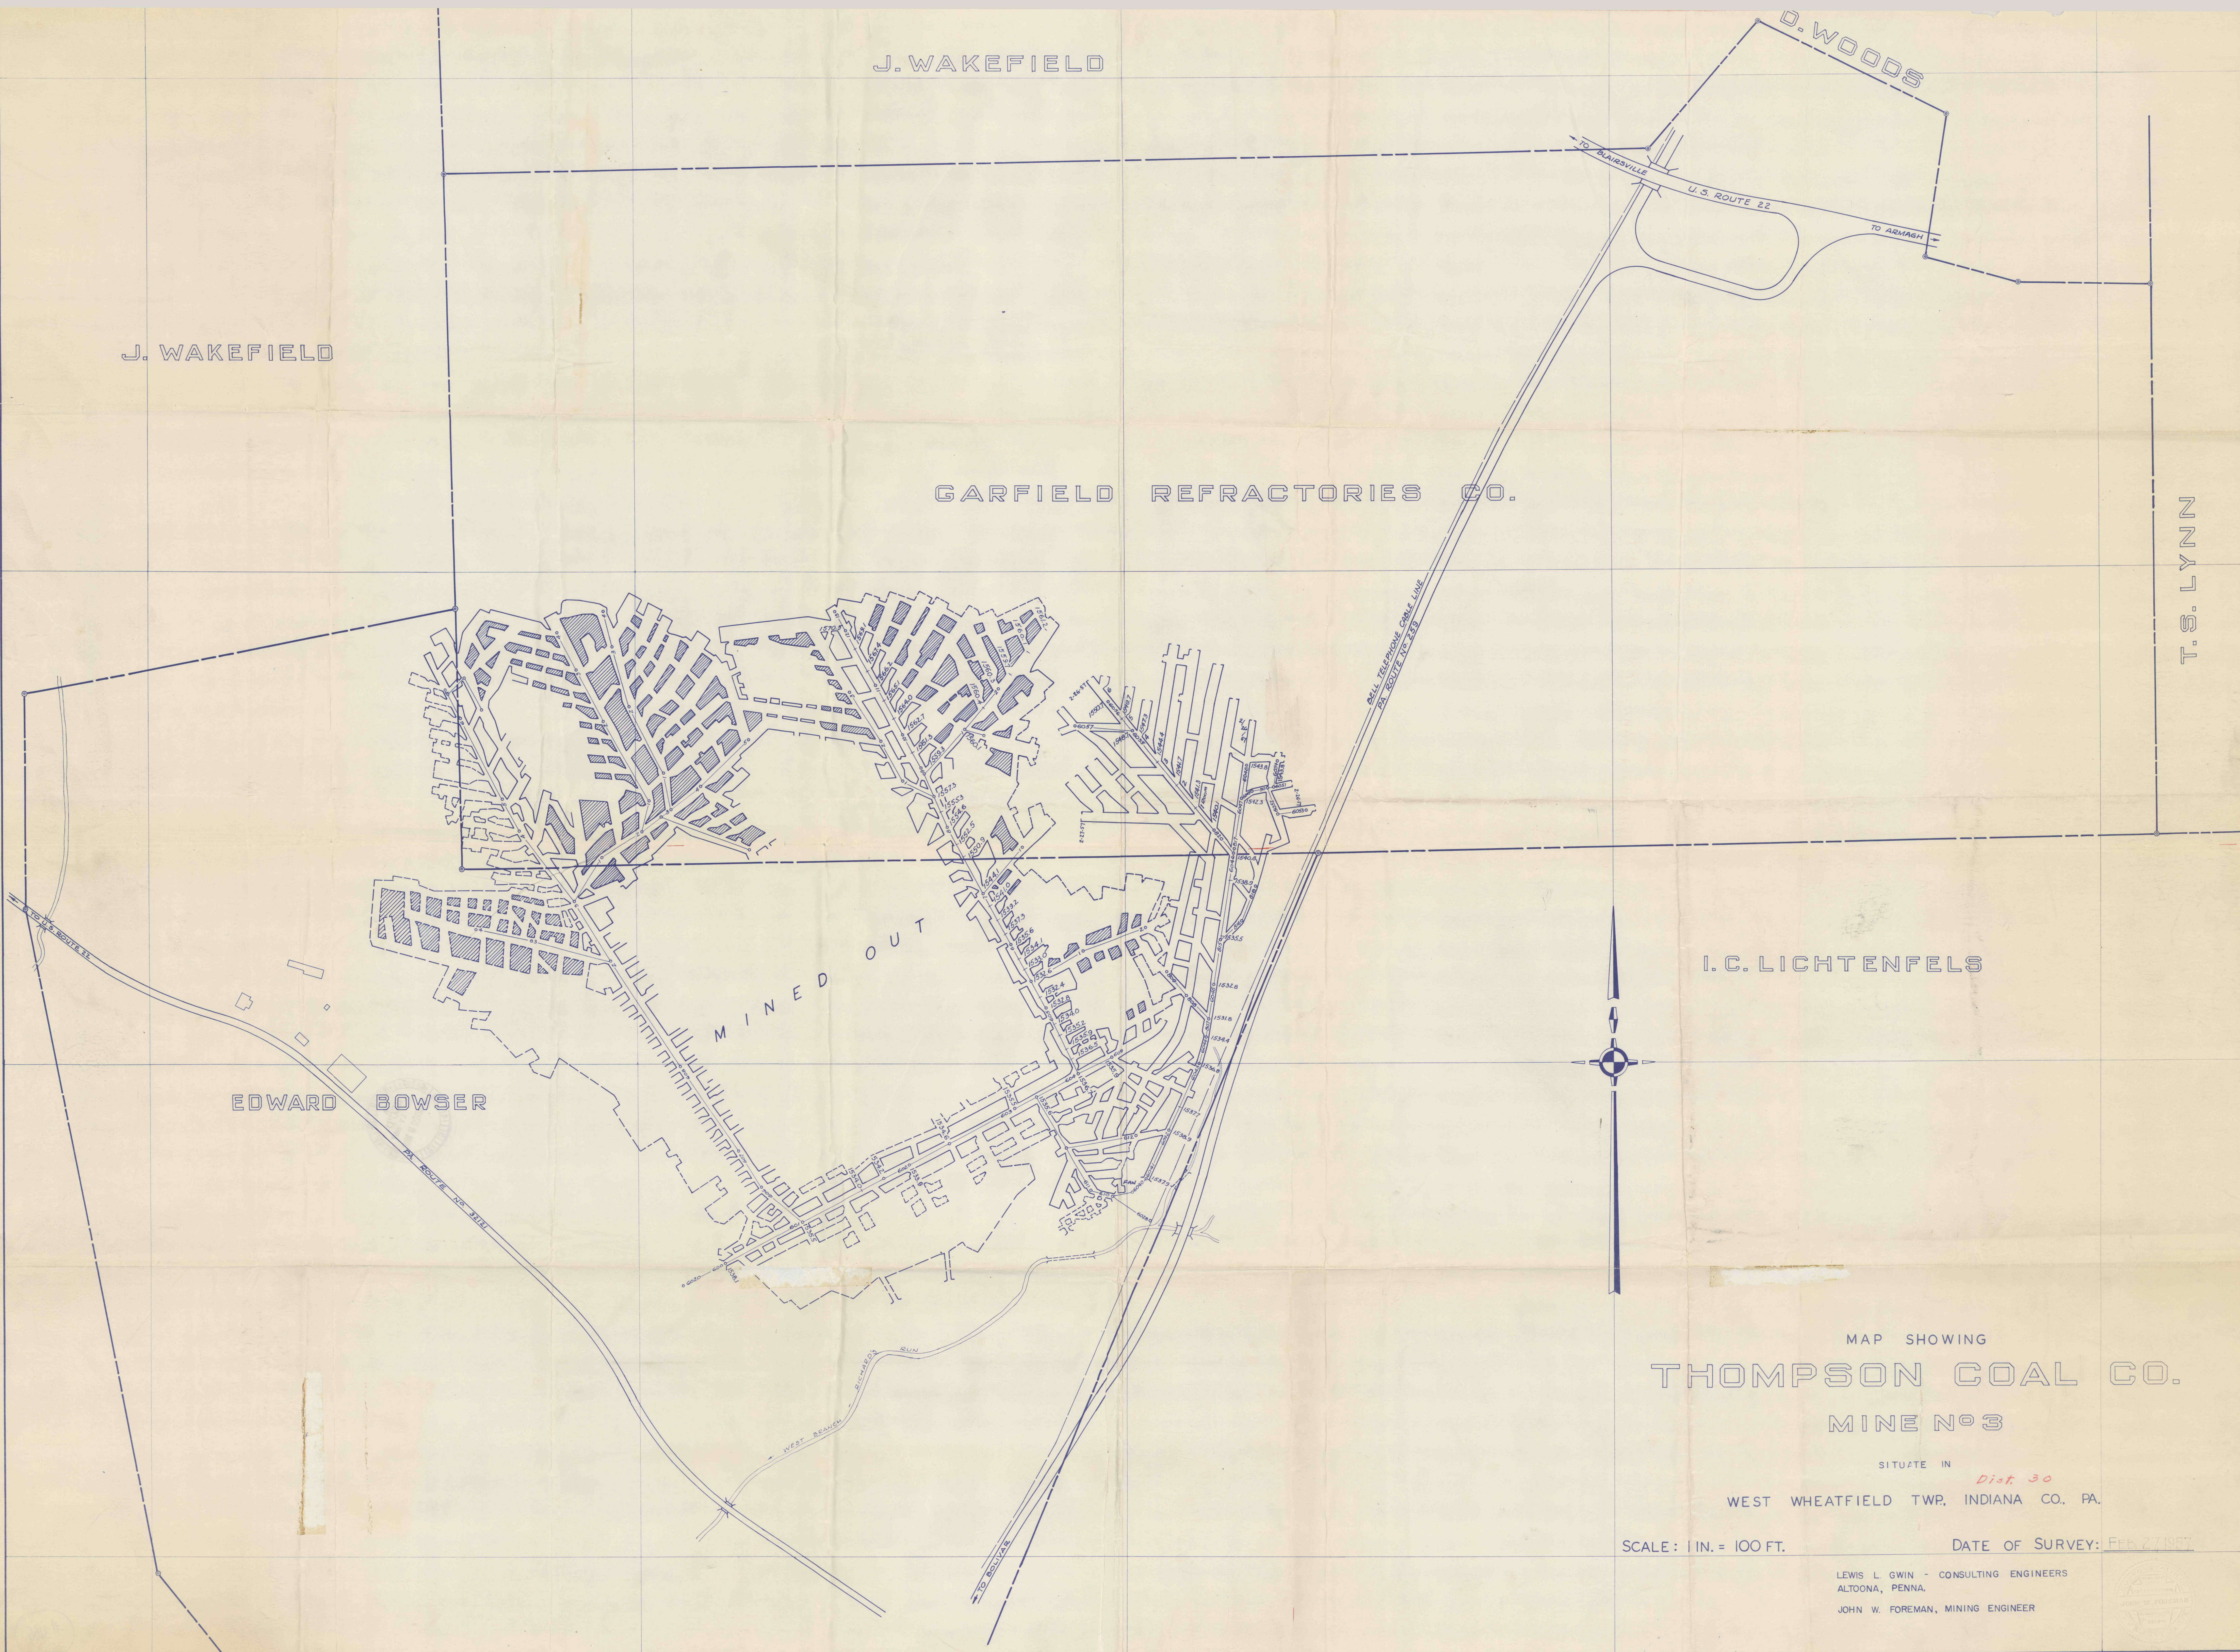

I.C. LICHTENFELS

EDWARD BOWSER

MINED OUT

MAP SHOWING  
**THOMPSON COAL CO.**  
**MINE NO 3**

SITUATE IN *Dist 30*  
 WEST WHEATFIELD TWP, INDIANA CO., PA.

SCALE: 1 IN. = 100 FT.

DATE OF SURVEY: FEB 27 1907

LEWIS L. GWIN - CONSULTING ENGINEERS  
 ALTOONA, PENNA.  
 JOHN W. FOREMAN, MINING ENGINEER

