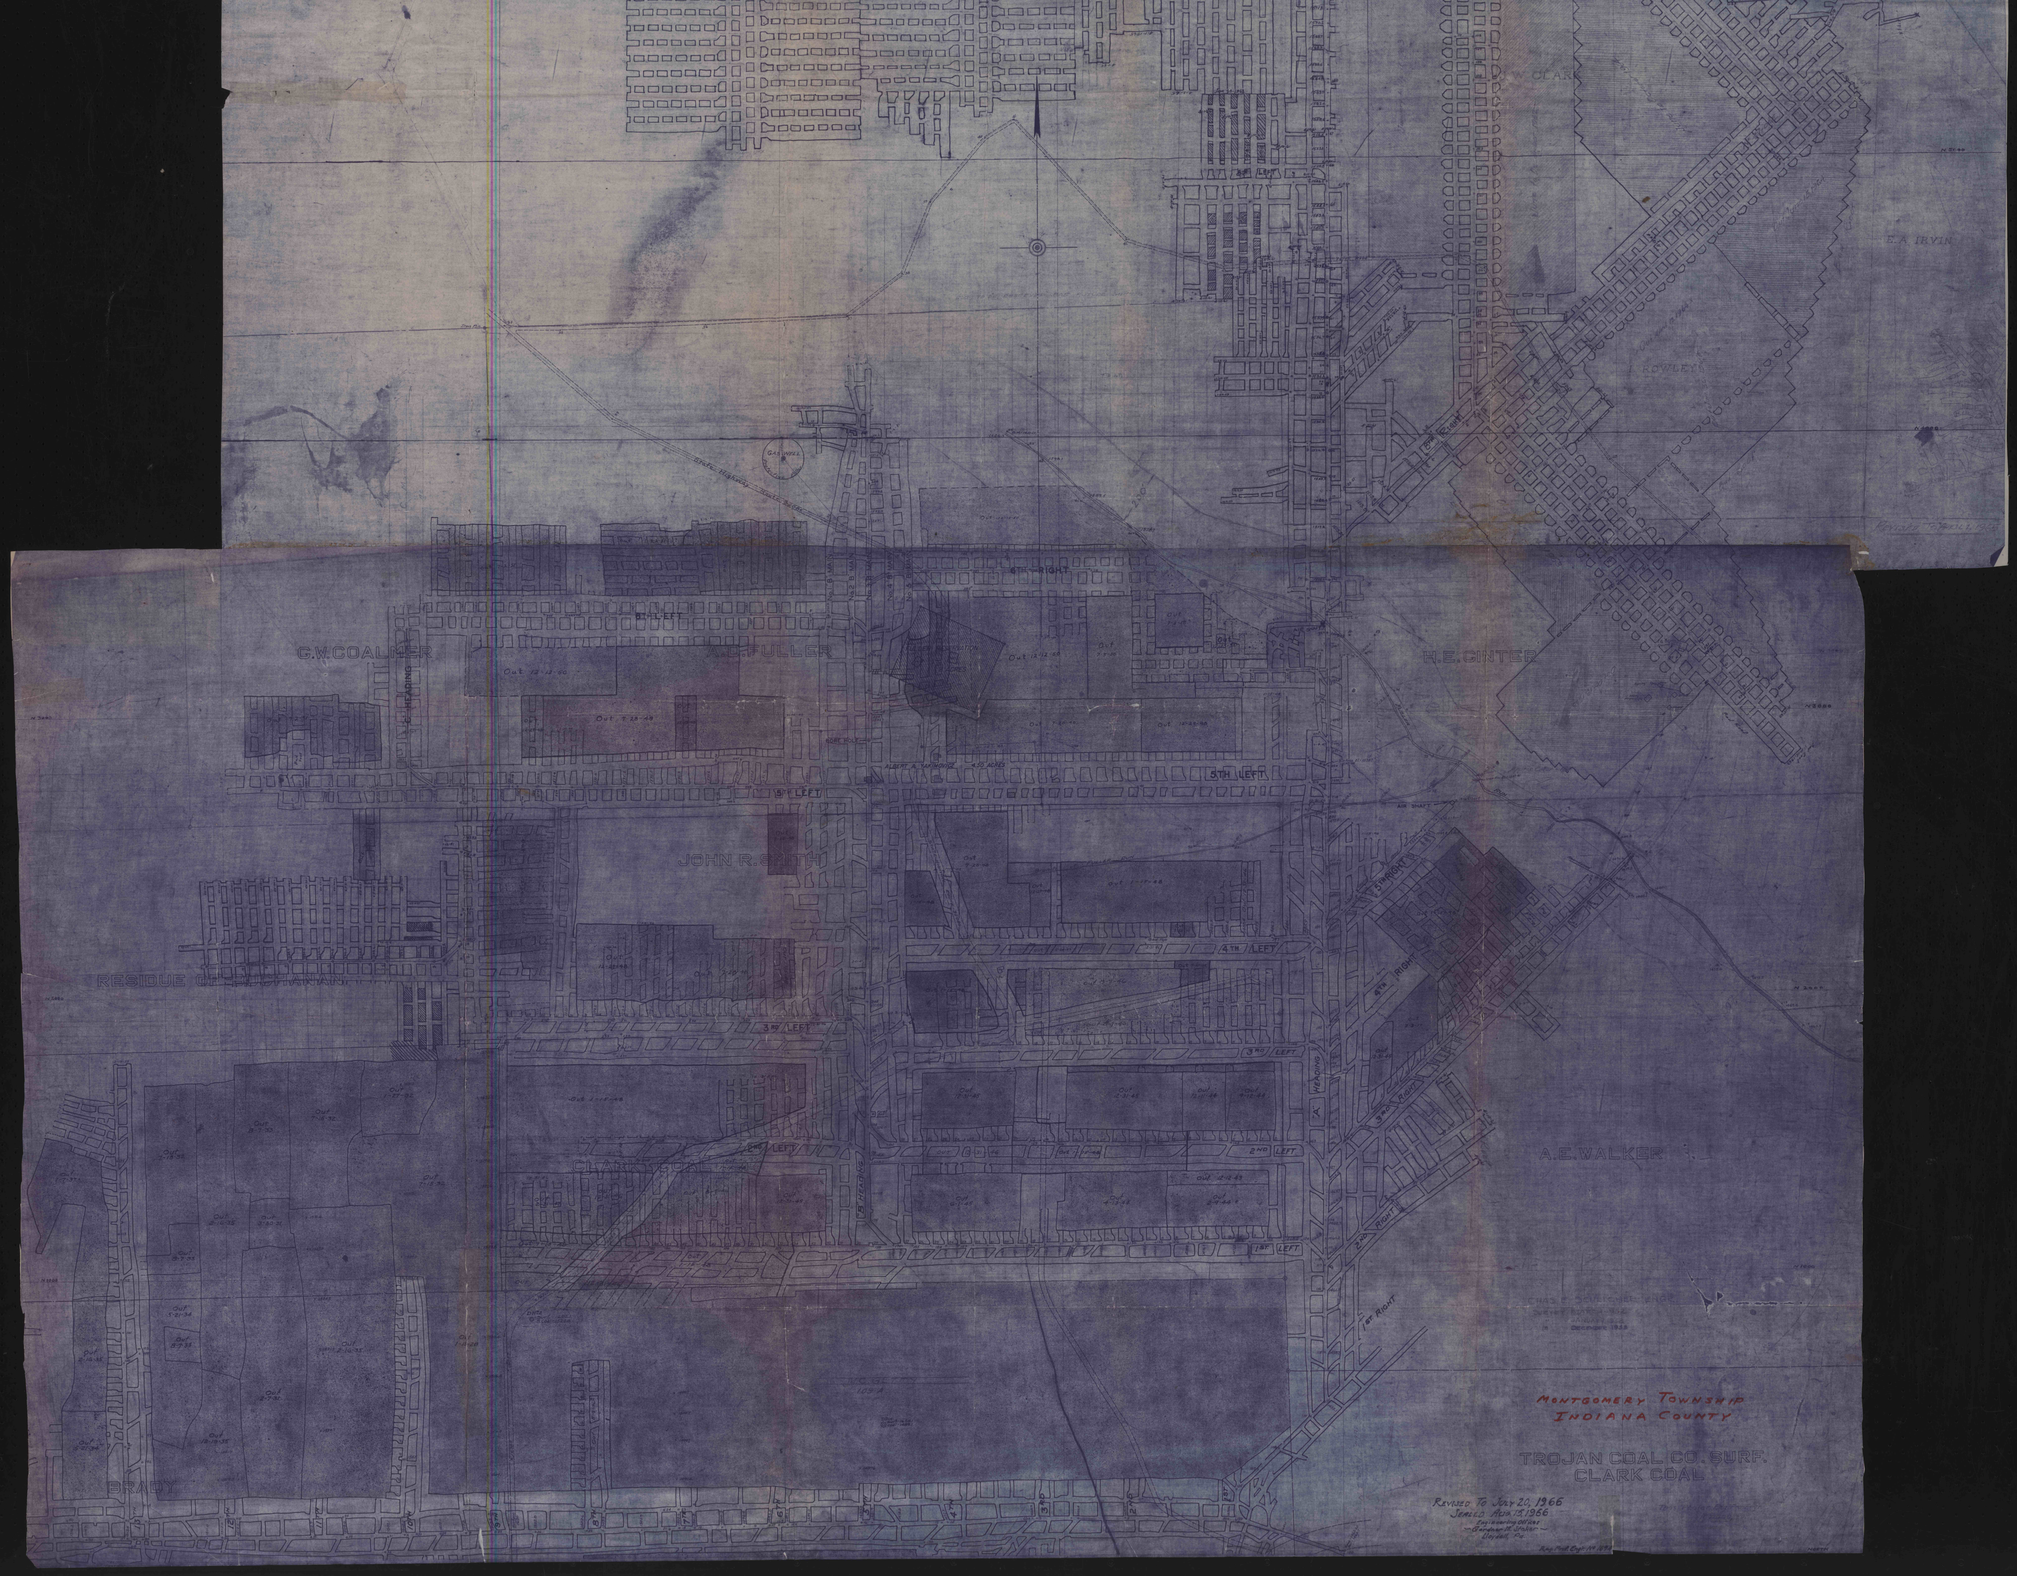

G.W.COALMER
A.D.FULLER
H.E.CINTER
JOHN R.SMITH
RESIDUE OF
A.E.WALKER
BRADY
E.A. IRVIN
ROWLEY
MONTGOMERY TOWNSHIP
INDIANA COUNTY
TROJAN COAL CO. SURF.
CLARK COAL
REVISED TO JULY 20, 1966
SEALED AUG 15, 1966