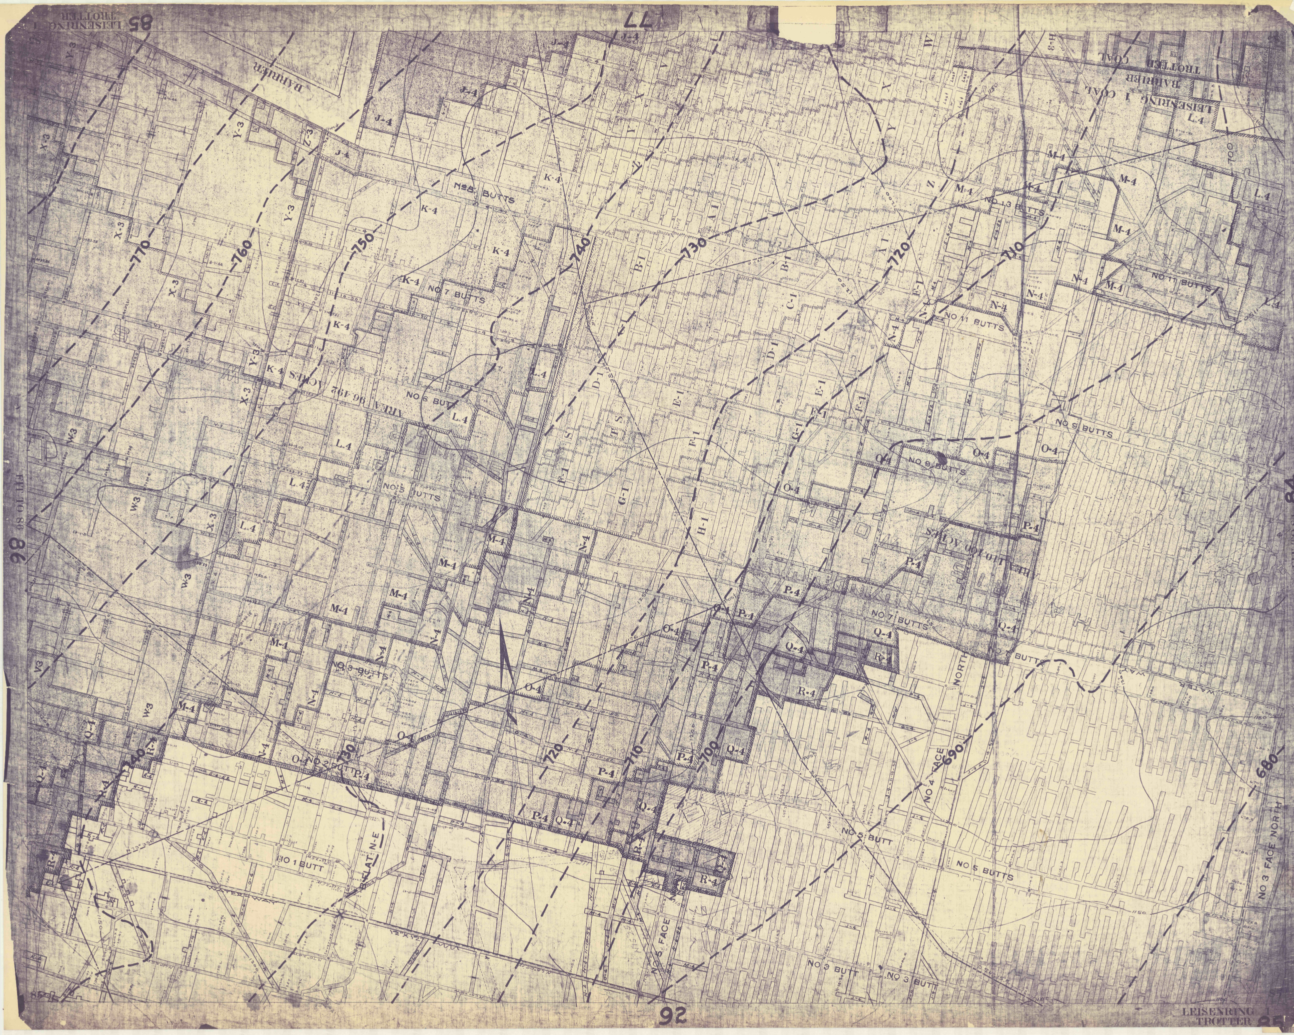
85
77
98
84
92
LEISENRING 1
TROTTER 85
BARRIER
LEISENRING 1 COAL
TROTTER COAL
770
760
750
740
730
720
710
700
690
680
NO 8 BUTTS
NO 7 BUTTS
NO 6 BUTT
NO 5 BUTTS
NO 3 BUTTS
NO 2 BUTT
NO 1 BUTT
NO 13 BUTTS
NO 11 BUTTS
NO 9 BUTTS
NO 7 BUTTS
NO 5 BUTT
NO 5 BUTTS
NO 3 BUTT
NO 3 BUTT
NO 4 FACE NORTH
NO 3 FACE NORTH
NO 5 FACE NORTH
1st FLAT N-E
WATER WAY
AREA 96.192 ACRES
AREA 110.001 ACRES
J-4
K-4
L.4
M-4
N-4
O-4
P-4
Q-4
R-4
X-3
Y-3
W-3
V3
B-1
C-1
D-1
E-1
F-1
G-1
H-1

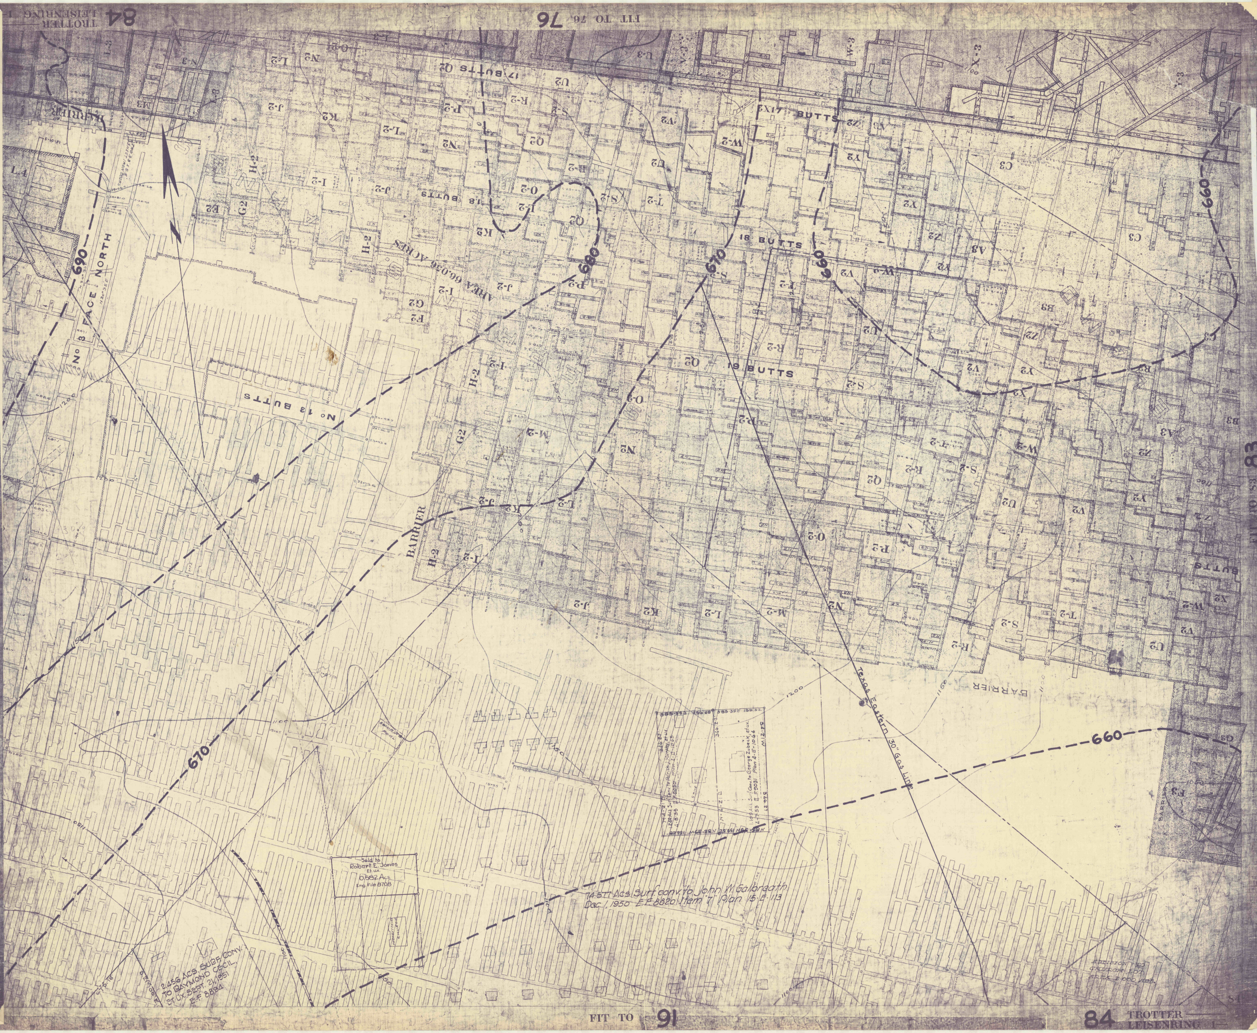
84 TROTTER LEISENRING 1
FIT TO 76
FIT TO 83
No 3 FACE NORTH
No 13 BUTTS
17 BUTTS
18 BUTTS
19 BUTTS
X 17 BUTTS
BUTTS
AREA 66.036 ACRES
BARRIER
690
680
670
660
1200
1150
1100
L4
H-2
I-2
J-2
K2
O-2
Q2
S-2
T-2
U2
V2
W-2
Y2
Z2
A3
B3
C3
F3
G3
Texas Eastern 30" Gas Line
Sold to
Robert E. Jones
Et. ux.
0.582 Acs.
Eng. File 8708
74.577 Acs. Surf. conv. to John W. Galbreath
Dec. 1, 1950 E.F. 8820 Item "7" Plan 15-E-113
2.456 ACS. SURF. CONV.
TO RAYMOND CECIL,
ET UX. SEPT. 21, 1951
E.F. 8894
1.244 Acs. Surf. Conv. to Patrick J. Murphy, et ux.
4-8-53 E.F. 9030 Plan 1-E-1065
1.109 Acs. Surf. Conv. to George Zubeck, et ux.
4-7-53 E.F. 9031 Plan 4-E-1064
S85-39E 156.48
S85-39E 159.52
N85-39W 135.52
N85-39W 156.48
346.27
N4-21E
S4-21W
N4-21E
PRESBYTERIAN CHURCH

FIT TO 91

84 TROTTER LEISENRING 1

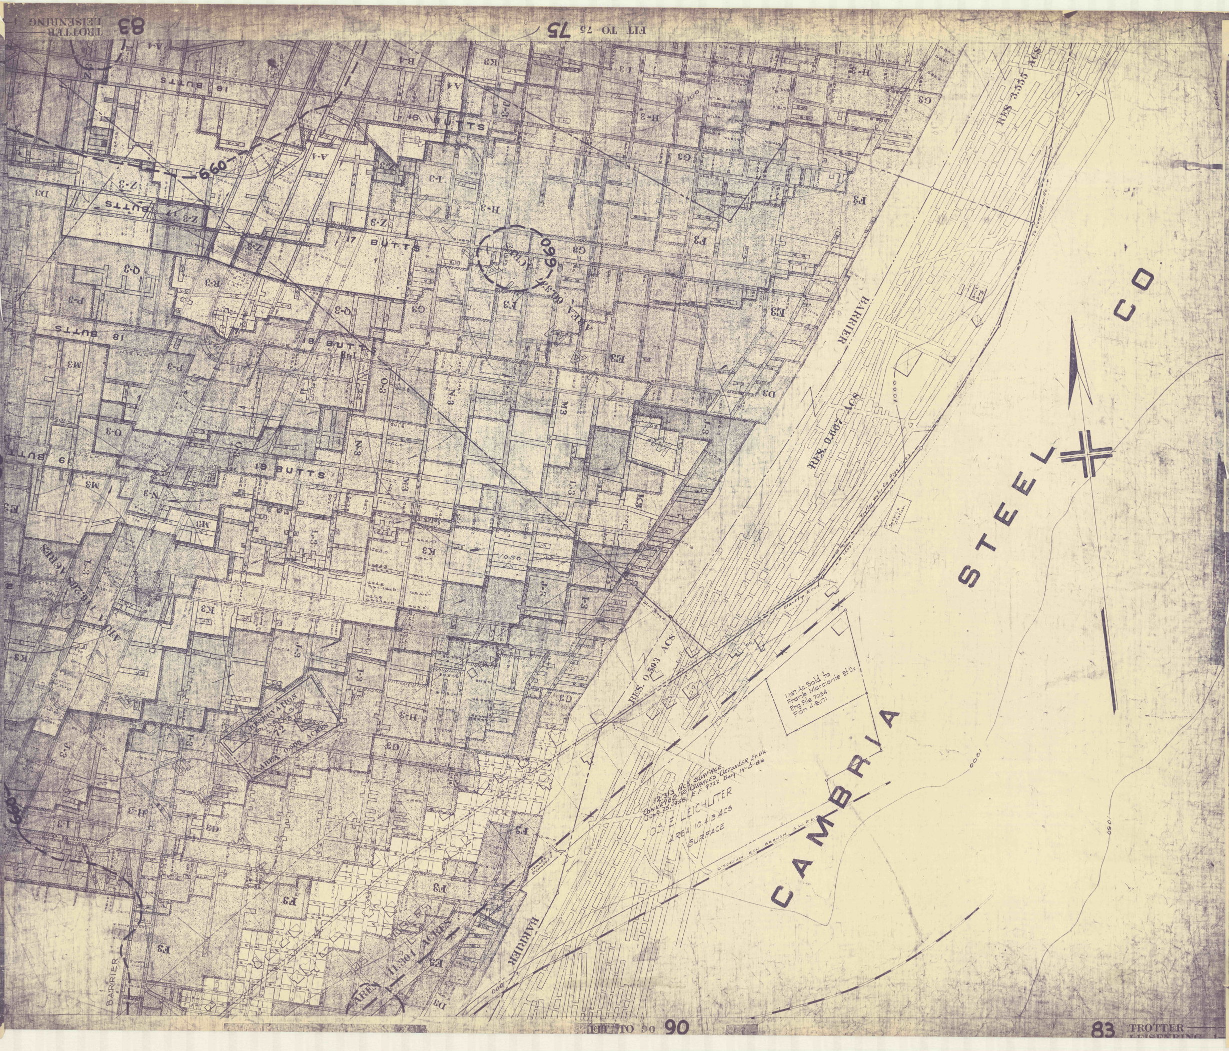

83 TROTTER LEISENRING
FIT TO 75 75
16 BUTTS
17 BUTTS
18 BUTTS
19 BUTTS
660
AREA 60.34 ACRES
AREA 11.304 ACRES
RESERVATION
AREA 0.900 ACRES
BARRIER
BARRIER
BARRIER
RES. 3.555 ACS
RES. 0.667 ACS
RES. 0.503 ACS
CAMBRIA STEEL CO
1.167 Ac. Sold to Frank Marciante Et Ux Eng. File 7054 Plan 4-8-171
12.313 Acs. Surface Conveyed to Charles Detwiler Et. Ux. June 25, 1958 E.F. 9722 Dwg 14-D-816
JOS. E. LEICHLITER
AREA 10.43 ACS
SURFACE
O'POSSUM RUN BRANCH S.W. P.R.R.
1000
1050
FIT TO 90 90
83 TROTTER LEISENRING
TROTTER
FIT TO

TROTTER MINE

OF THE

H. C. FRICK COKE CO.

DUNBAR TWP. - FAYETTE CO. - PA.

DATUM OF LEVELS 18.1 FT. BELOW MEAN TIDE AT SANDY HOOK

SCALE 1"=100'

FIT TO 74

DATE OF SURVEYS

SEPTEMBER	19	1893	A	NOVEMBER	13	1900	A1	MARCH	2	1908	A2	SEPTEMBER	7	1914	A-3	MAY	7	1928	A-4
JANUARY	6	1894	B	FEBRUARY	22	1901	B1	JUNE	12	1908	B2	DECEMBER	8	1914	B-3	OCTOBER	31	1928	B-4
APRIL	16	1894	C	MAY	21	1901	C1	SEPTEMBER	9	1908	C2	JUNE	3	1915	C-3	MAY	7	1929	C-4
AUGUST	16	1894	D	AUGUST	14	1901	D1	DECEMBER	7	1908	D2	DECEMBER	10	1915	D-3	NOVEMBER	13	1929	D-4
NOVEMBER	20	1894	E	NOVEMBER	21	1901	E1	MARCH	5	1909	E2	JUNE	24	1916	E-3	NOVEMBER	19	1930	E-4
MARCH	2	1895	F	FEBRUARY	20	1902	F1	JUNE	5	1909	F2	DECEMBER	21	1916	F-3	DECEMBER	2	1931	F-4
JUNE	4	1895	G	JUNE	30	1902	G1	SEPTEMBER	7	1909	G2	JUNE	13	1917	G-3	DECEMBER	14	1932	G-4
AUGUST	16	1895	H	OCTOBER	25	1902	H1	DECEMBER	14	1909	H2	January	8	1917	H-3	DECEMBER	28	1933	H-4
DECEMBER	12	1895	I	JANUARY	8	1903	I1	MARCH	11	1910	I-2	MAY	17	1918	I-3	JUNE	11	1934	I-4
MAY	2	1896	J	APRIL	27	1903	J1	JUNE	7	1910	J-2	NOVEMBER	15	1918	J-3	AUGUST	29	1934	J-4
AUGUST	10	1896	K	JULY	20	1903	K1	SEPTEMBER	5	1910	K-2	JUNE	4	1919	K-3	OCTOBER	4	1934	K-4
DECEMBER	17	1896	L					DECEMBER	5	1910	L-2	DECEMBER	19	1919	L-3	FEBRUARY	4	1935	L-4
MARCH	19	1897	M	APRIL	28	1904	M1	MARCH	5	1911	M-2	MAY	10	1920	M-3	JULY	1	1935	M-4
JULY	9	1897	N	SEPTEMBER	7	1904	N1	JUNE	3	1911	N-2	OCTOBER	25	1920	N-3	JANUARY	1	1936	N-4
OCTOBER	6	1897	O	JANUARY	31	1905	O1	SEPTEMBER	5	1911	O-2	MAY	9	1921	O-3	JULY	7	1937	O-4
DECEMBER	23	1897	P	MAY	12	1905	P1	December	5	1911	P-2	JULY	20	1922	P-3	JANUARY	1	1938	P-4
MARCH	23	1898	Q	AUGUST	15	1905	Q1	MARCH	5	1912	Q-2	MARCH	5	1923	Q-3	MARCH	31	1938	Q-4
JULY	5	1898	R	NOVEMBER	18	1905	R1	JUNE	5	1912	R-2	OCTOBER	30	1923	R-3				
SEPTEMBER	20	1898	S	FEBRUARY	18	1906	S1	SEPTEMBER	5	1912	S-2	MAY	1	1924	S-3				
DECEMBER	7	1898	T	MAY	25	1906	T1	DECEMBER	5	1912	T-2	NOVEMBER	3	1924	T-3				
MAY	30	1899	U	AUGUST	21	1906	U1	MARCH	5	1913	U-2	JUNE	8	1925	U-3				
JUNE	21	1899	V	DECEMBER	11	1906	V1	JUNE	5	1913	V-2	APRIL	30	1926	W-3				
SEPTEMBER	29	1899	W	MARCH	5	1907	W1	SEPTEMBER	5	1913	W-2	NOVEMBER	18	1926	X-3				
DECEMBER	27	1899	X	JUNE	12	1907	X1	DECEMBER	17	1913	X-2	MAY	26	1927	Y-3				
APRIL	17	1900	Y	OCTOBER	2	1907	Y1	MARCH	14	1914	Y-2	NOVEMBER	22	1927	Z-3				
JULY	26	1900	Z	JANUARY	14	1908	Z1	JUNE	16	1914	Z-2	DECEMBER	15	1927	Z-3				

H.C.Frick Coke Co.
McFarland & Mitchell, Lessees.
H.C.Frick Coke Co.
Republic Steel Corp'n, Lessee.

TROTTER - ADELAIDE
FIT THUS - 25 SHEETS

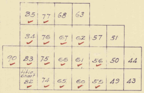
85
77
68
63
84
76
67
62
57
51
90
83
75
66
61
56
50
44
Title Sheet
82
74
65
60
55
49
43