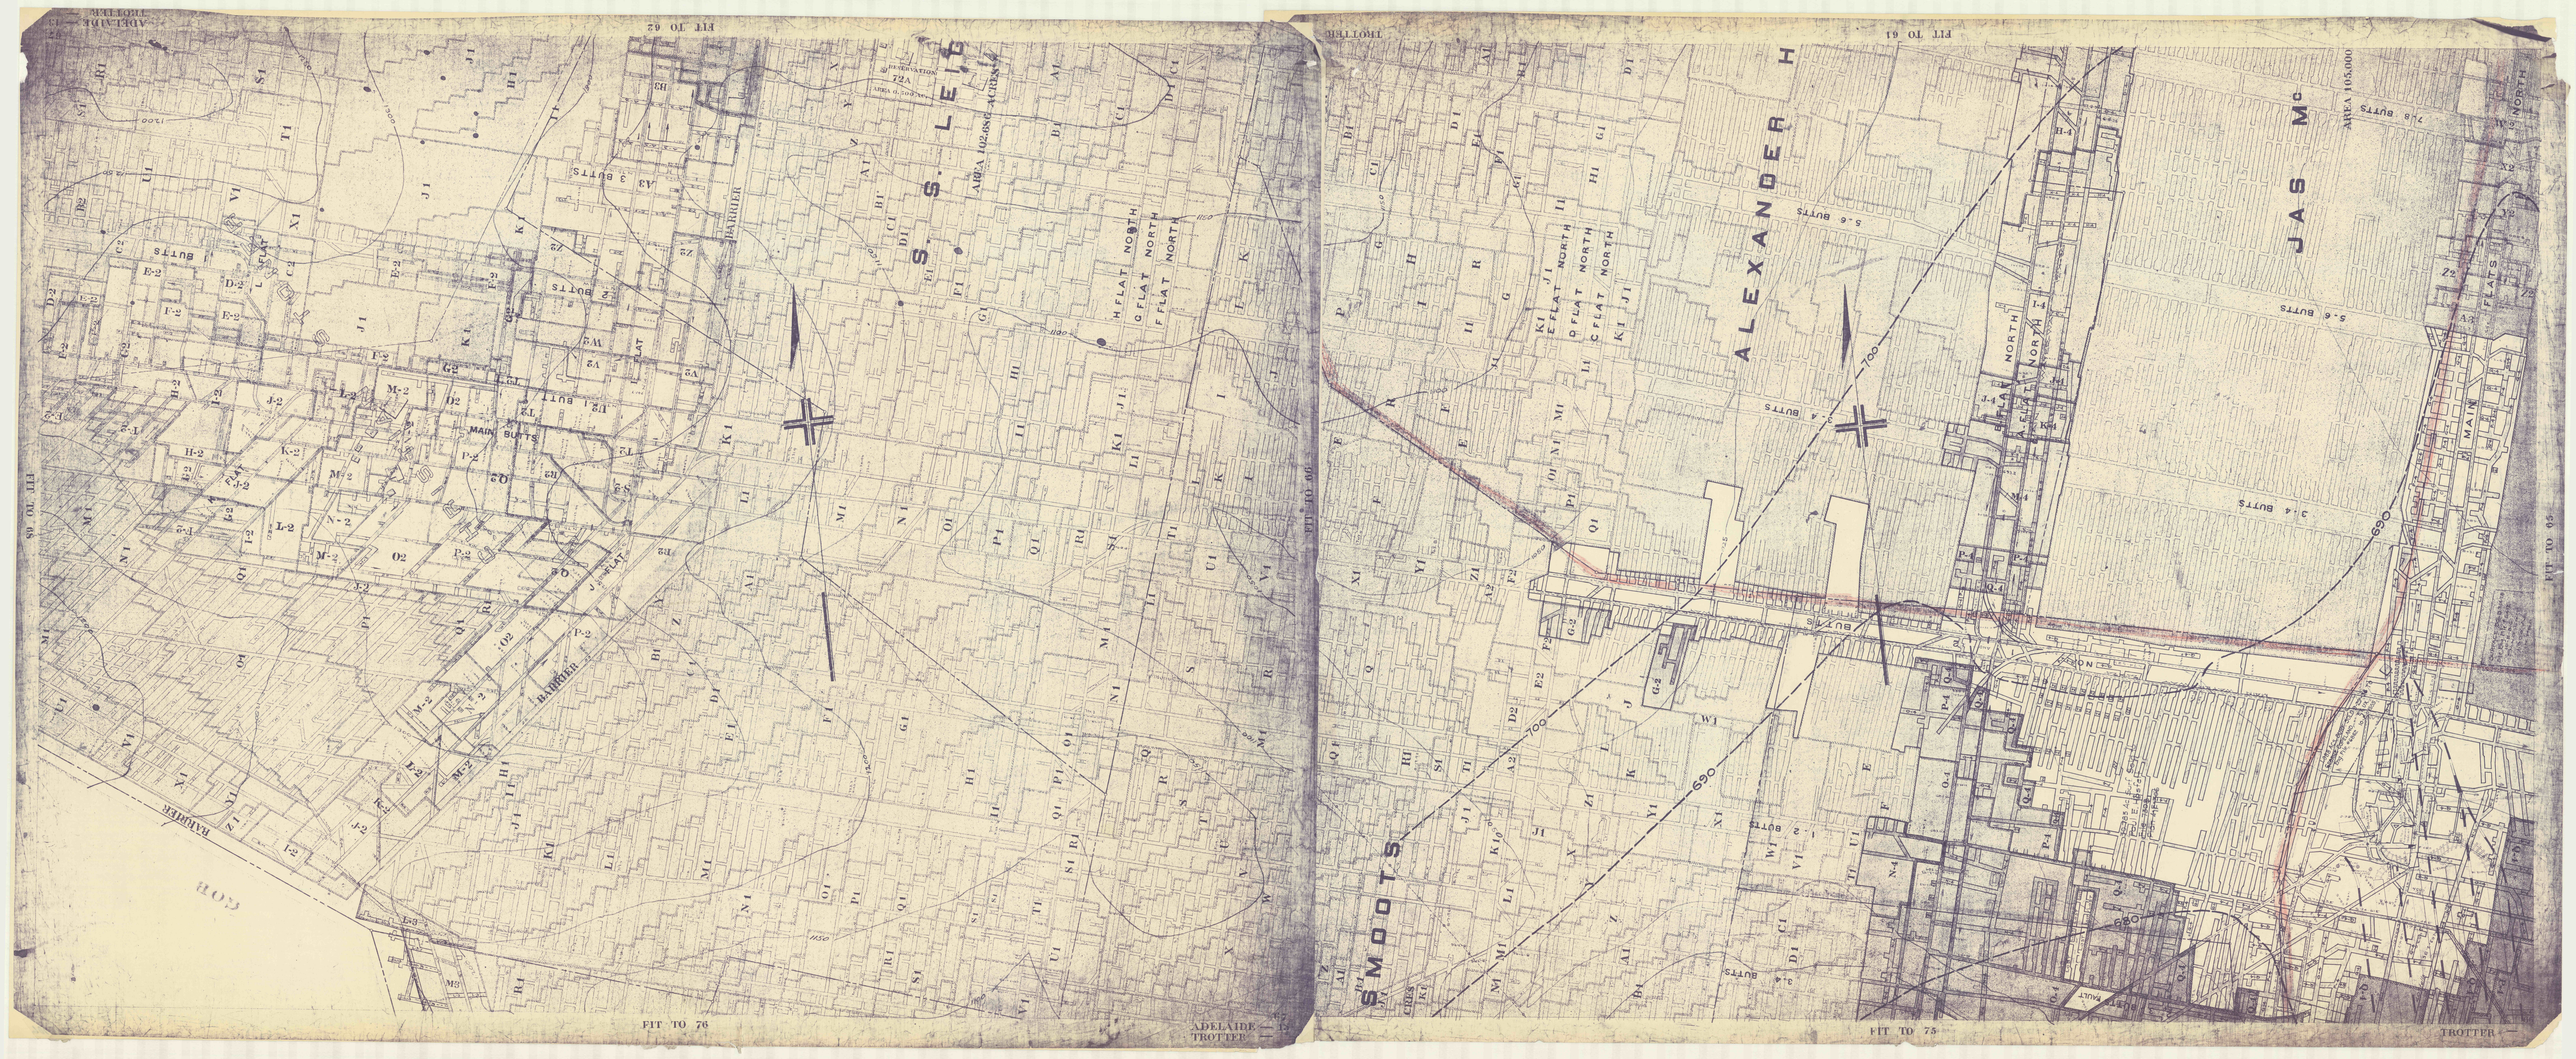
FIT TO 62
ADELAIDE — 13
TROTTER
FIT TO 65
FIT TO 66
S. S. LEIB
ALEXANDER
JAS Mc
SMOOTS
BARRIER
MAIN SUTTS
H FLAT NORTH
G FLAT NORTH
F FLAT NORTH
E FLAT NORTH
C FLAT NORTH
AREA 105.000
FIT TO 76
ADELAIDE — 13
TROTTER
FIT TO 61
FIT TO 75
TROTTER —
FIT TO 59