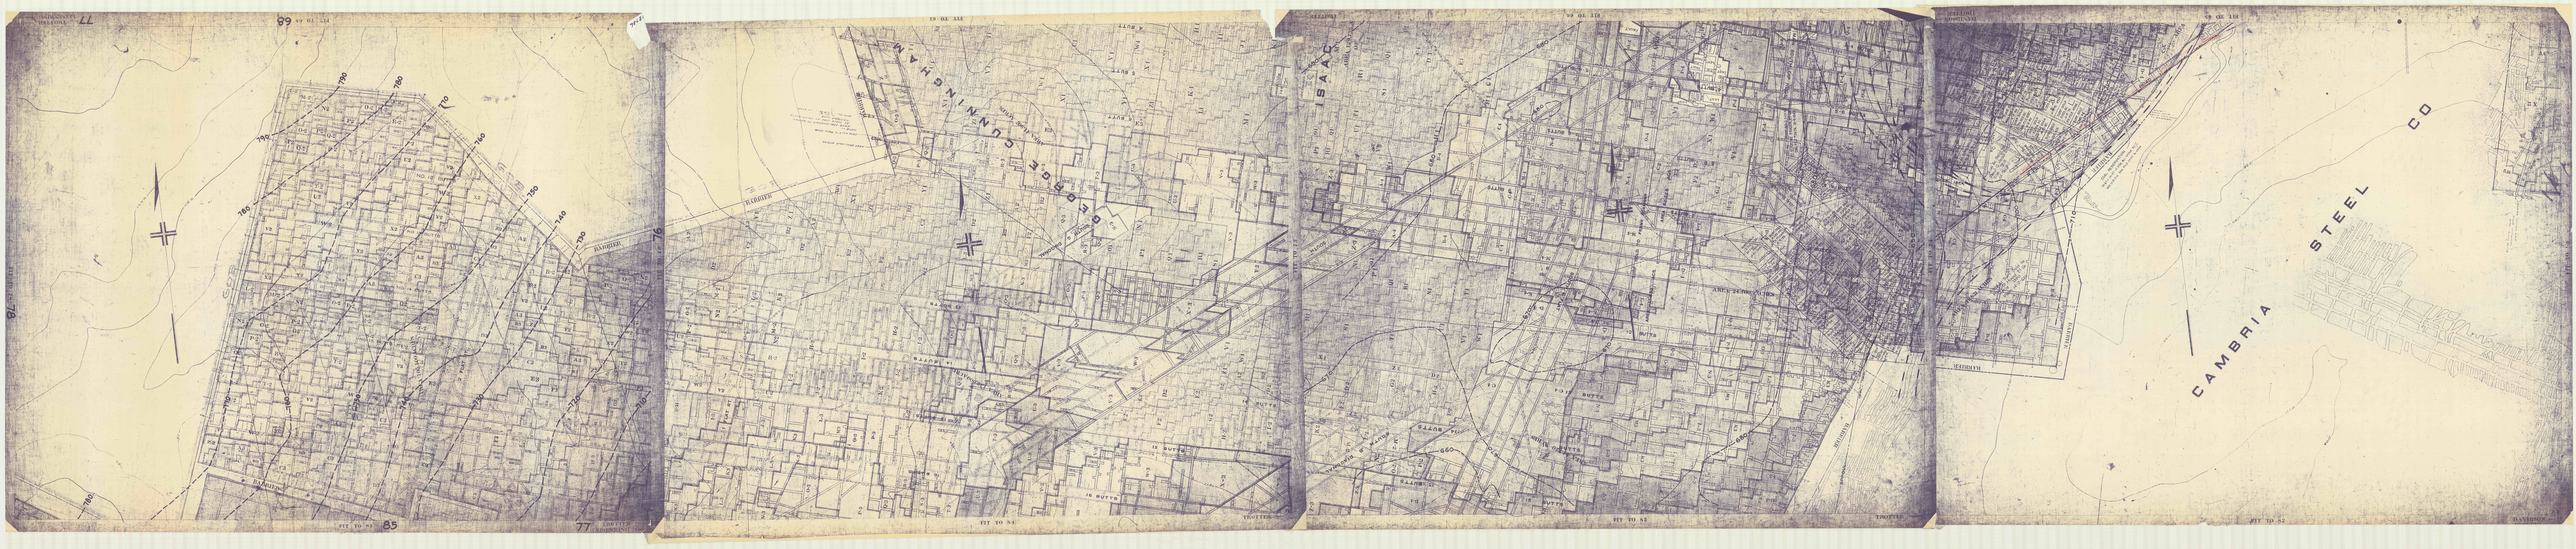

18786
TROTTER
LEISENRING
77
FIT TO 68
68
790
780
770
760
750
740
730
720
710
NO. 12 BUTTS
NO. 14 BUTTS
NO. 15 BUTTS
2 FLAT RT.
1 FLAT RT.
BARRIER
FIT TO 78
78
FIT TO 85
85
77
TROTTER
LEISENRING
76
FIT TO 76
FIT TO 67
GEORGE CUNNINGHAM
AREA 41.907 ACRES
SOUTH G DIAGONAL
5 BUTT
6 BUTT
13 BUTTS
14 BUTTS
15 BUTTS
16 BUTTS
FIT TO 84
TROTTER
FIT TO 75
TROTTER
FIT TO 66
ISAAC
AREA 129.73 ACRES
680
670
660
690
FAULT
LOST
MAIN SOUTH DIP HDGS
5-6 BUTTS
12 BUTTS
AREA 24.100 ACRES
SOUTH 8 DIAGONAL
FIT TO 83
FIT TO 74
TROTTER
75
DAVIDSON
TROTTER
FIT TO 65
ROAD
COAL RESERVATION
CAMBRIA STEEL CO
1100
1050
FIT TO 82
FIT TO 73
DAVIDSON
TROTTER
73