


CRAIG MARTIN

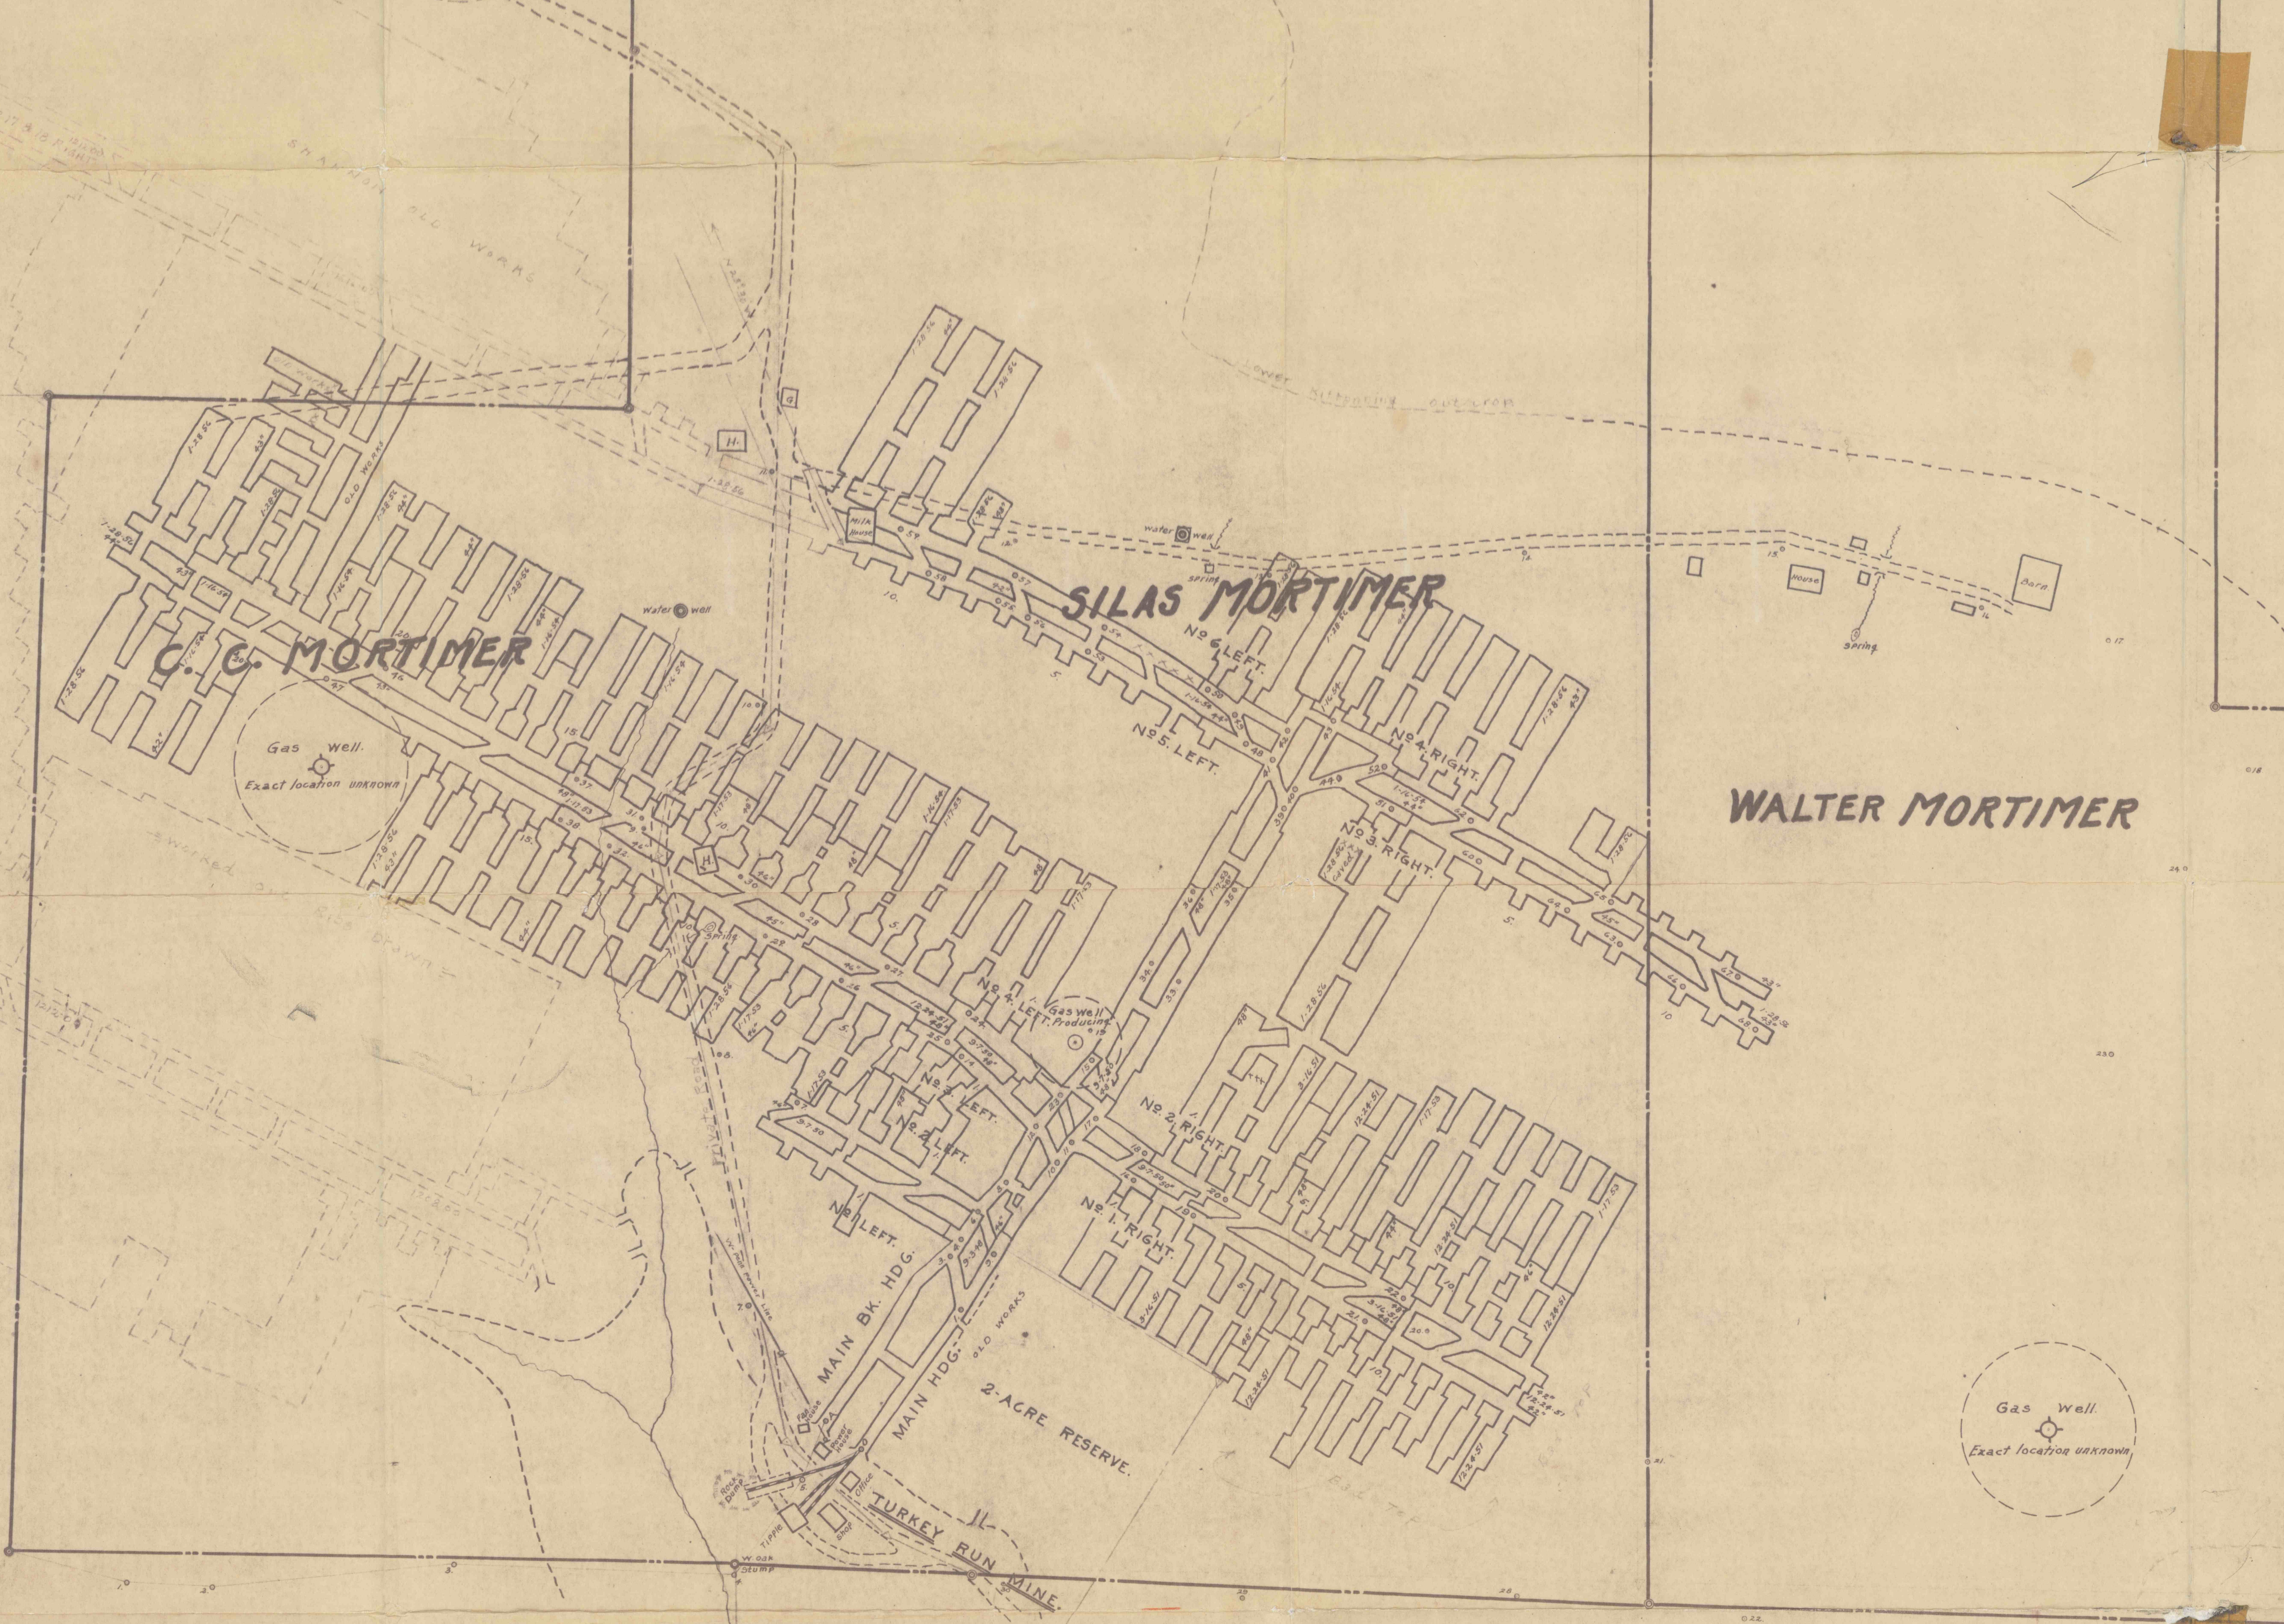

RALPH MORTIMER

ROBERT LONG

WALTER MORTIMER



1957 Annual
R.R. Coal Co.
Turkey Run

TURKEY RUN MINE
BAIN & MORTIMER COAL CO. INC.
MADISON TWP. CLARION CO. PA.
SURVEYED 1-28-56 Scale 1"=100'
C. H. & R. COAL CO. - OPERATOR.
RIMERSBURG, PA.
R. L. Pfaff Reg. Surveyor No. 9785.

Mr. Joseph T. Kennedy - Dept. of Mines and Mineral Industries
Oil & Gas Division
Harrisburg, Pa.