

WESTMORELAND MINING CO.

10-23-1958

12000 N


11000 N

10000 N

12000 N

11000 N

10000 N

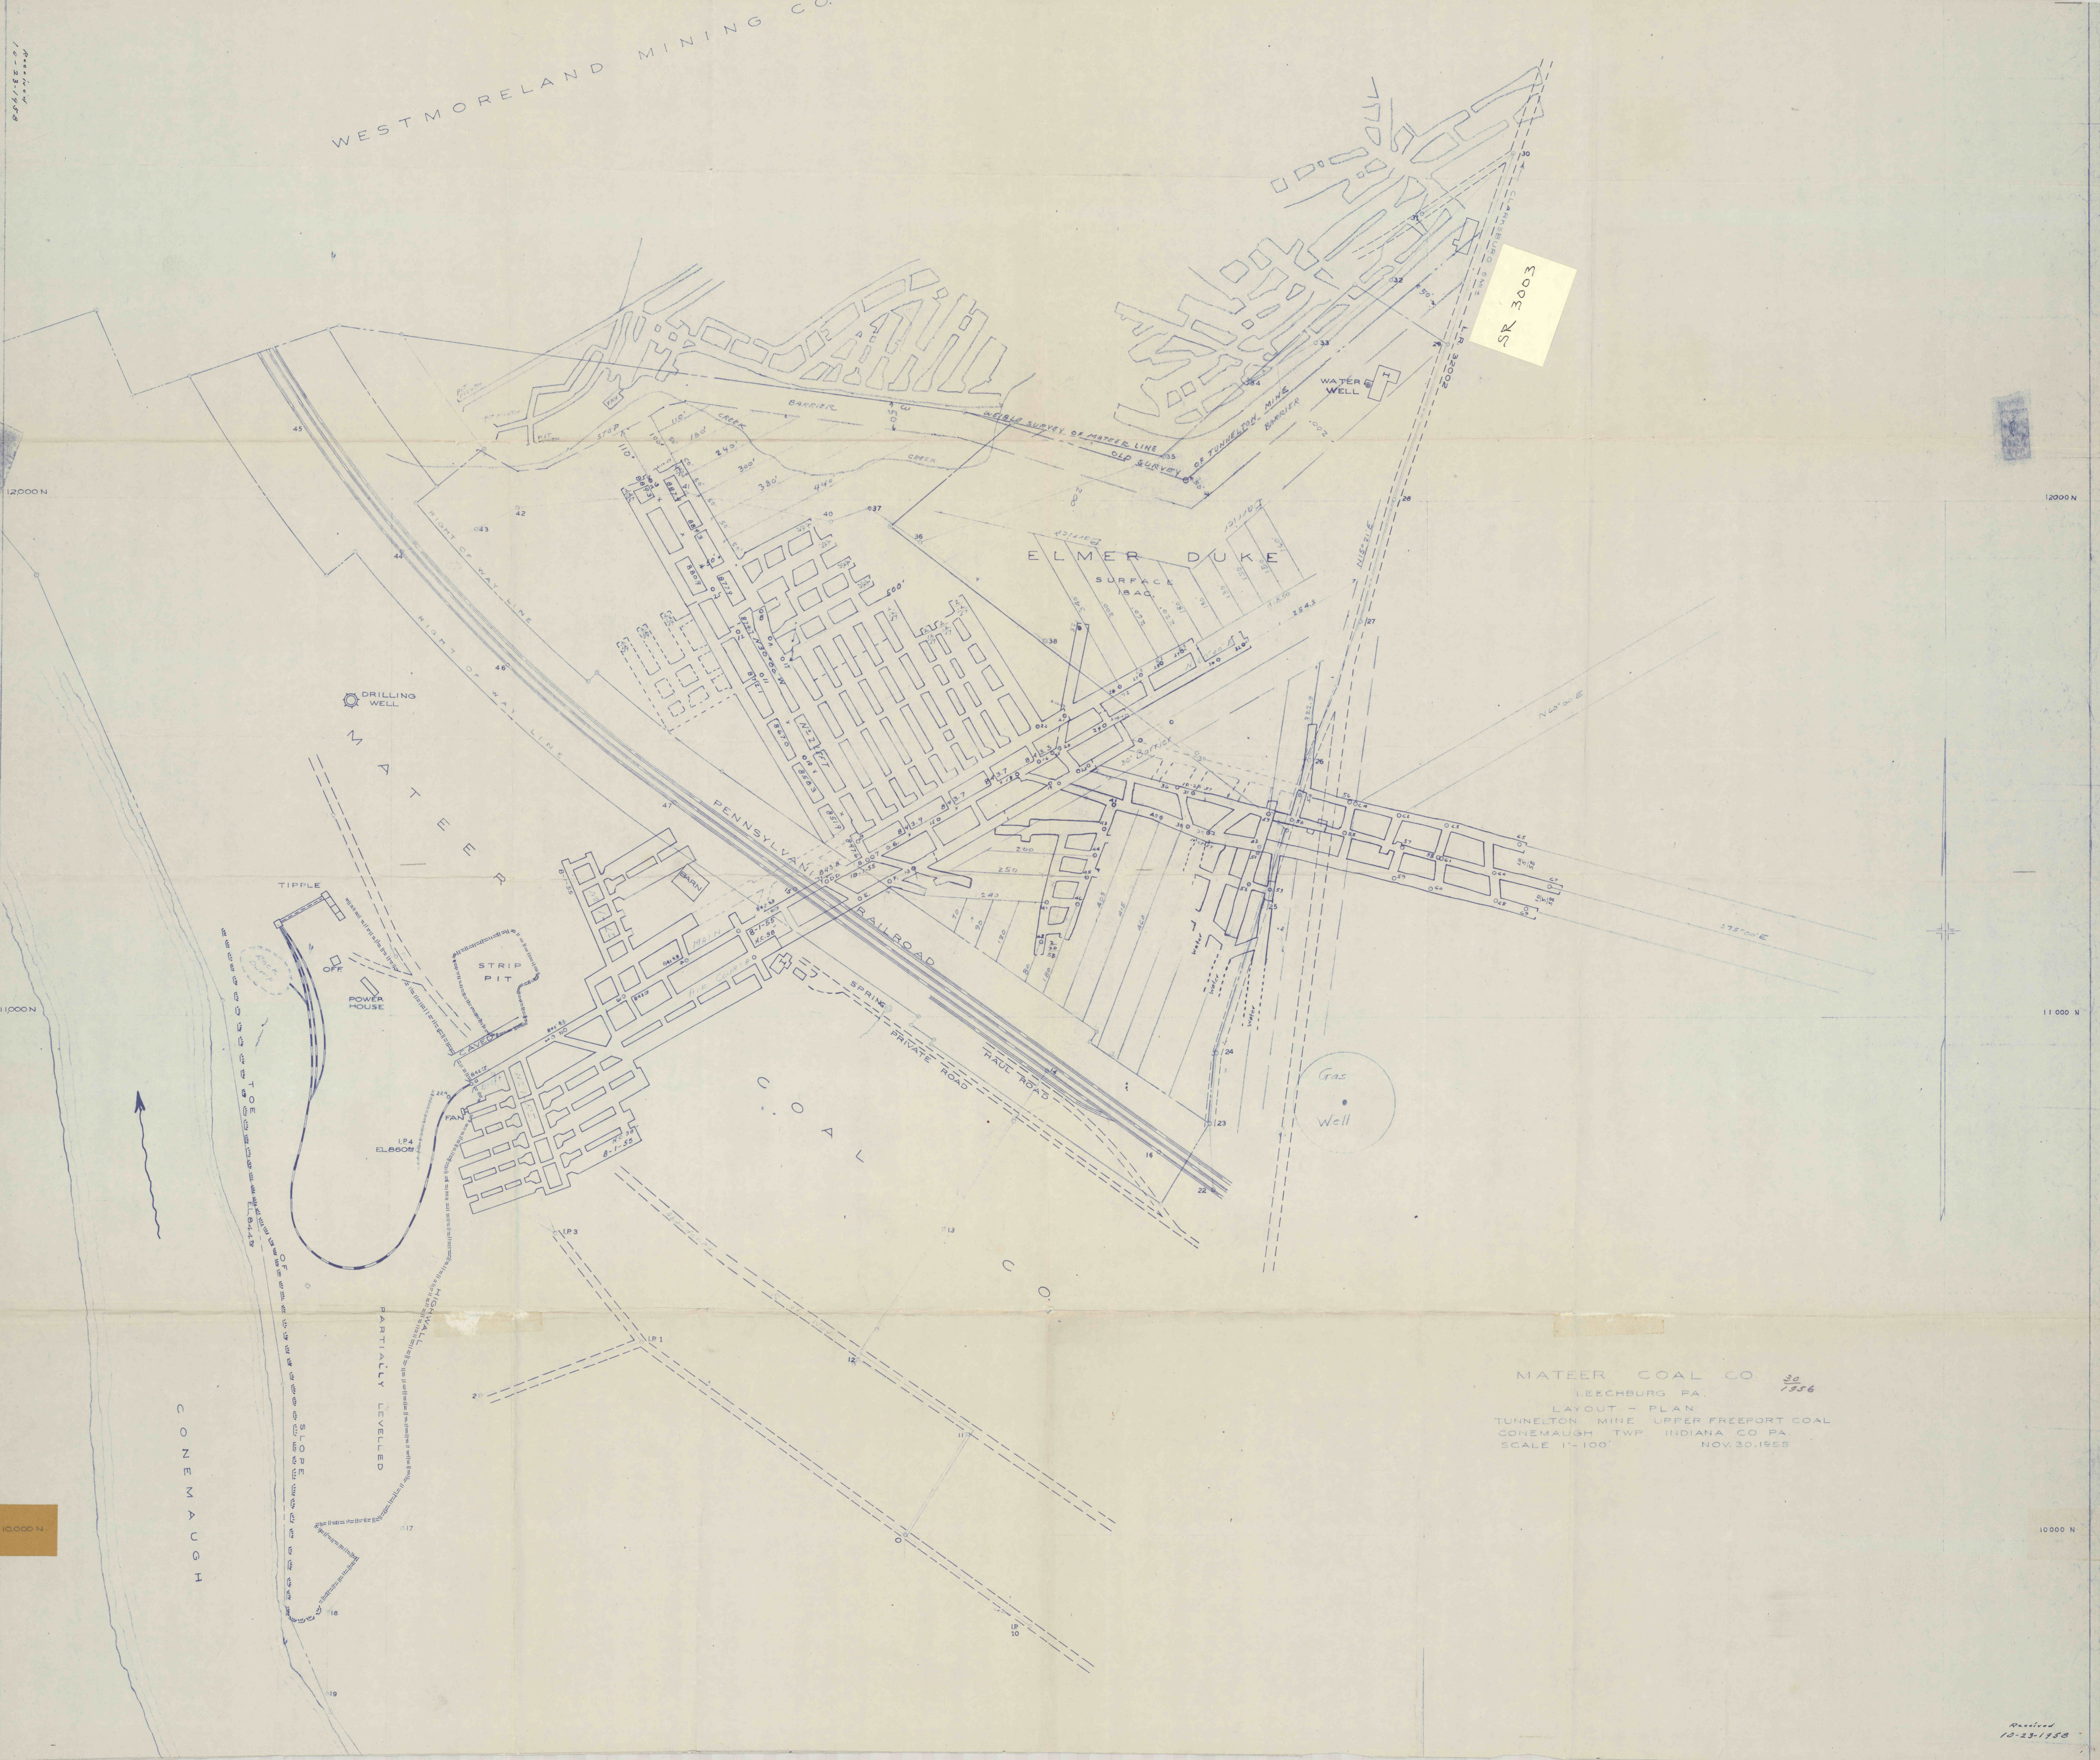

SR 3003

MATEER COAL CO 30
 LEECHBURG PA. 1956
 LAYOUT - PLAN
 TUNNELTON MINE UPPER FREEPORT COAL
 CONEMAUGH TWP. INDIANA CO PA.
 SCALE 1"=100' NOV. 30, 1955

Revised 10-23-1958