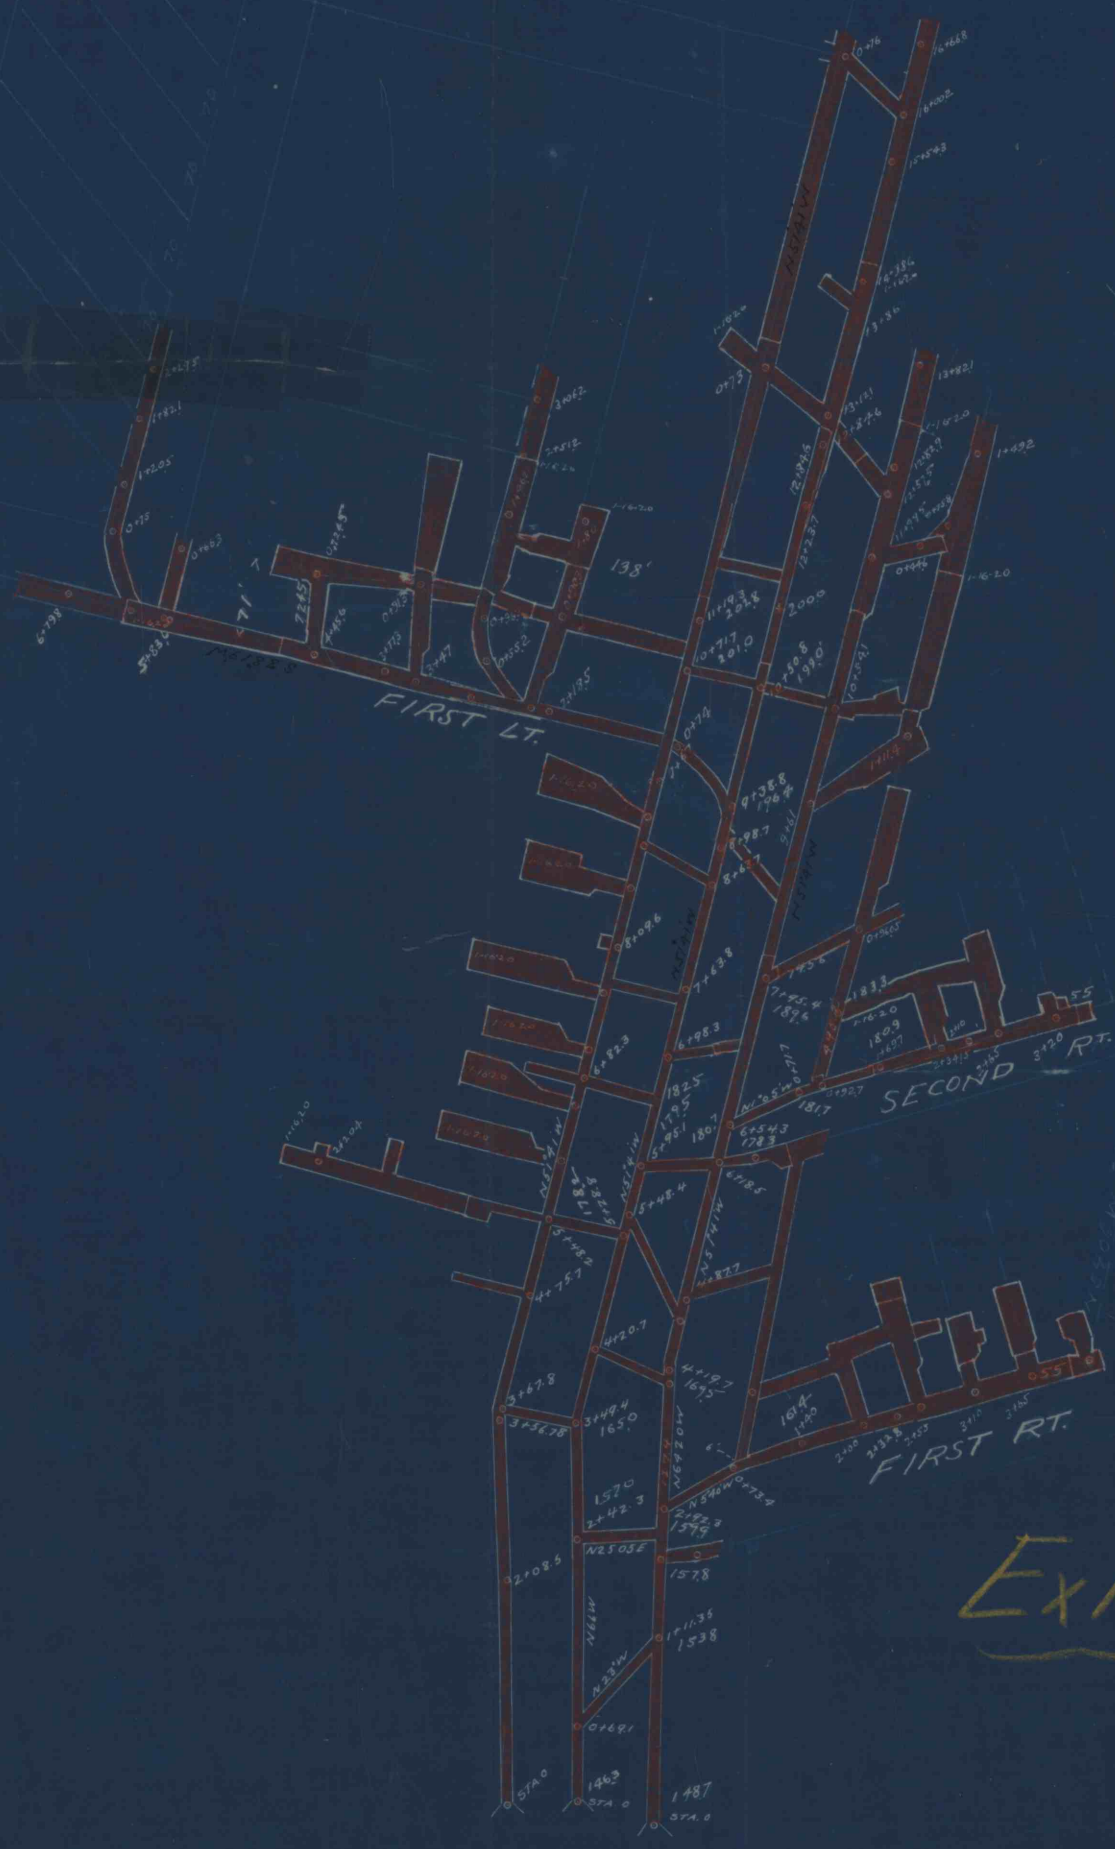

Exhibit "B"

PLAN
OF
MINE WORKINGS
OF
THE EAST FAYETTE COAL CO.
STEWART TOWNSHIP,
FAYETTE CO., PA.

SCALE 1" = 100.

JULY 31, 1920.
S.M. FOUST C.&M.E.
J.E.H.

LOWER KITTANNING COAL.