


Subsidence Legend

CONTEMPLATED MINING	From _____ to _____
PREVIOUS SIX MONTH'S MINING	_____
PROTECTED STRUCTURES	_____
SUPPORT AREAS -	_____
MINING COMPLETED	_____
LIMITS OF PERMIT	_____
COAL CONTOURS	_____ 2100 _____

_____	1989-1990
_____	1991
_____	1992
_____	Area of 100' cover or less

I, Randall L. Musser, a Professional Engineer in the Commonwealth of Pennsylvania, hereby certify that the surveying and mine mapping conducted by Musser Engineering, Inc. after August 9, 1994 was conducted in accordance with generally accepted surveying standards for the mining industry, and is true and correct to the best of my knowledge and belief. All base map preparation for the mine, and all mine surveying and mapping prior to August 9, 1994 was conducted by and certified by other engineering consultants.

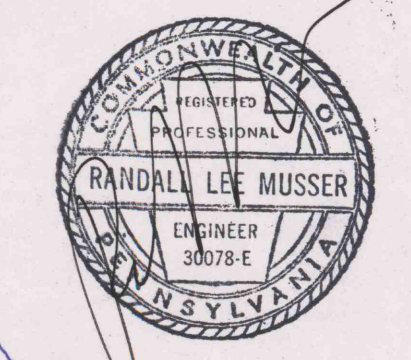

JUL 0 6 2005

FINAL MAP

PREPARED FOR **CMAP 5683301**
TRENT COAL, INC.

HRITZ (TRENT NO. 1) MINE
UPPER KITTANNING COAL SEAM
 SITGATE

**SHADE TOWNSHIP, SOMERSET COUNTY,
 PENNSYLVANIA**

SCALE - 1" = 100'

PREPARED BY
 7785 Lincoln Hwy., Central City, PA 15929
 (614) 754-8477
Musser Engineering, Inc.

RECEIVED
 JUL 0 8 2005
 Dept. of Environmental Protection
 Commonwealth of Pennsylvania