




RECEIVED  
OCT 16 1994  
Dept. of Environmental Resources  
Hatchery District Office

RECEIVED  
OCT 16 1994  
Dept. of Environmental Resources  
Hatchery District Office

OCT 14 1994

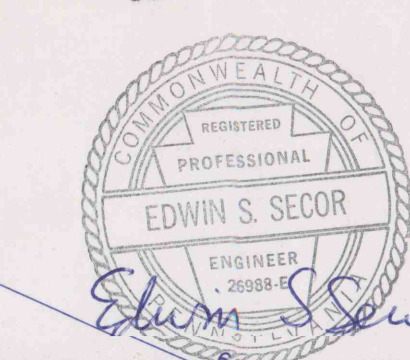

**FINAL MAP**

PREPARED FOR  
**TRENT COAL, INC.**

**MINE NO. 1**  
UPPER KITTANNING COAL SEAM  
SITUATE  
SHADE TOWNSHIP, SOMERSET COUNTY,  
PENNSYLVANIA

SCALE: 1" = 100'  
APRIL 16, 1982

PREPARED BY  
EARTHTECH  
R. D. 2, Box 124  
Somerset, PA 15501

phone: (814) 443-3584

SHEET  
4 of 6