


H. C. FRICK COKE CO.
FOOTDALE MINE

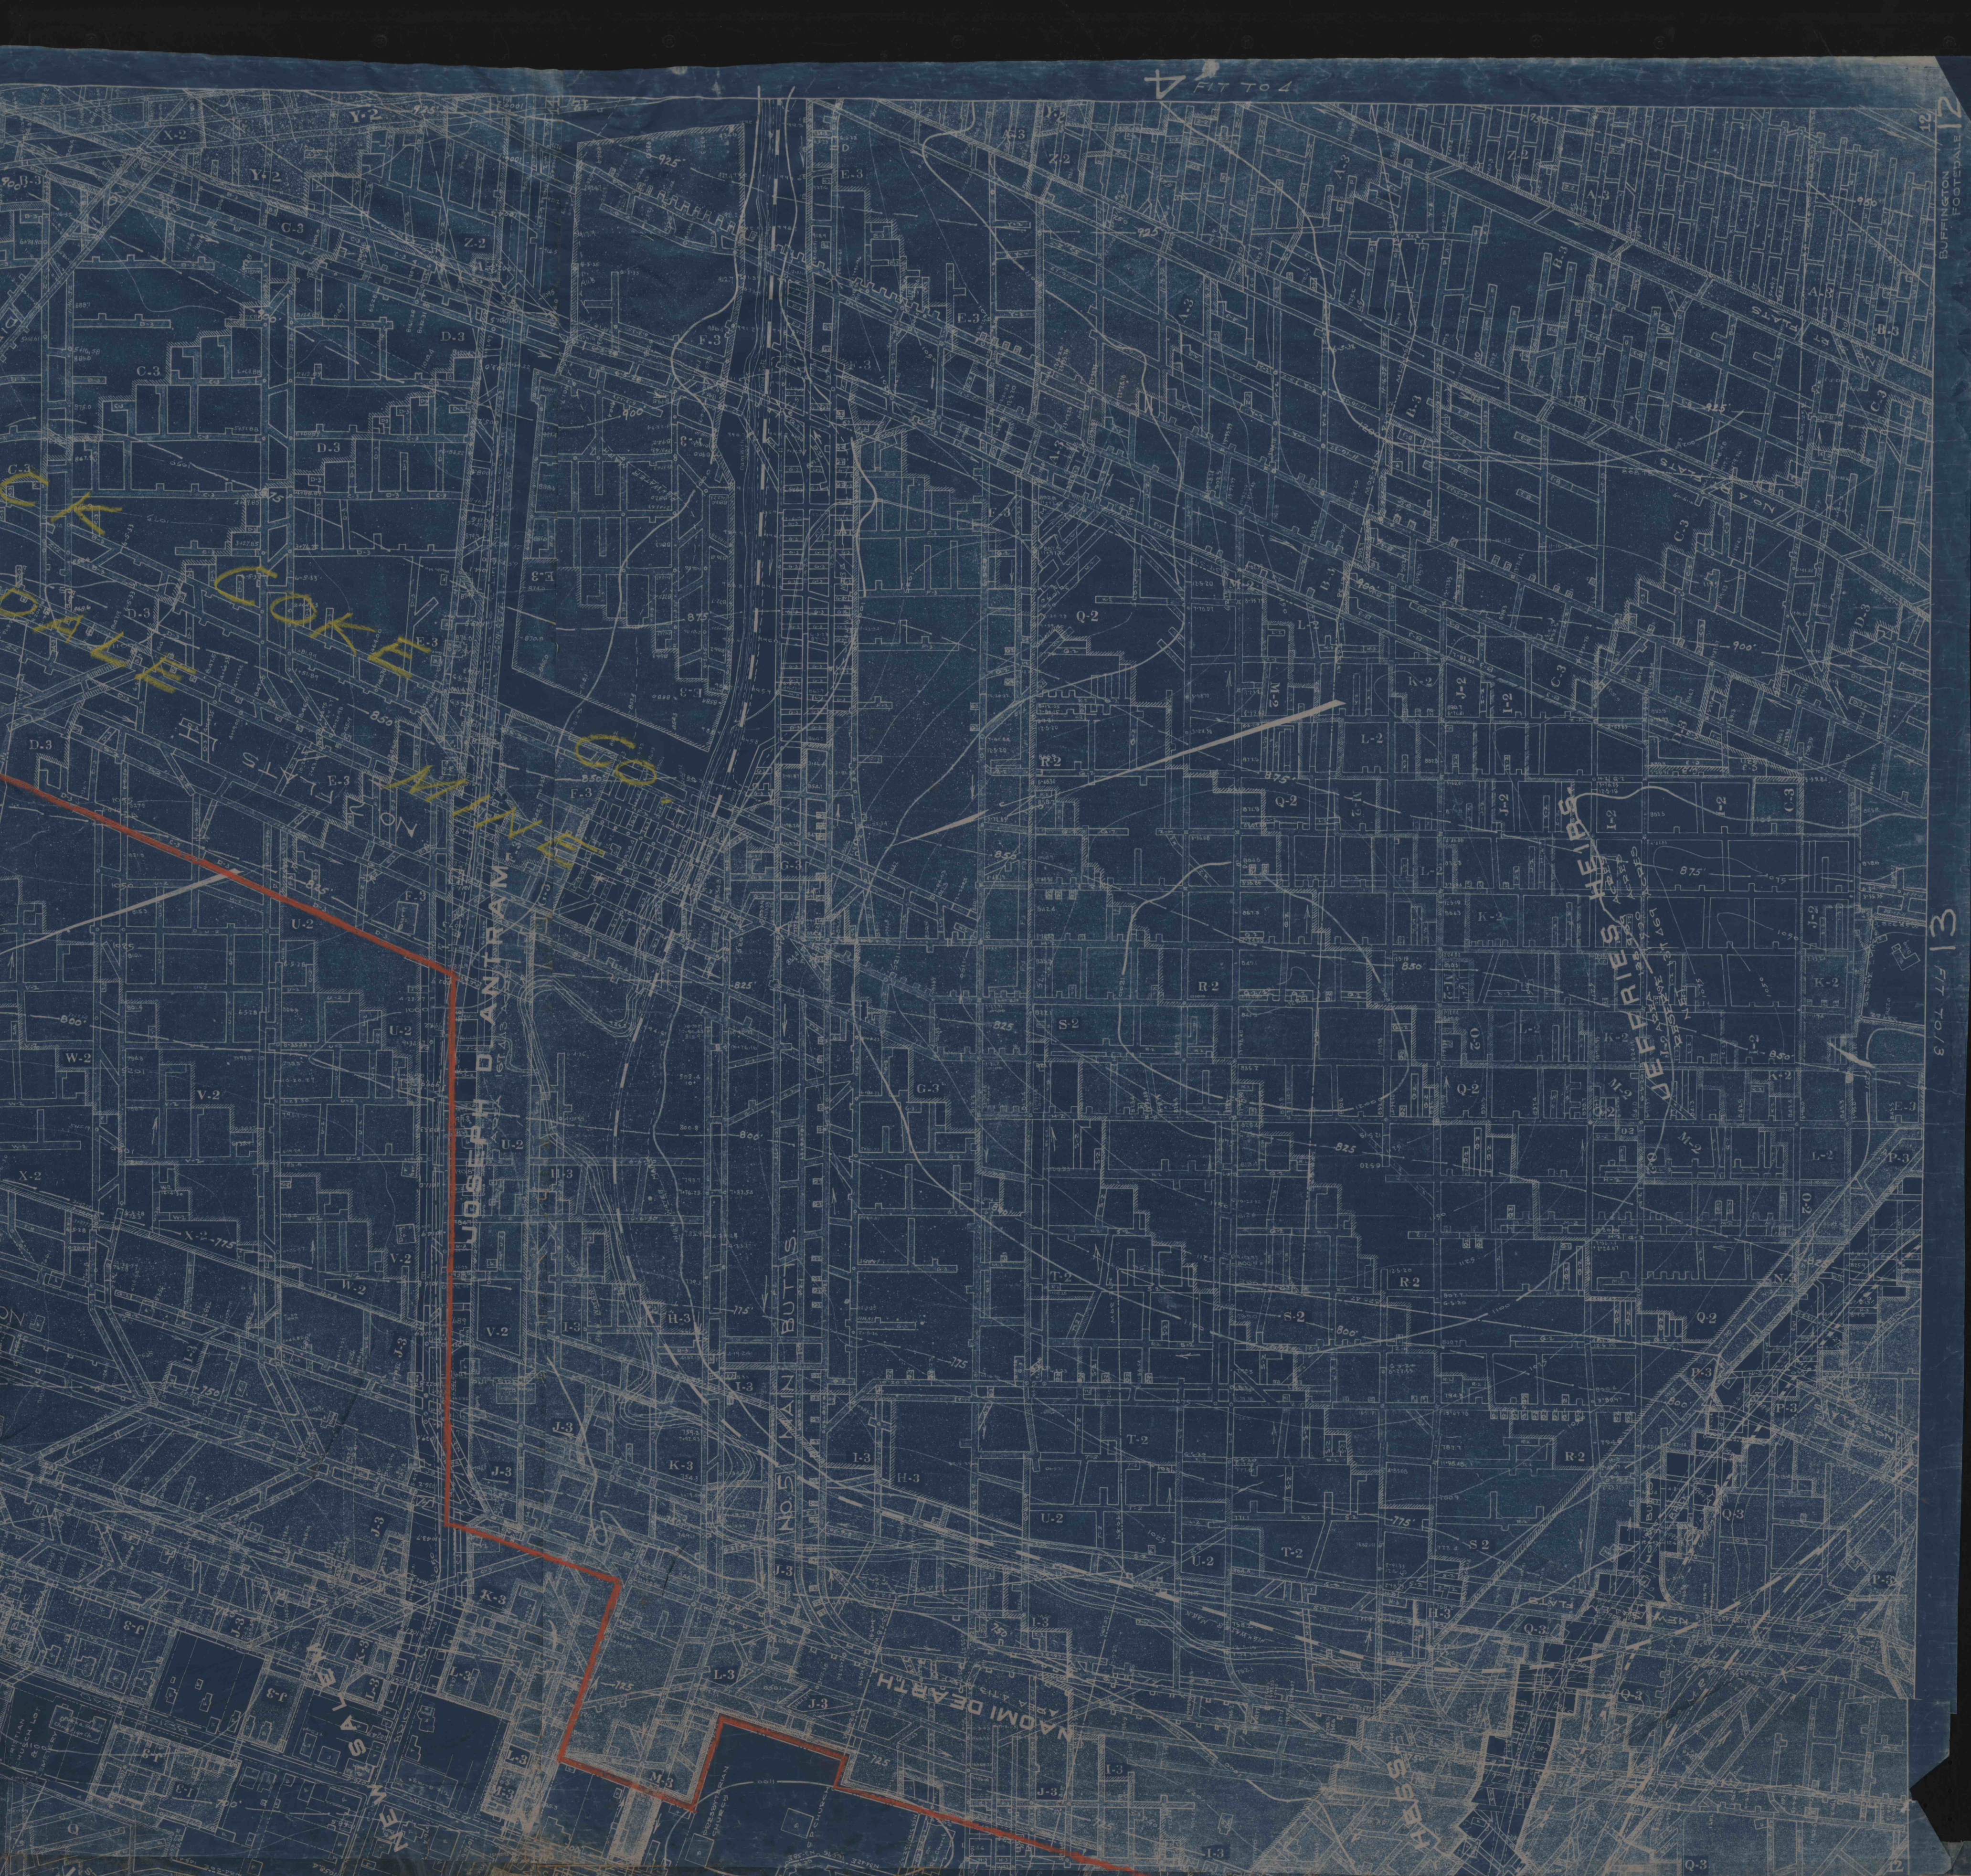

3



4

30