


Fit to 4

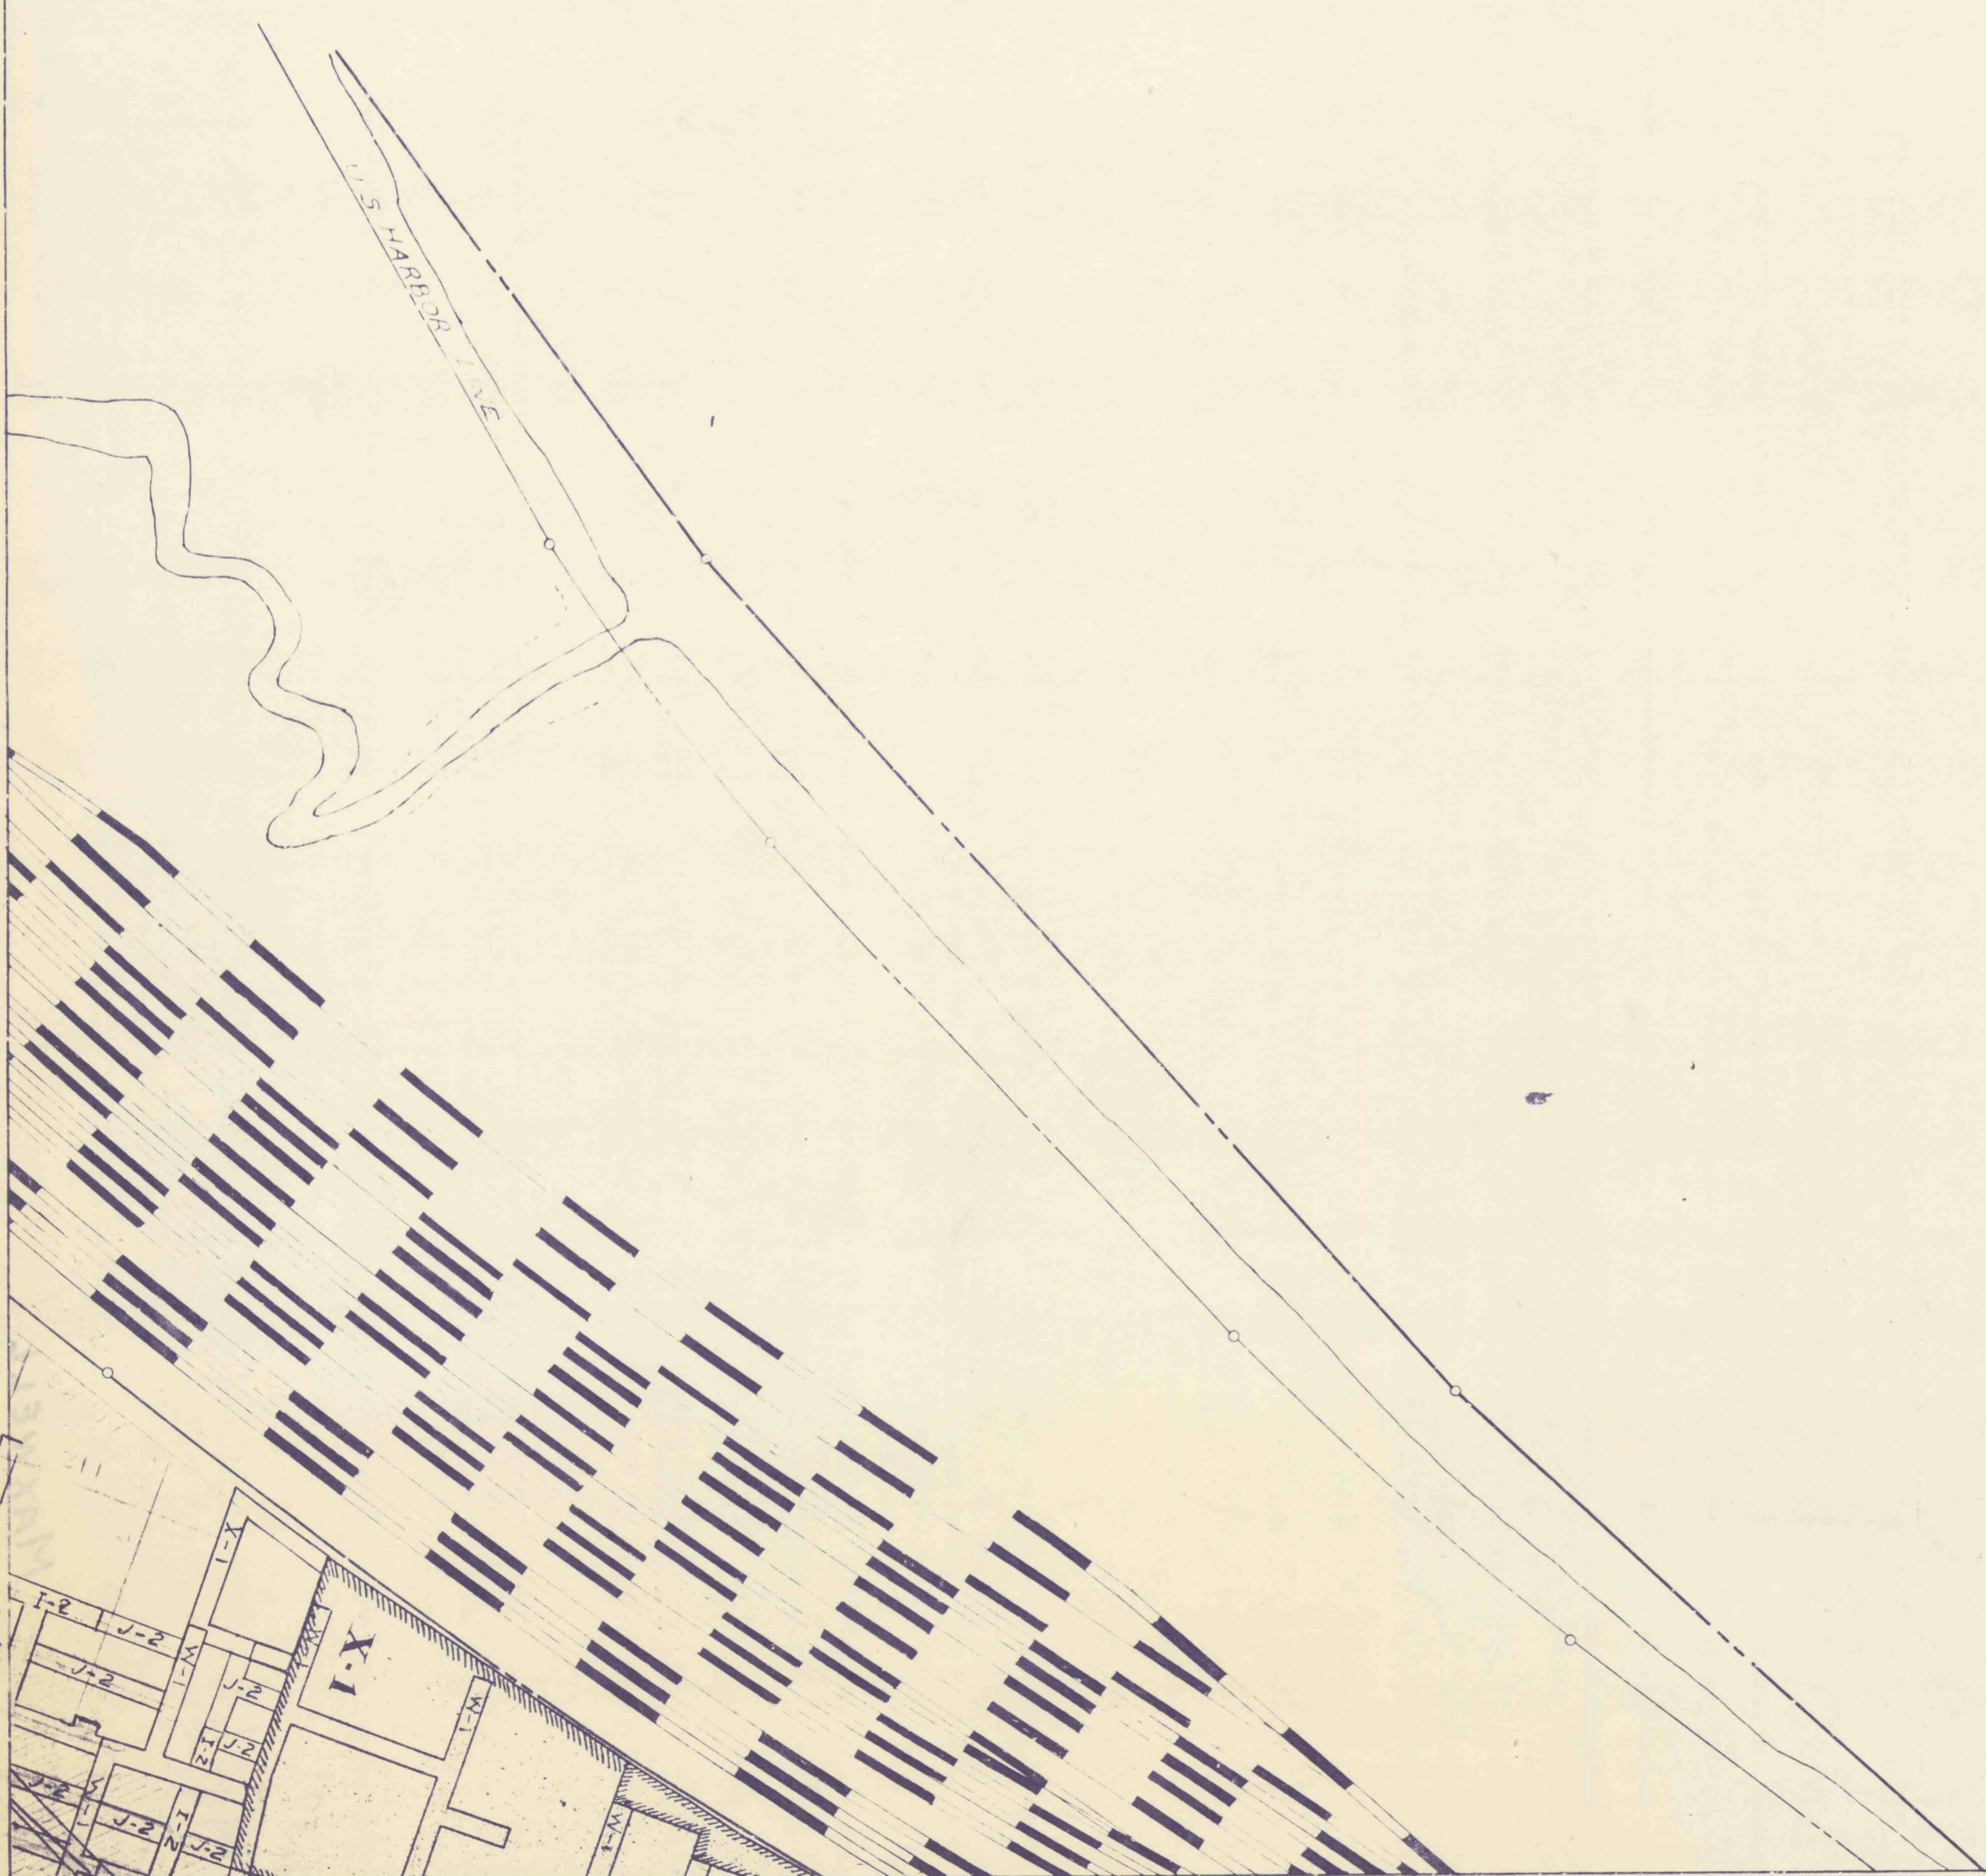

Maxwell

17

Fit to 9