


LABELLE COAL & COKE COMPANY

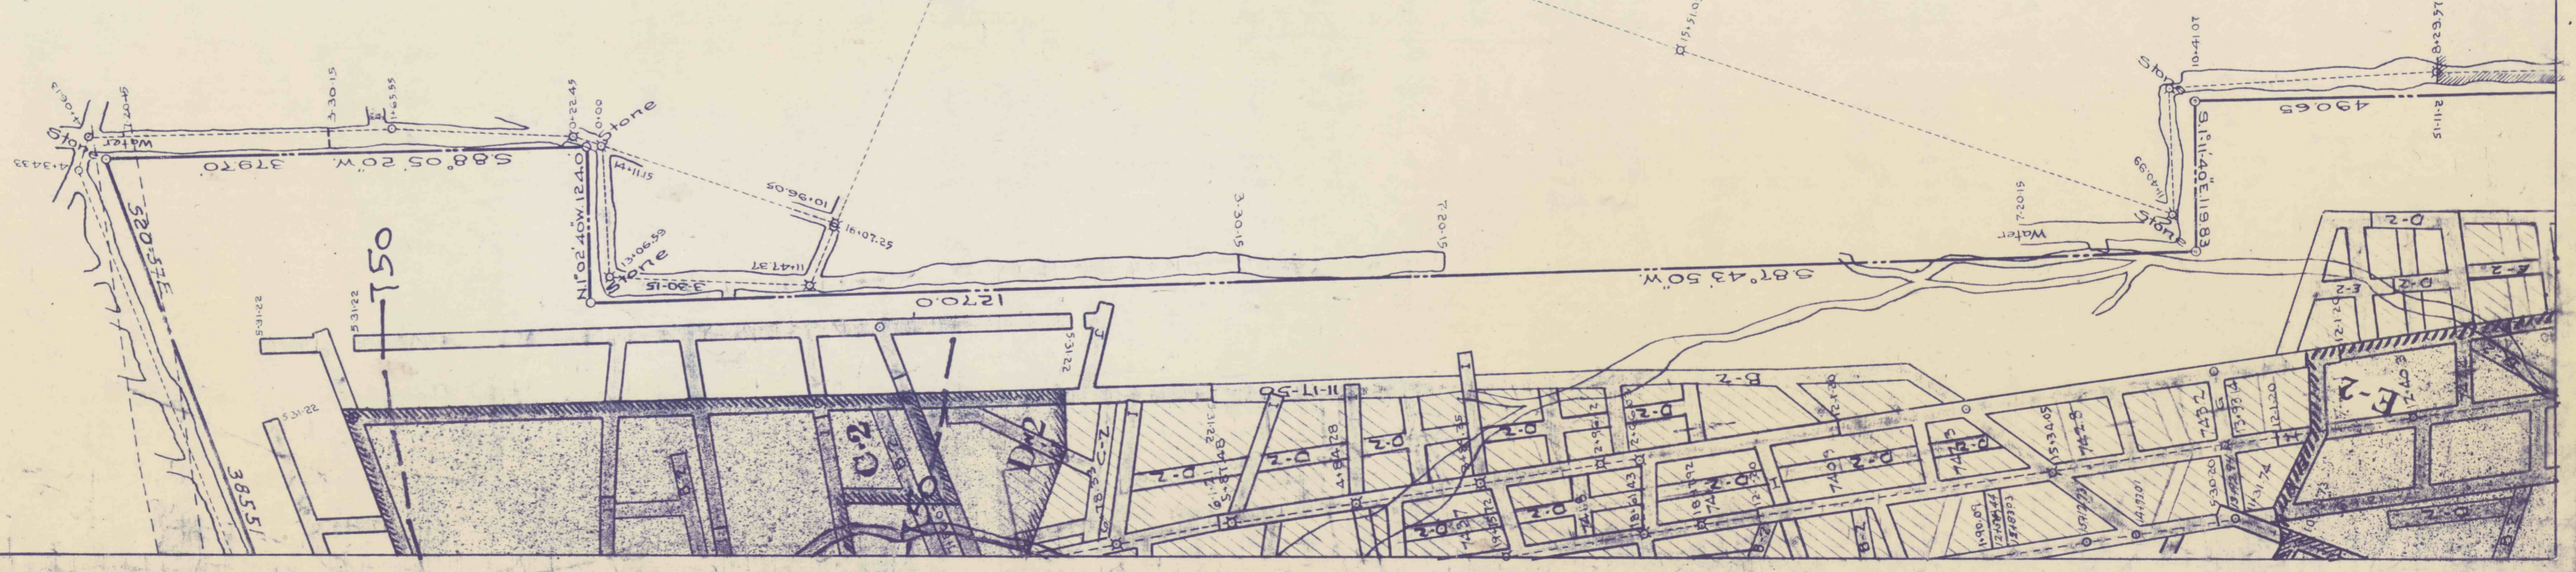

FIT TO 7

FIT TO 3