






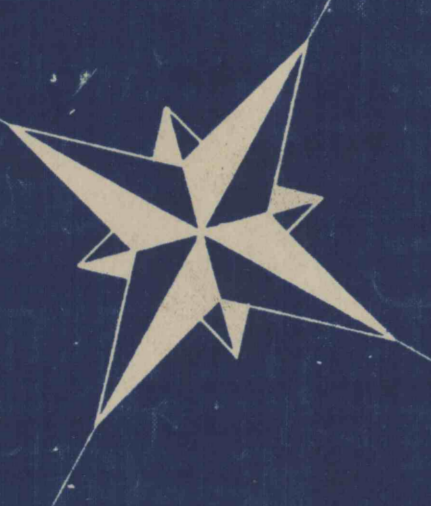

**ALLEGHENY COUNTY**  
**HOSPITAL FOR THE INSANE**  
**WOODVILLE**  
**MINE MAP**  
 SCALE 100 FEET TO 1 INCH  
 COUNTY ENGINEERS' OFFICE  
 COURTHOUSE PITTSBURGH PA