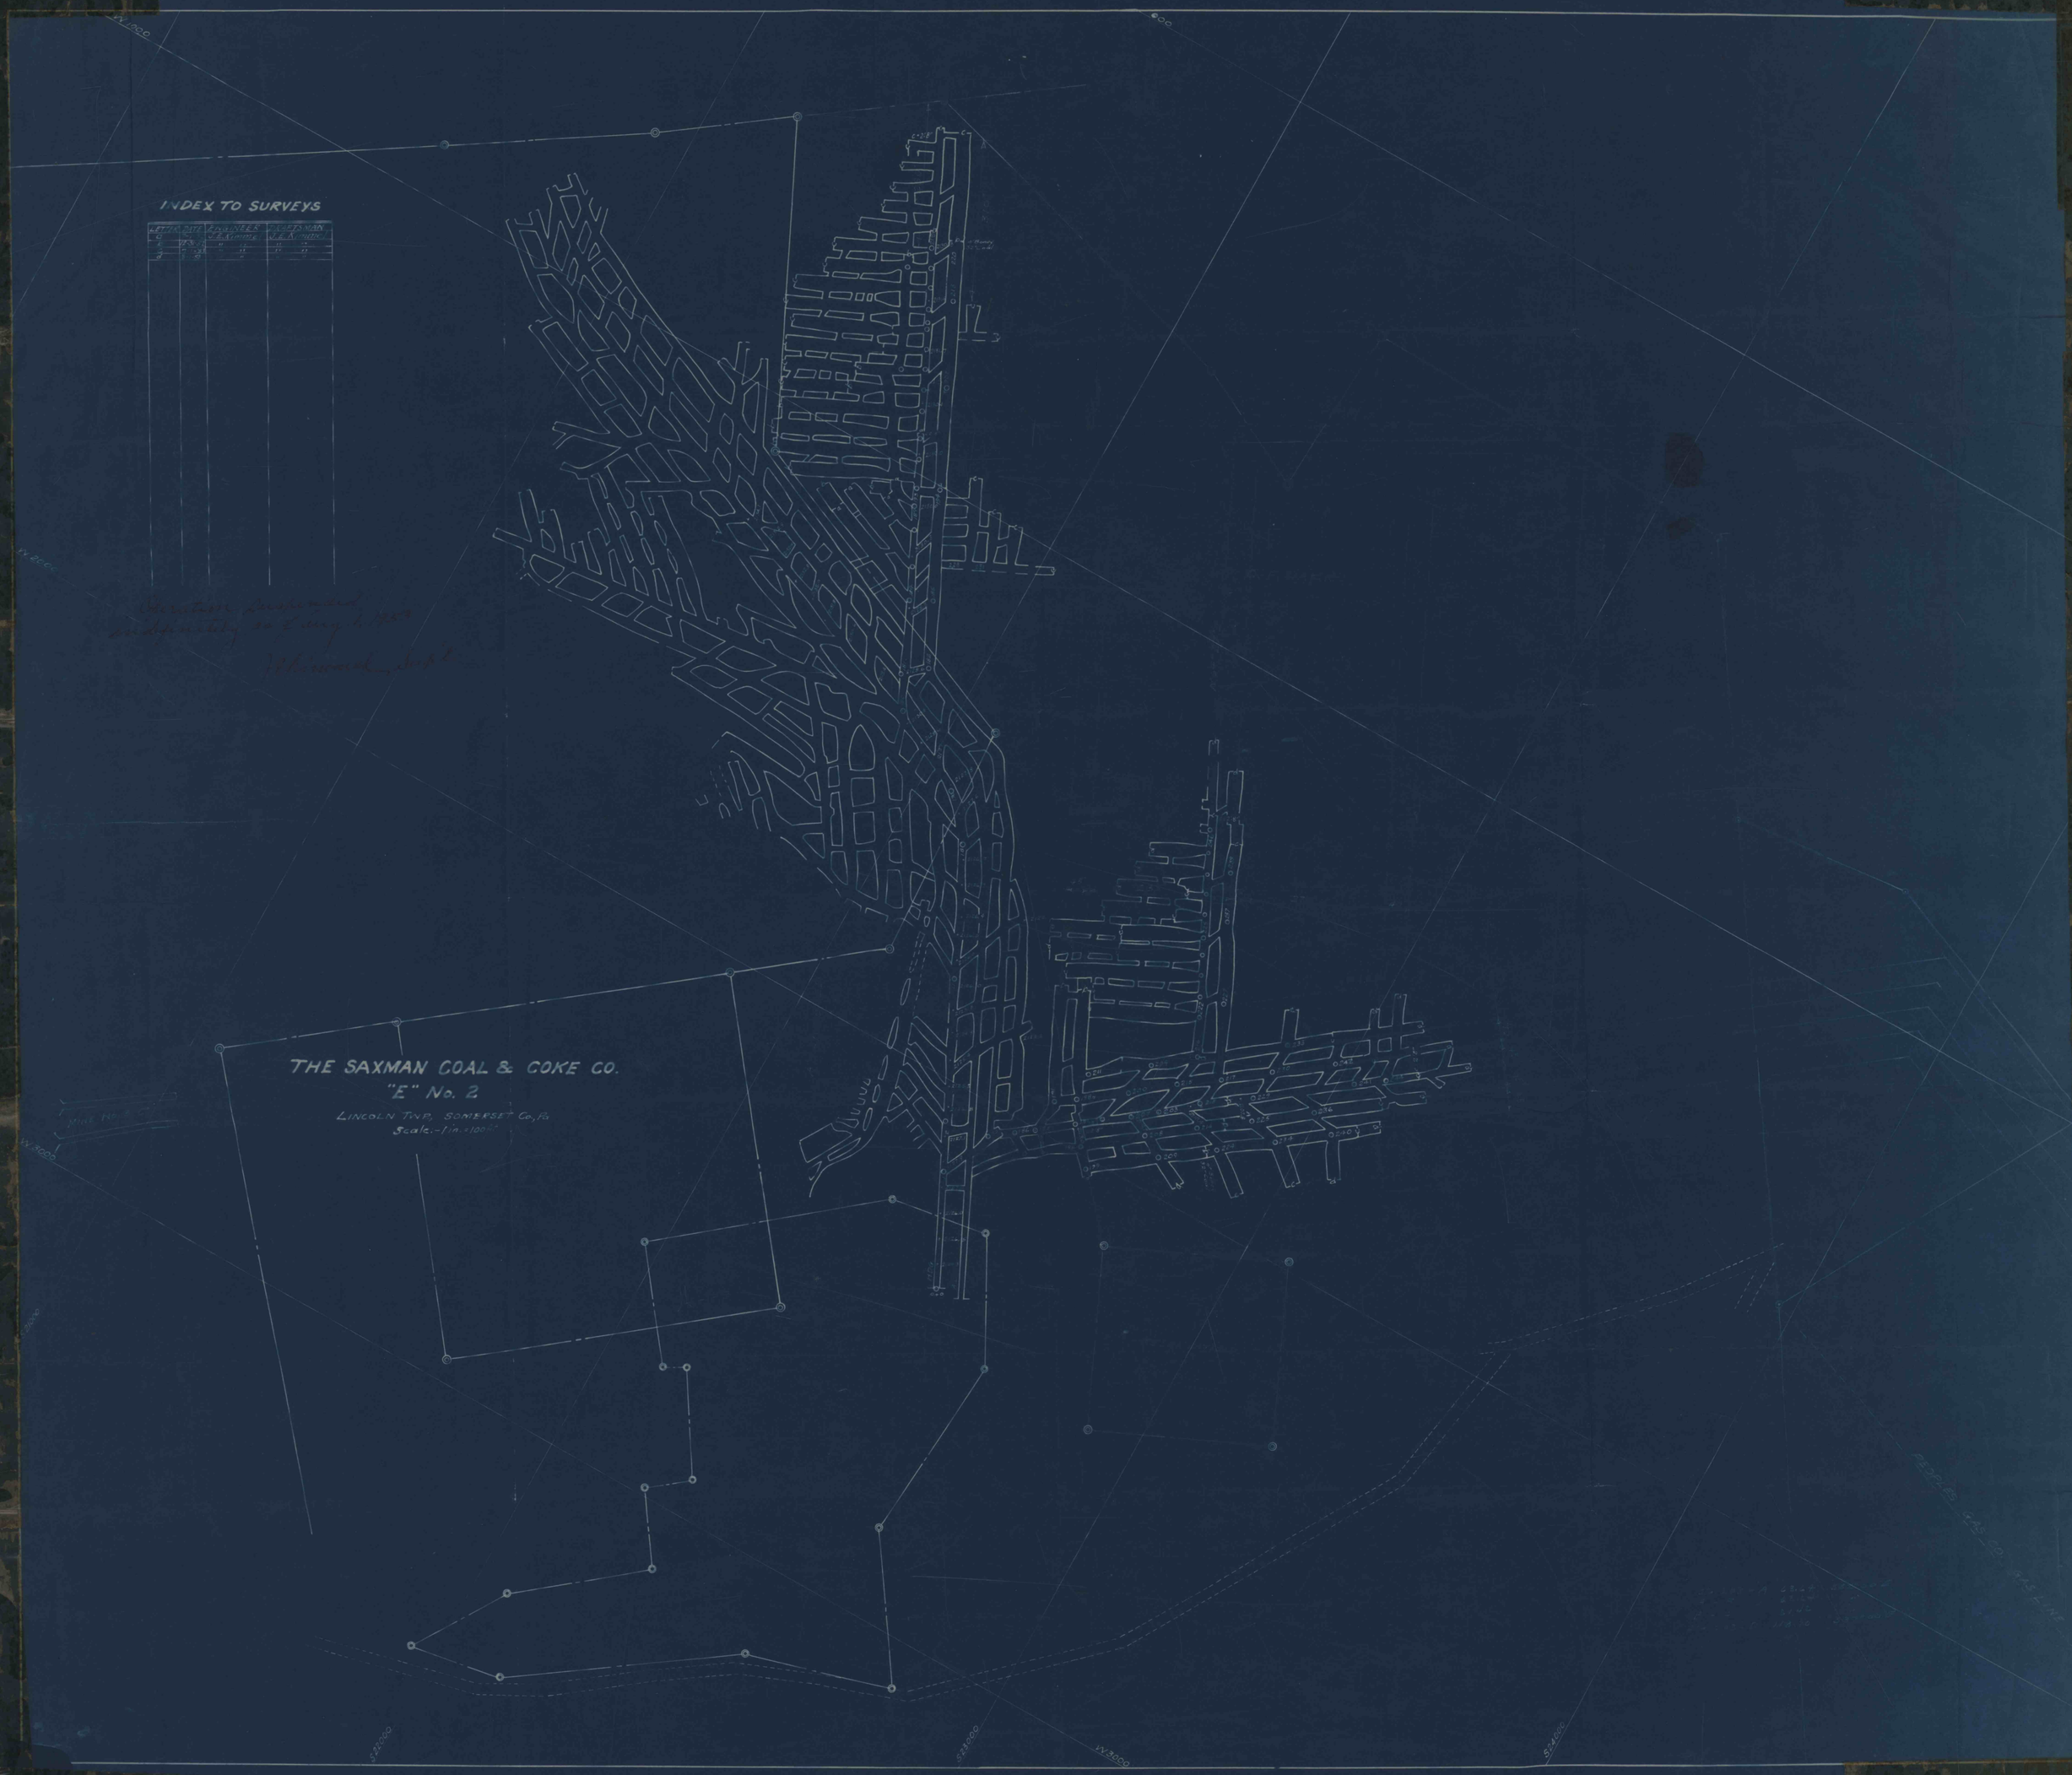
INDEX TO SURVEYS
LETTER DATE ENGINEER DRAFTSMAN
Operation suspended indefinitely as of Aug 1, 1950
THE SAXMAN COAL & COKE CO.
"E" No. 2
LINCOLN TWP, SOMERSET Co., Pa
Scale:-1 in.=100 ft.
W 1000
W 2000
W 3000
S 22000
S 23000
S 24000