

— MEYERSDALE FUEL COMPANY —

— MAP OF YODER N<sup>o</sup>. 5 —

— RED STONE OVER N<sup>o</sup>6 OPENING —


— ELK-LICK TWP., SOMERSET CO. PA. —

SCALE 1 in. = 100 feet

DECEMBER 1919.

J.J. Hobbitsch, Jr.  
Civil & Mining Engineer

CONSOLIDATION COAL CO.

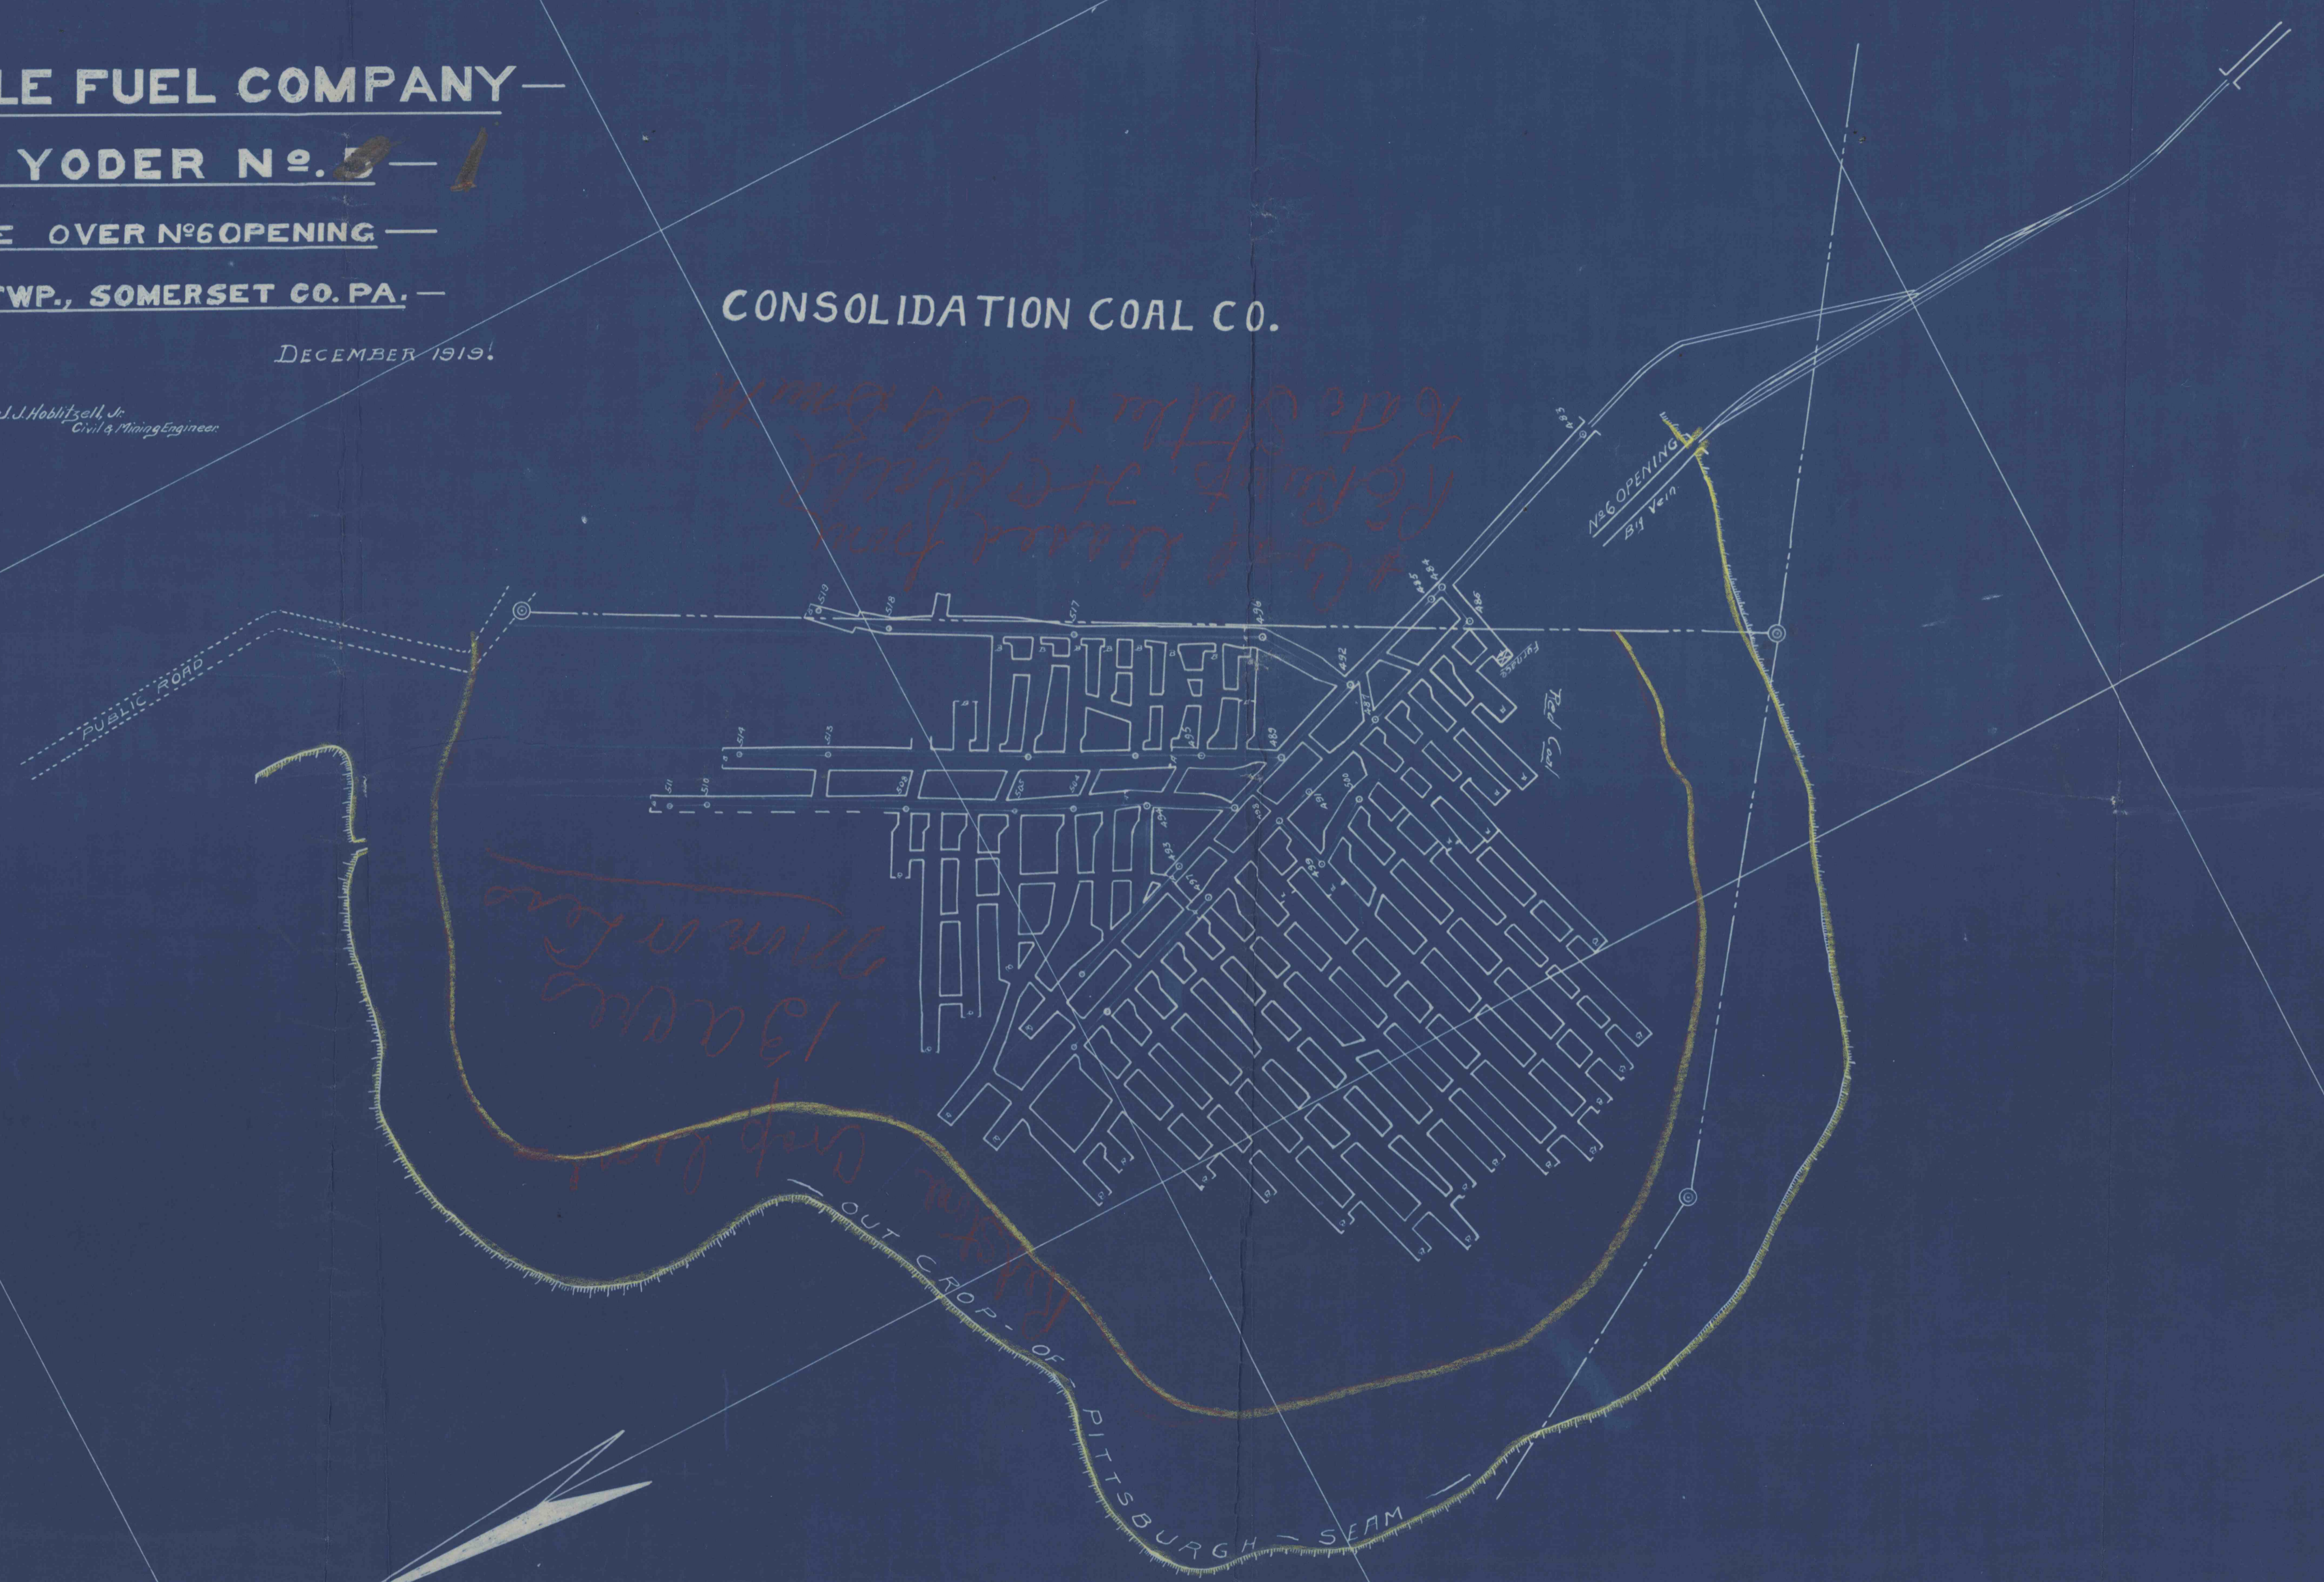

INDEX

Letter	Date	Survey by
A	Dec 1919	EC. Hostetter
B	Sept 1920	" "