

SARAH I. PIFER surface
ALLEGHENY RIVER MINING
COMPANY - minerals

THOMAS V. KANTER
M.A.S. P.E.
ALLEGHENY RIVER MINING
COMPANY - minerals

SARAH I. PIFER surface
(72)
ALLEGHENY RIVER MINING
COMPANY - minerals

ABANDONED SURFACE MINE
OPERATOR UNKNOWN
UPPER & LOWER FREEPORT REMOVAL
/ 1183.2


THE PERIPHERY OF I-RIGHT IS PRESHIFTED.

W.E.
1137.4

DECKER # 5

12
EL. 1231.37

13 B
EL. 1231.04

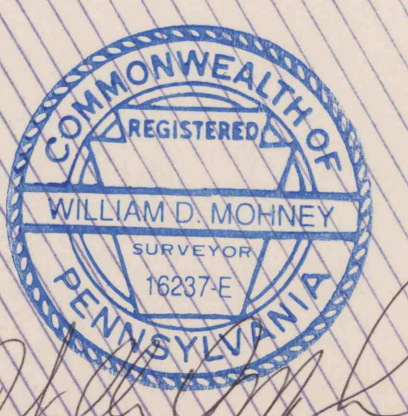

(UPPER FREEPORT COAL SEAM)

HAYS RUN COAL COMPANY, INC.
SPACES CORNERS MINE
RAYBURN AND VALLEY TWP., ARMSTRONG CO., PA

SCALE 1" = 100'