



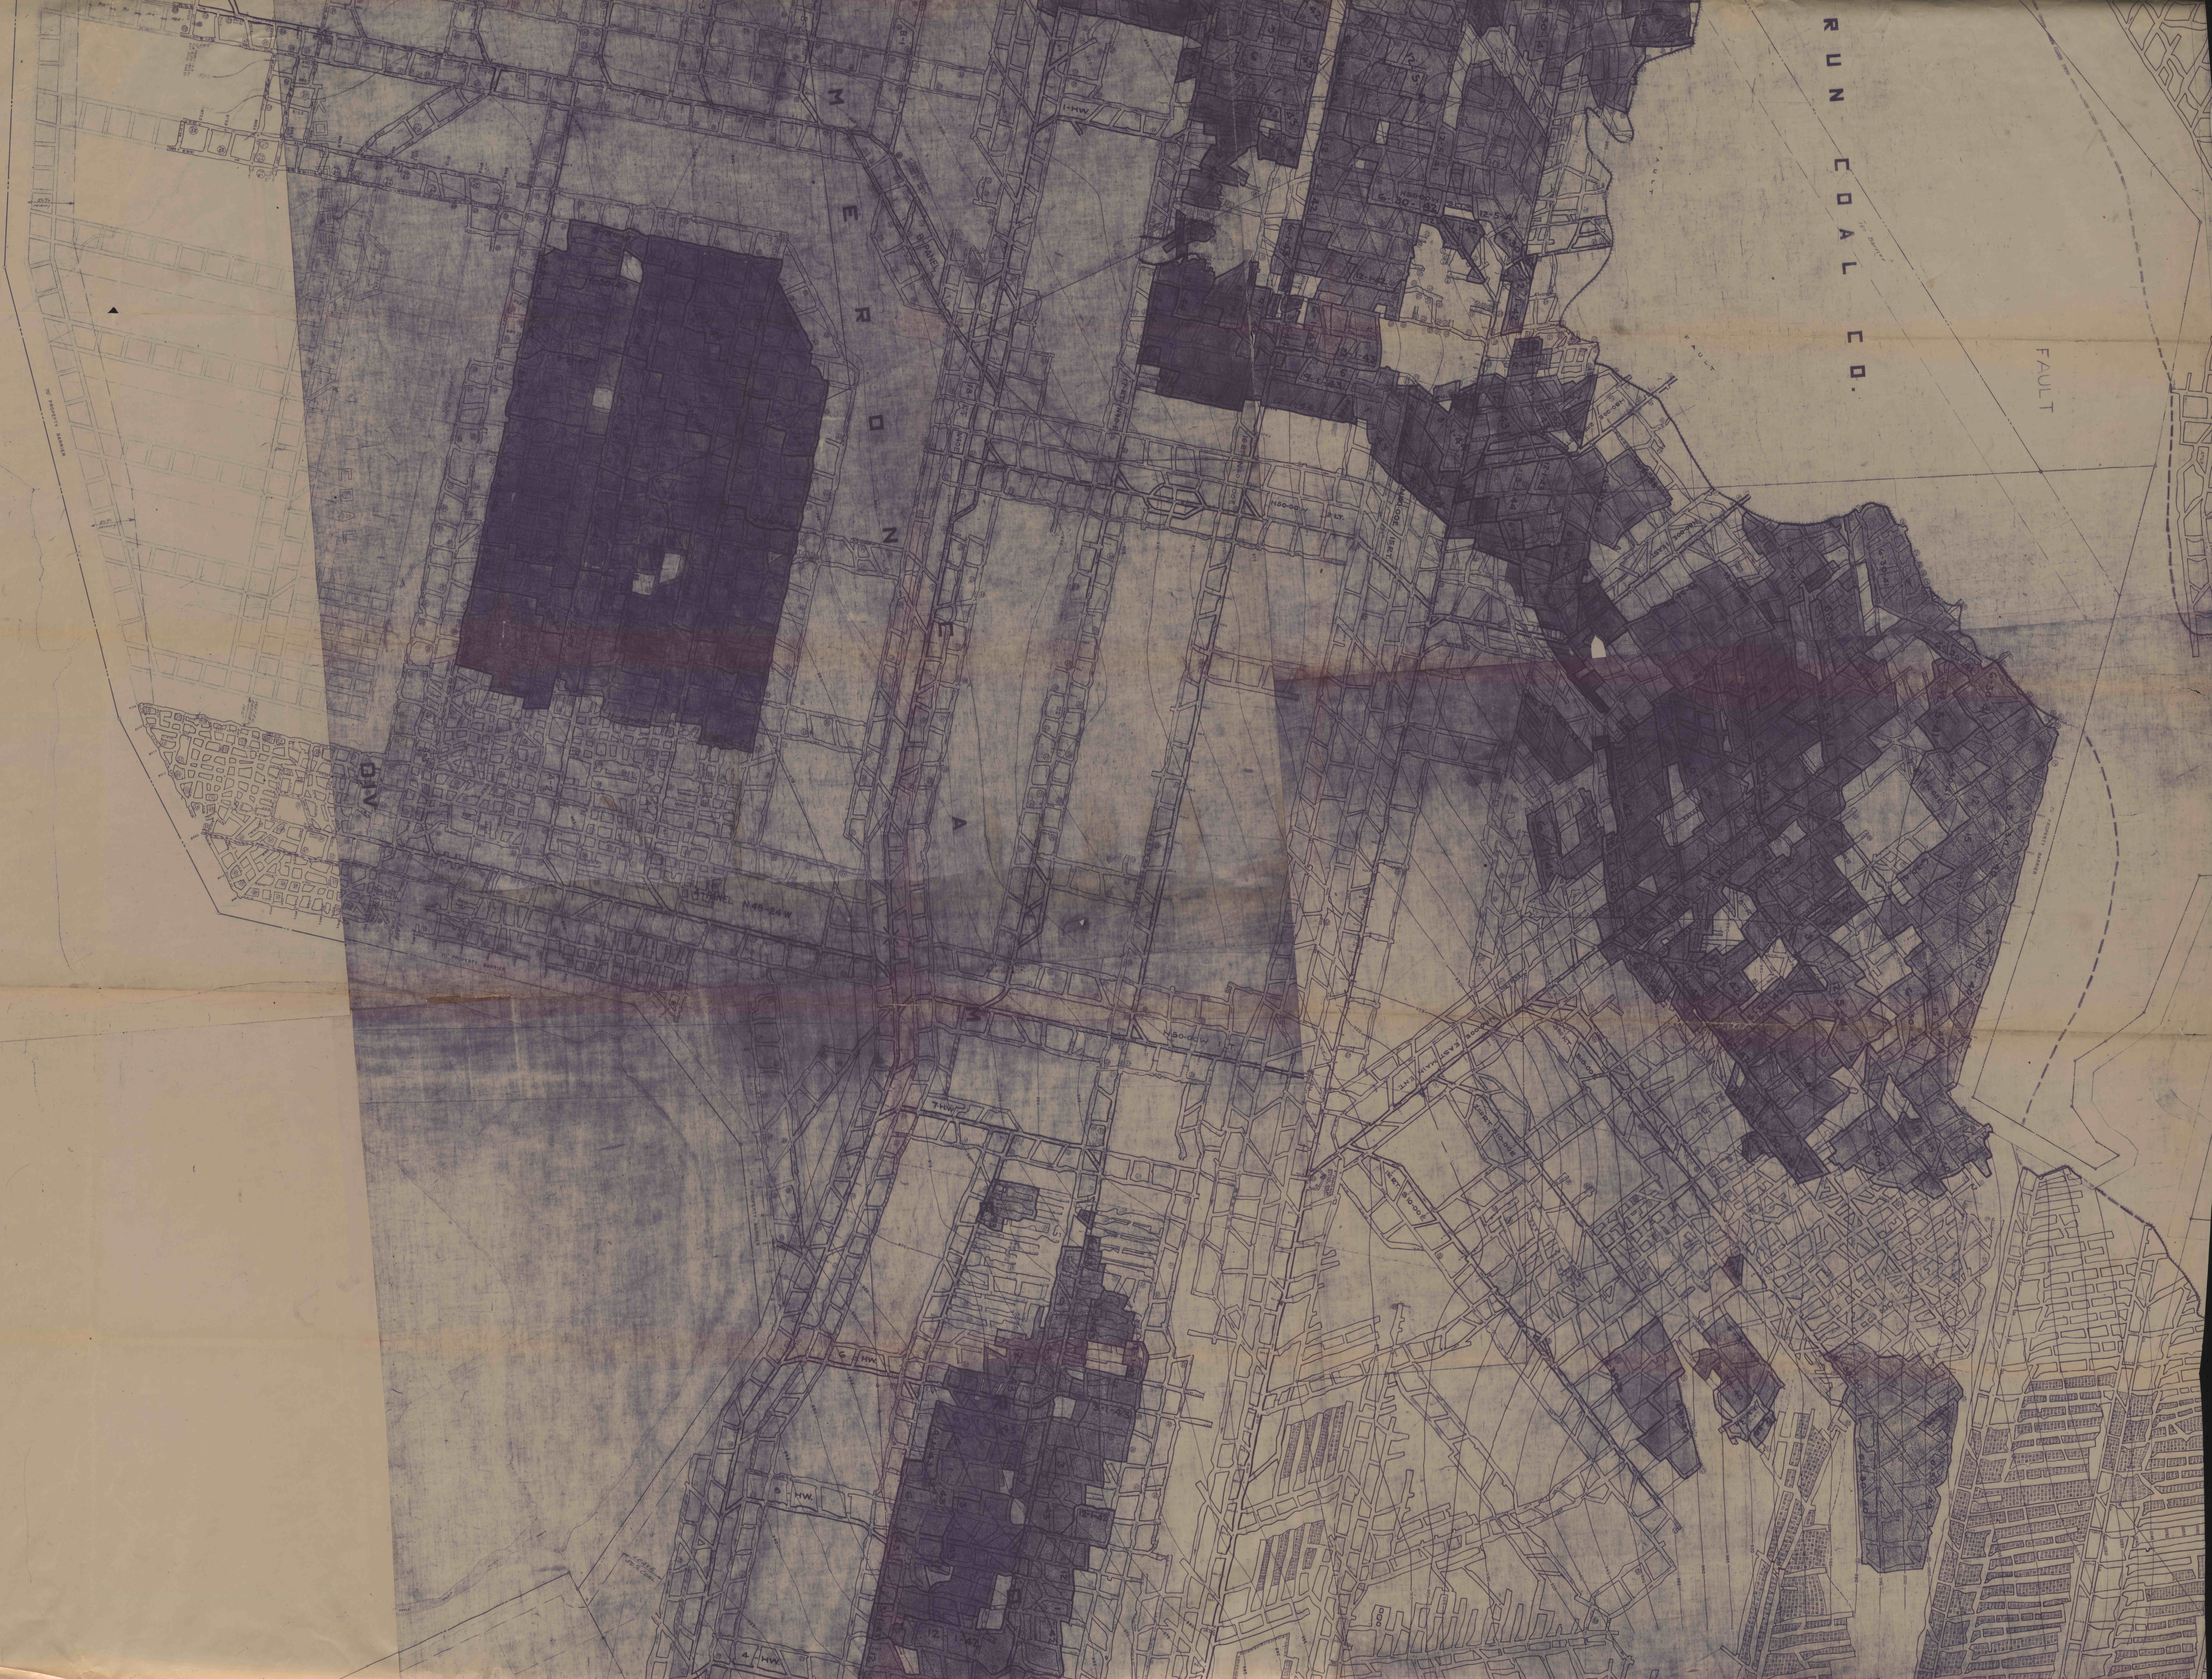


FAULT