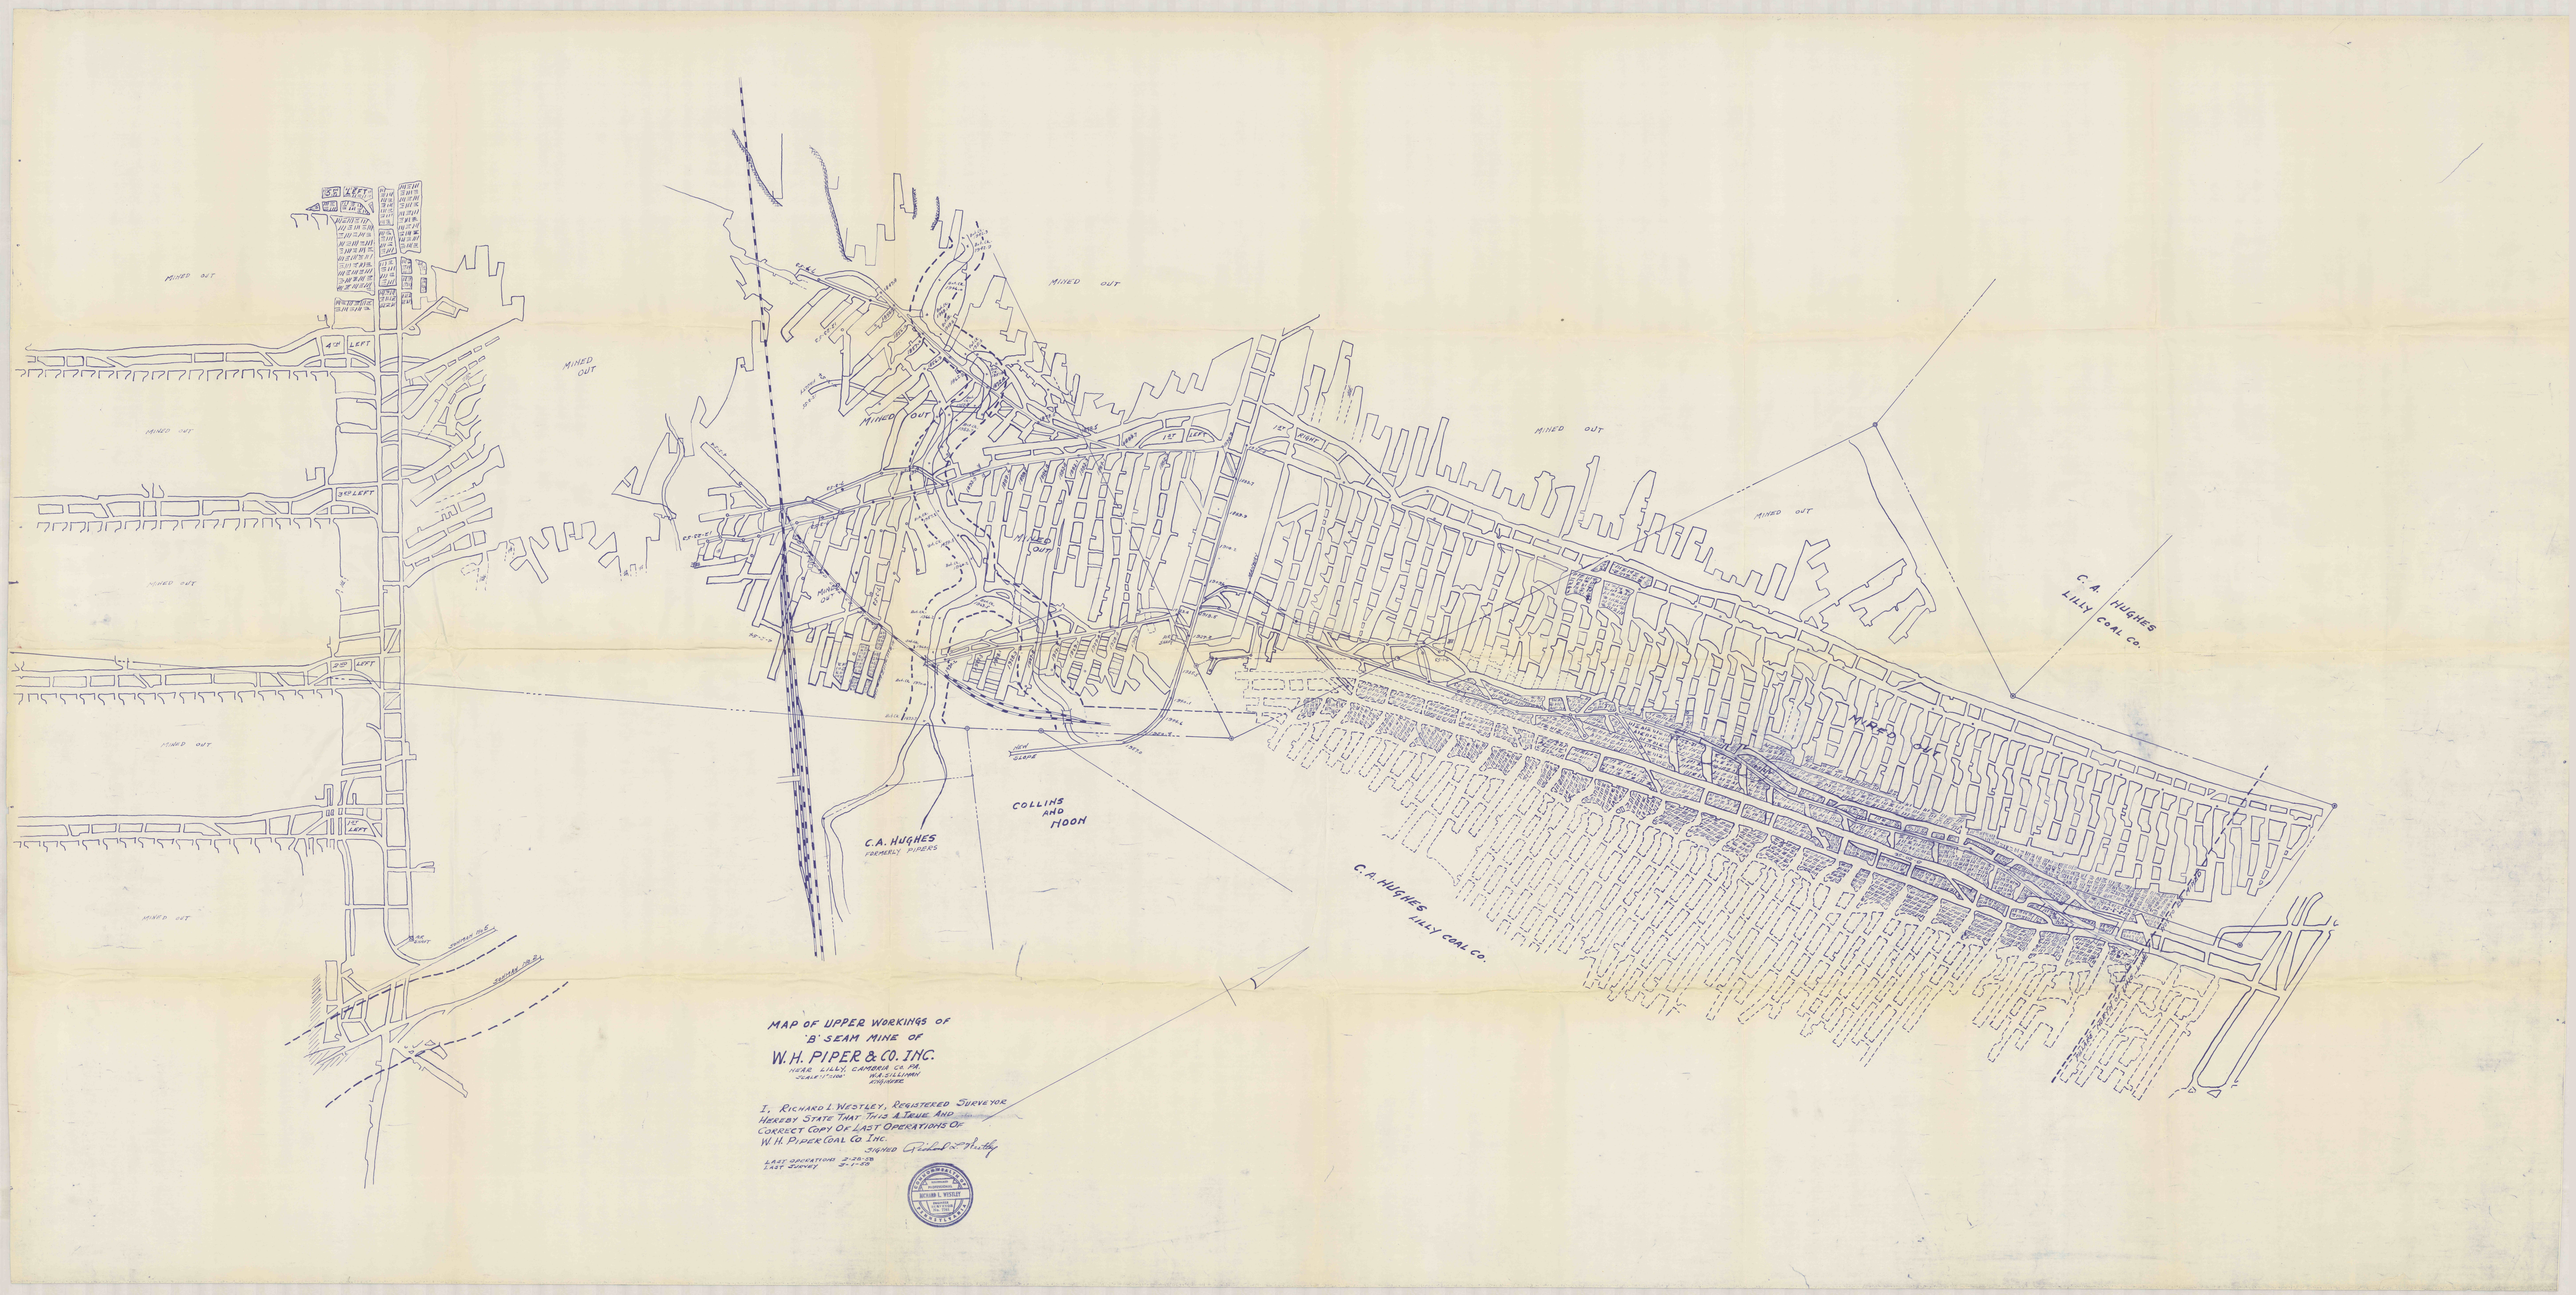
MINED OUT
4TH LEFT
3RD LEFT
2ND LEFT
1ST LEFT
1ST RIGHT
C.A. HUGHES
FORMERLY PIPERS
COLLINS AND MOON
C.A. HUGHES
LILLY COAL CO.
C.A. HUGHES
LILLY COAL CO.
MAP OF UPPER WORKINGS OF
'B' SEAM MINE OF
W.H. PIPER & CO. INC.
NEAR LILLY, CAMBRIA CO. PA.
SCALE 1"=100'
R.A. SULLIVAN
ENGINEER
I, RICHARD L. WESTLEY, REGISTERED SURVEYOR
HEREBY STATE THAT THIS IS A TRUE AND
CORRECT COPY OF LAST OPERATIONS OF
W.H. PIPER COAL CO. INC.
SIGNED
LAST OPERATIONS 2-28-58
LAST SURVEY 2-1-58
RICHARD L. WESTLEY