
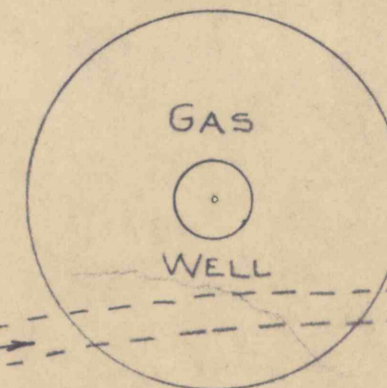


EARL M. REED COAL CO.

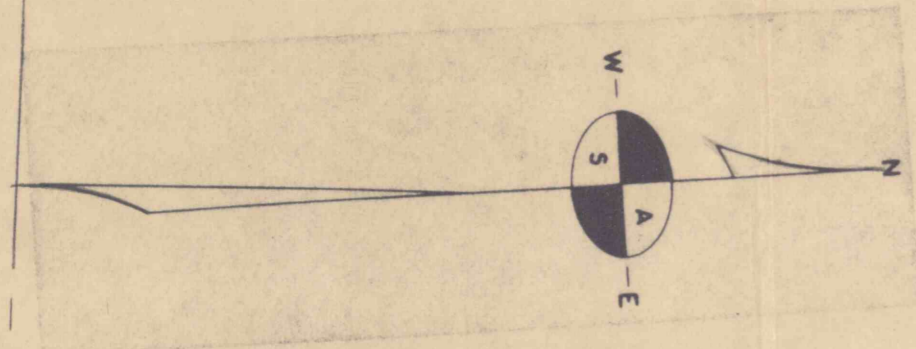

FREEBROOK CORP.

TO RT # 030826

TWP. ROAD # 7860

TO NEW SALEM

CAVES, WATER AND BAD ROOF

DAVID G. BEST ET. AL.

CONCAVE MASONRY SEALS

HIGHWALL

TOE

OF

SPOIL

TOE

OF

WILLIAM M. GEIST

REVISED 6/15/65

COMPLETION REPORT
MCWILLIAMS COAL MINE
HAWK BROS. INCORPORATED
REDBANK TWP, ARMSTRONG CO., PA.

R. B. SHANNON & ASSOCIATES, KITTANNING, PA.
DRAWN BY RLM DATE JAN. 1965
SCALE 1" = 100' DRAWING No. C-503