

Matthew Shedeck's
Mine Near
Karthaus Pa.




scale = 1" = 100ft
I.M. Kelley

Property of
Mosquito Creek Coal Co.

Proposed Mosquito
Creek


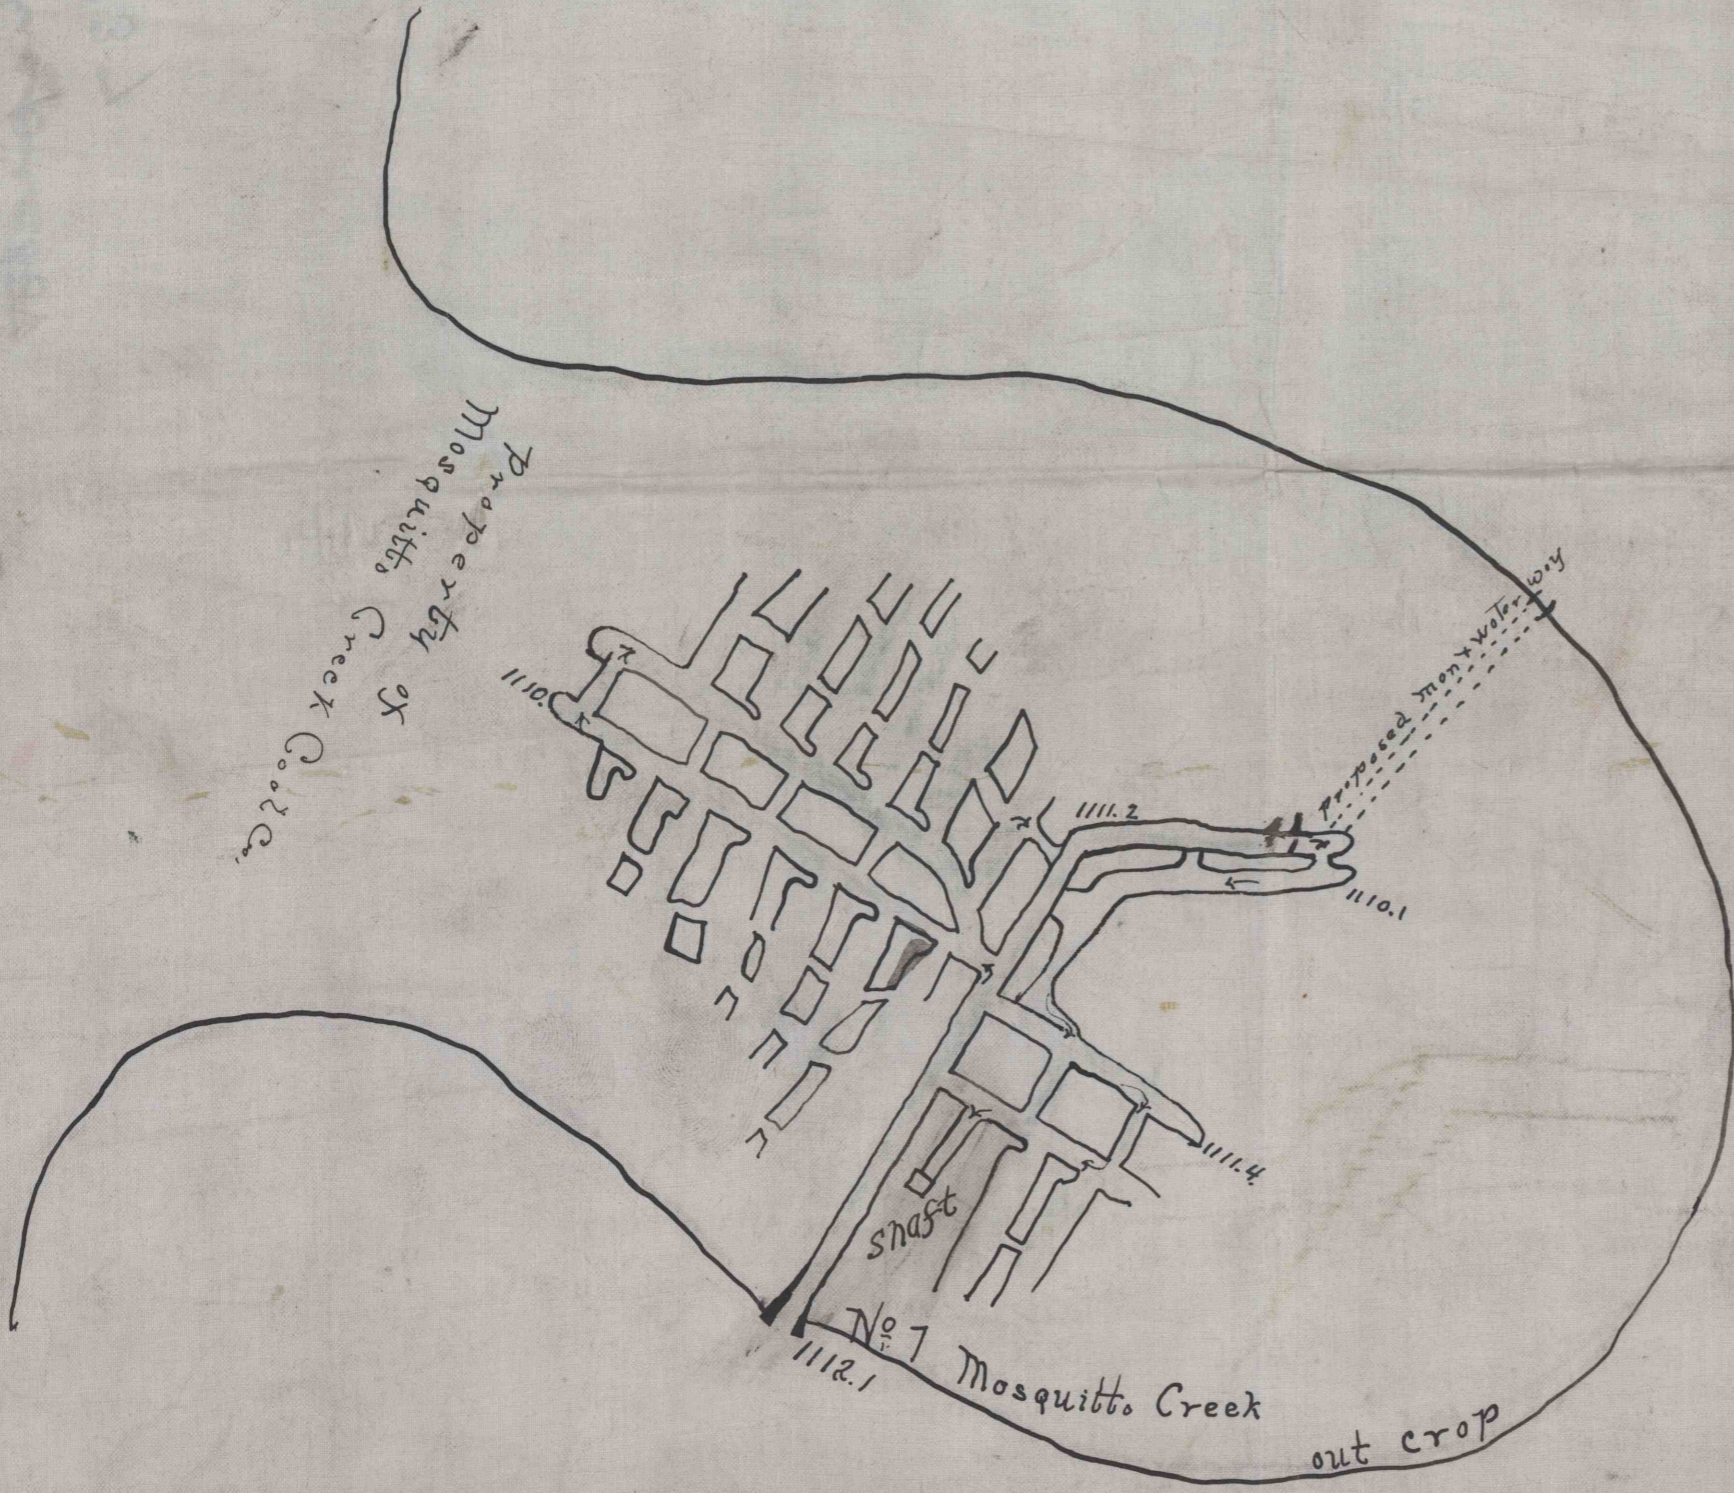

No. 7 Mosquito Creek
out crop