


PLAN

SCALE: 1" = 100'

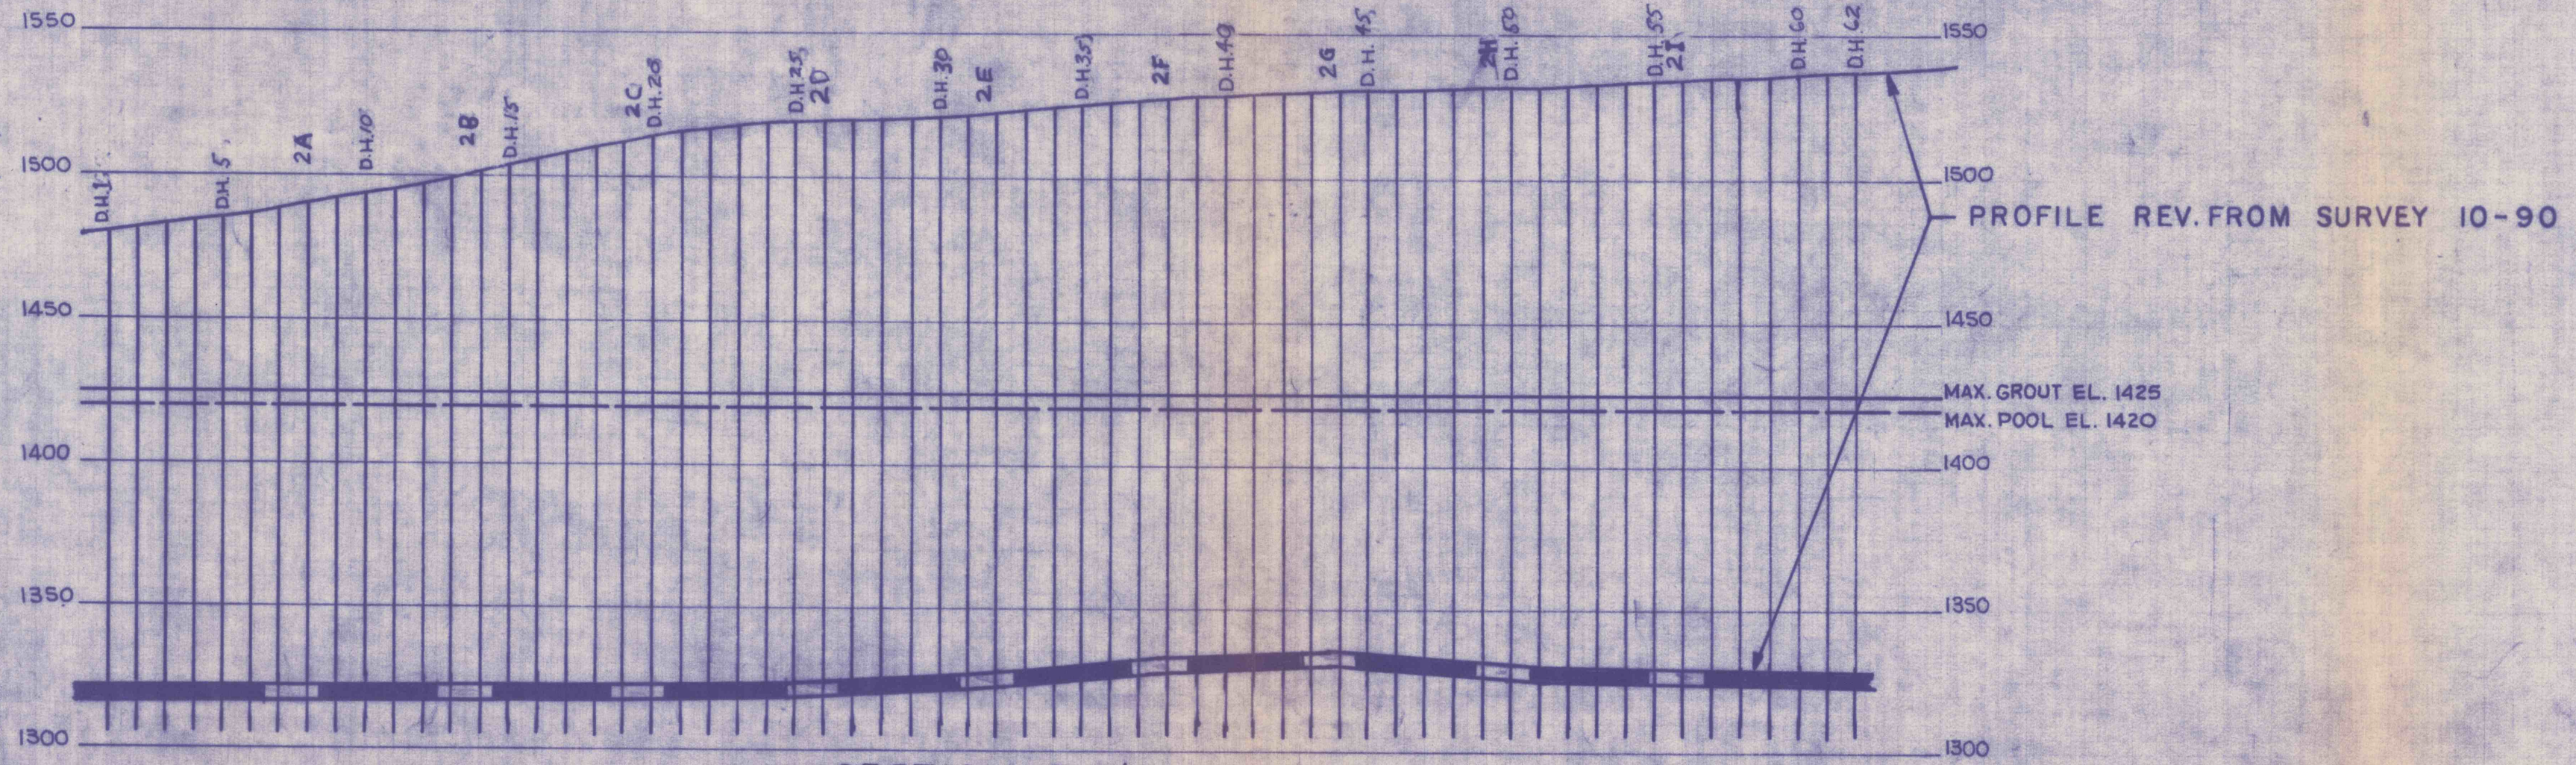

SECTION E-E'  
SCALE: 1" = 50' HOR.  
1" = 50' VER.

**RECEIVED**  
FEB 12 1991  
Dept. of Environmental Resources  
McMurry District Office

ISSUED	MINE SEAL AREA NO 2	SCALE AS SHOWN
<b>MINE CLOSURE PLAN</b> <b>RUSHTON MINING COMPANY</b> RUSH TWP, CENTRE CO., & DECATUR TWP, CLEARFIELD CO., PA.		
JOB B	GWIN, DOBSON & FOREMAN, INC. CONSULTING ENGINEERS ALTOONA, PENNSYLVANIA	SHEET 24 of 36 EXHIBIT C-9
FILE	DRAWN BY: [Signature]	CHECKED: