


REVISIONS			UPDATES		
BY	BRIEF	DATE	BY	BRIEF	DATE
KLM	PROJECTIONS	5/23/90			
KLM	PROJ. REV.	5/29/90			
PKP	FACE UPDATE	3/14/91			
WLP	FACE UPDATE	4/10/91			
WLP	FACE UPDATE	6/2/91			
TJT	VENTILATION ADD.	9/20/91			
PKP	FACE UPDATE	12/9/91			
PKP	FINAL MAP	3/24/92			

Robert L. Garbart

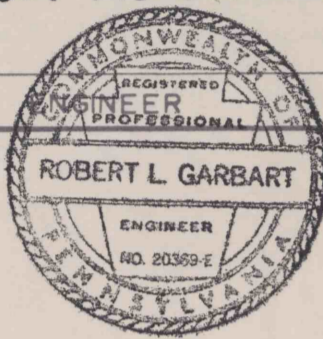

*A-692 Blotnik*

PERMANENT MONUMENT INFORMATION

- NO. 59 N 44,925.7185  
E 96,747.5662  
EL. 1076.22
- NO. 60 N 44,543.3569  
E 96,501.6562  
EL. 1099.19'
- NO. 61 N 44,702.4943  
E 96,725.1379  
EL. 1115.35'

NOTE: STARVAGGI INDUSTRIES, INC. IS THE OWNER OF ALL THE PITTSBURGH SEAM WITHIN OR CONTIGUOUS TO THE PROPOSED PERMIT AREA.

LEGEND

- PERMIT LINE / SUBSIDENCE CONTROL
- 6 MONTH PROJECTION LIMITS
- INTAKE
- RETURN
- BLEEDER
- PERMANENT STOPPING
- REGULATOR
- BOXCHECK
- MANDOOR
- OVERCAST
- CHECK CURTAIN
- FRAMED CHECK CURTAIN
- LOADING POINT
- BELT
- PRIMARY ESCAPEWAY
- SECONDARY ESCAPEWAY
- SURVEY STATION
- COAL CONTOUR
- SUPPORT BLOCK (50% MINING)
- PILLARED AREA
- STRUCTURE INVENTORY NUMBER
- PRE-1966 STRUCTURE
- BELT OVER TRACK
- DOOR
- COMPLETED OVERCAST
- ROCK FAULT
- PERMANENT MONUMENT
- SEAL
- CRIB BLOCKS
- AVERAGE ENTRY WIDTH - 18'

PROPERTY OWNERS

- ③ WEIRTON ICE & COAL SUPPLY CO.
- ⑪ PENNWEIR CONSTRUCTION COMPANY
- ⑬ PENNWEIR CONSTRUCTION COMPANY
- ⑮ BERNADINE C. MANCINELLI  
c/o STEVE MACUGOSKI
- ⑯ CHARLES A. & CHERLYN IVANAC  
c/o EQUIBANK MRTG. SERVICE
- ⑰ DANIEL & MARY ORENCHUK
- ⑱ PENNWEIR CONSTRUCTION COMPANY

MAIN FAN DATA:

MANUFACTURER: JEFFERY MANUFACTURING CO.  
 TYPE: AERODYNE  
 SIZE: 5 FEET DIAMETER  
 SPEED: 900 R.P.M. BELT DRIVEN  
 WATER GAUGE:  
 QUANTITY OF AIR:  
 PRESENT BLADE SETTING: SOLID BLADES

MOTOR DATA:

MANUFACTURER: U.S. ELECTRIC MOTORS, INC.  
 TYPE: A.C.  
 HORSEPOWER: 50 H.P.  
 VOLTAGE: 480 V.  
 AMPERE RATING: 52 AMP

MORGAN ENERGY COMPANY

P.O. BOX 292  
WASHINGTON, PENNSYLVANIA 15301

FINAL MAP / MARCH 1992

RYKAT MINE

JEFFERSON TOWNSHIP  
 WASHINGTON COUNTY PENNSYLVANIA  
 PA. M.A.P. NUMBER 63881301 (BOLOGNA COAL COMPANY)  
 M.S.H.A. ID NUMBER 36-08068  
 SHEET 5 OF 8 SCALE: 1" = 100'

PREPARED BY:  
 CHARBEL MINING SERVICES, INC.  
 106 PENN STREET  
 POINT MARION, PA. 15474  
 PHONE (412) 725-9065

A-1	B-2
C-3	D-4
E-5	F-6
G-7	H-8

Match Line

