




C.L. CAMPBELL FLORENCE MINING

ROBERT W. HAGAS
 (SURFACE MINE)
 CERTIFICATE NO. 13479
 "D" SEAM

"D" SEAM EXPOSED
 5 1/2" COAL, WINTERBROOK SHALE
 16 1/2" COAL
 11 1/2" SHALE
 10" COAL
 33 1/2" SEAM HEIGHT
 COAL EL. 1972.8

CEMETERY
 4360

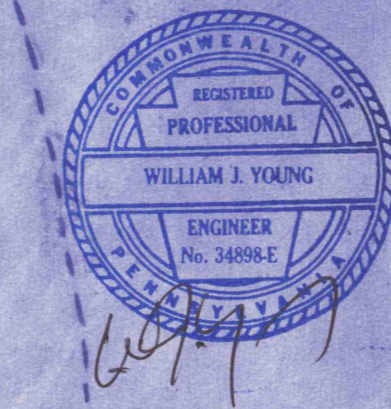

 I hereby certify this print to be
 correct to the best of my knowledge
 and belief.
William J. Young
 Date: 2/24/03

