

SEALING

SEAM PILLARED AREA

HUGH & D.C. MACK 4214D

HOLED THRU TO OLD WORKINGS

1 EAST DRIVE

1 EAST

POSSIBLE PREVIOUSLY MINED AREA

B SEAM PILLARED AREA

LYNN HEIRS 4066D

SEAM PILLARED AREA

B.B. BRAUGHLER 4106

B.B. BRAUGHLER 4137


FRIEL MINE NO. 6
LOWER FREEPORT 'D' SEAM

MAIN HEADINGS

FIRST EAST

FIRST RIGHT

RECEIVED
FEB 26 1983
Dept. of Environmental Protection
McMurry District Office

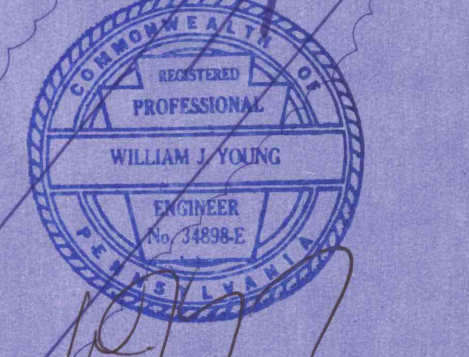

do hereby certify this plan to be
correct, to the best of my knowledge
and belief.
William J. Young
Date 2/24/83

D71

