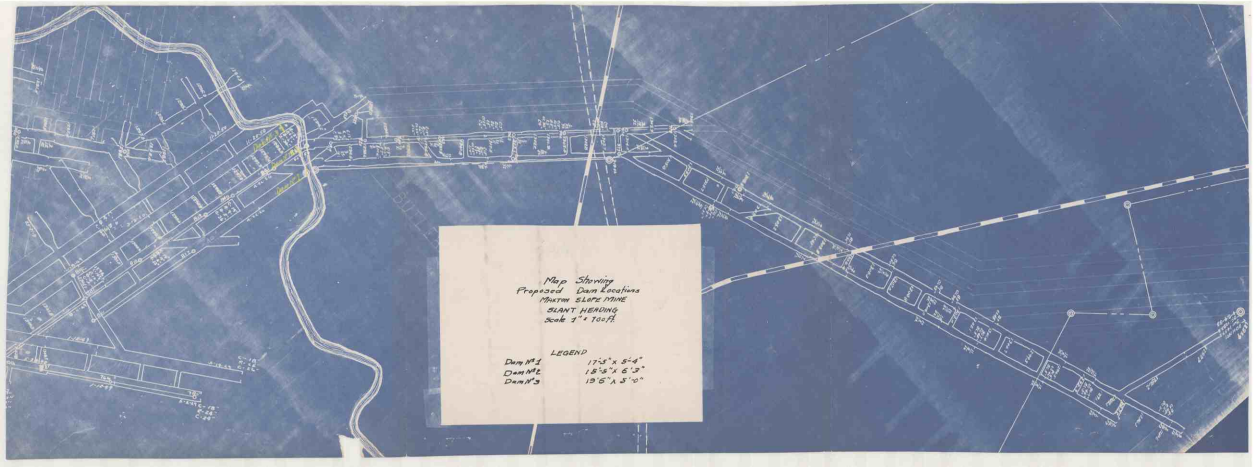
Map Showing
Proposed Dam Locations
SLANT HEADING
Scale 1" = 100ft
LEGEND
Dam N°1 17'-5" x 5'-4"
Dam N°3 13'-6" x 5'-0"