


WASHINGTON COUNTY HOME FARM

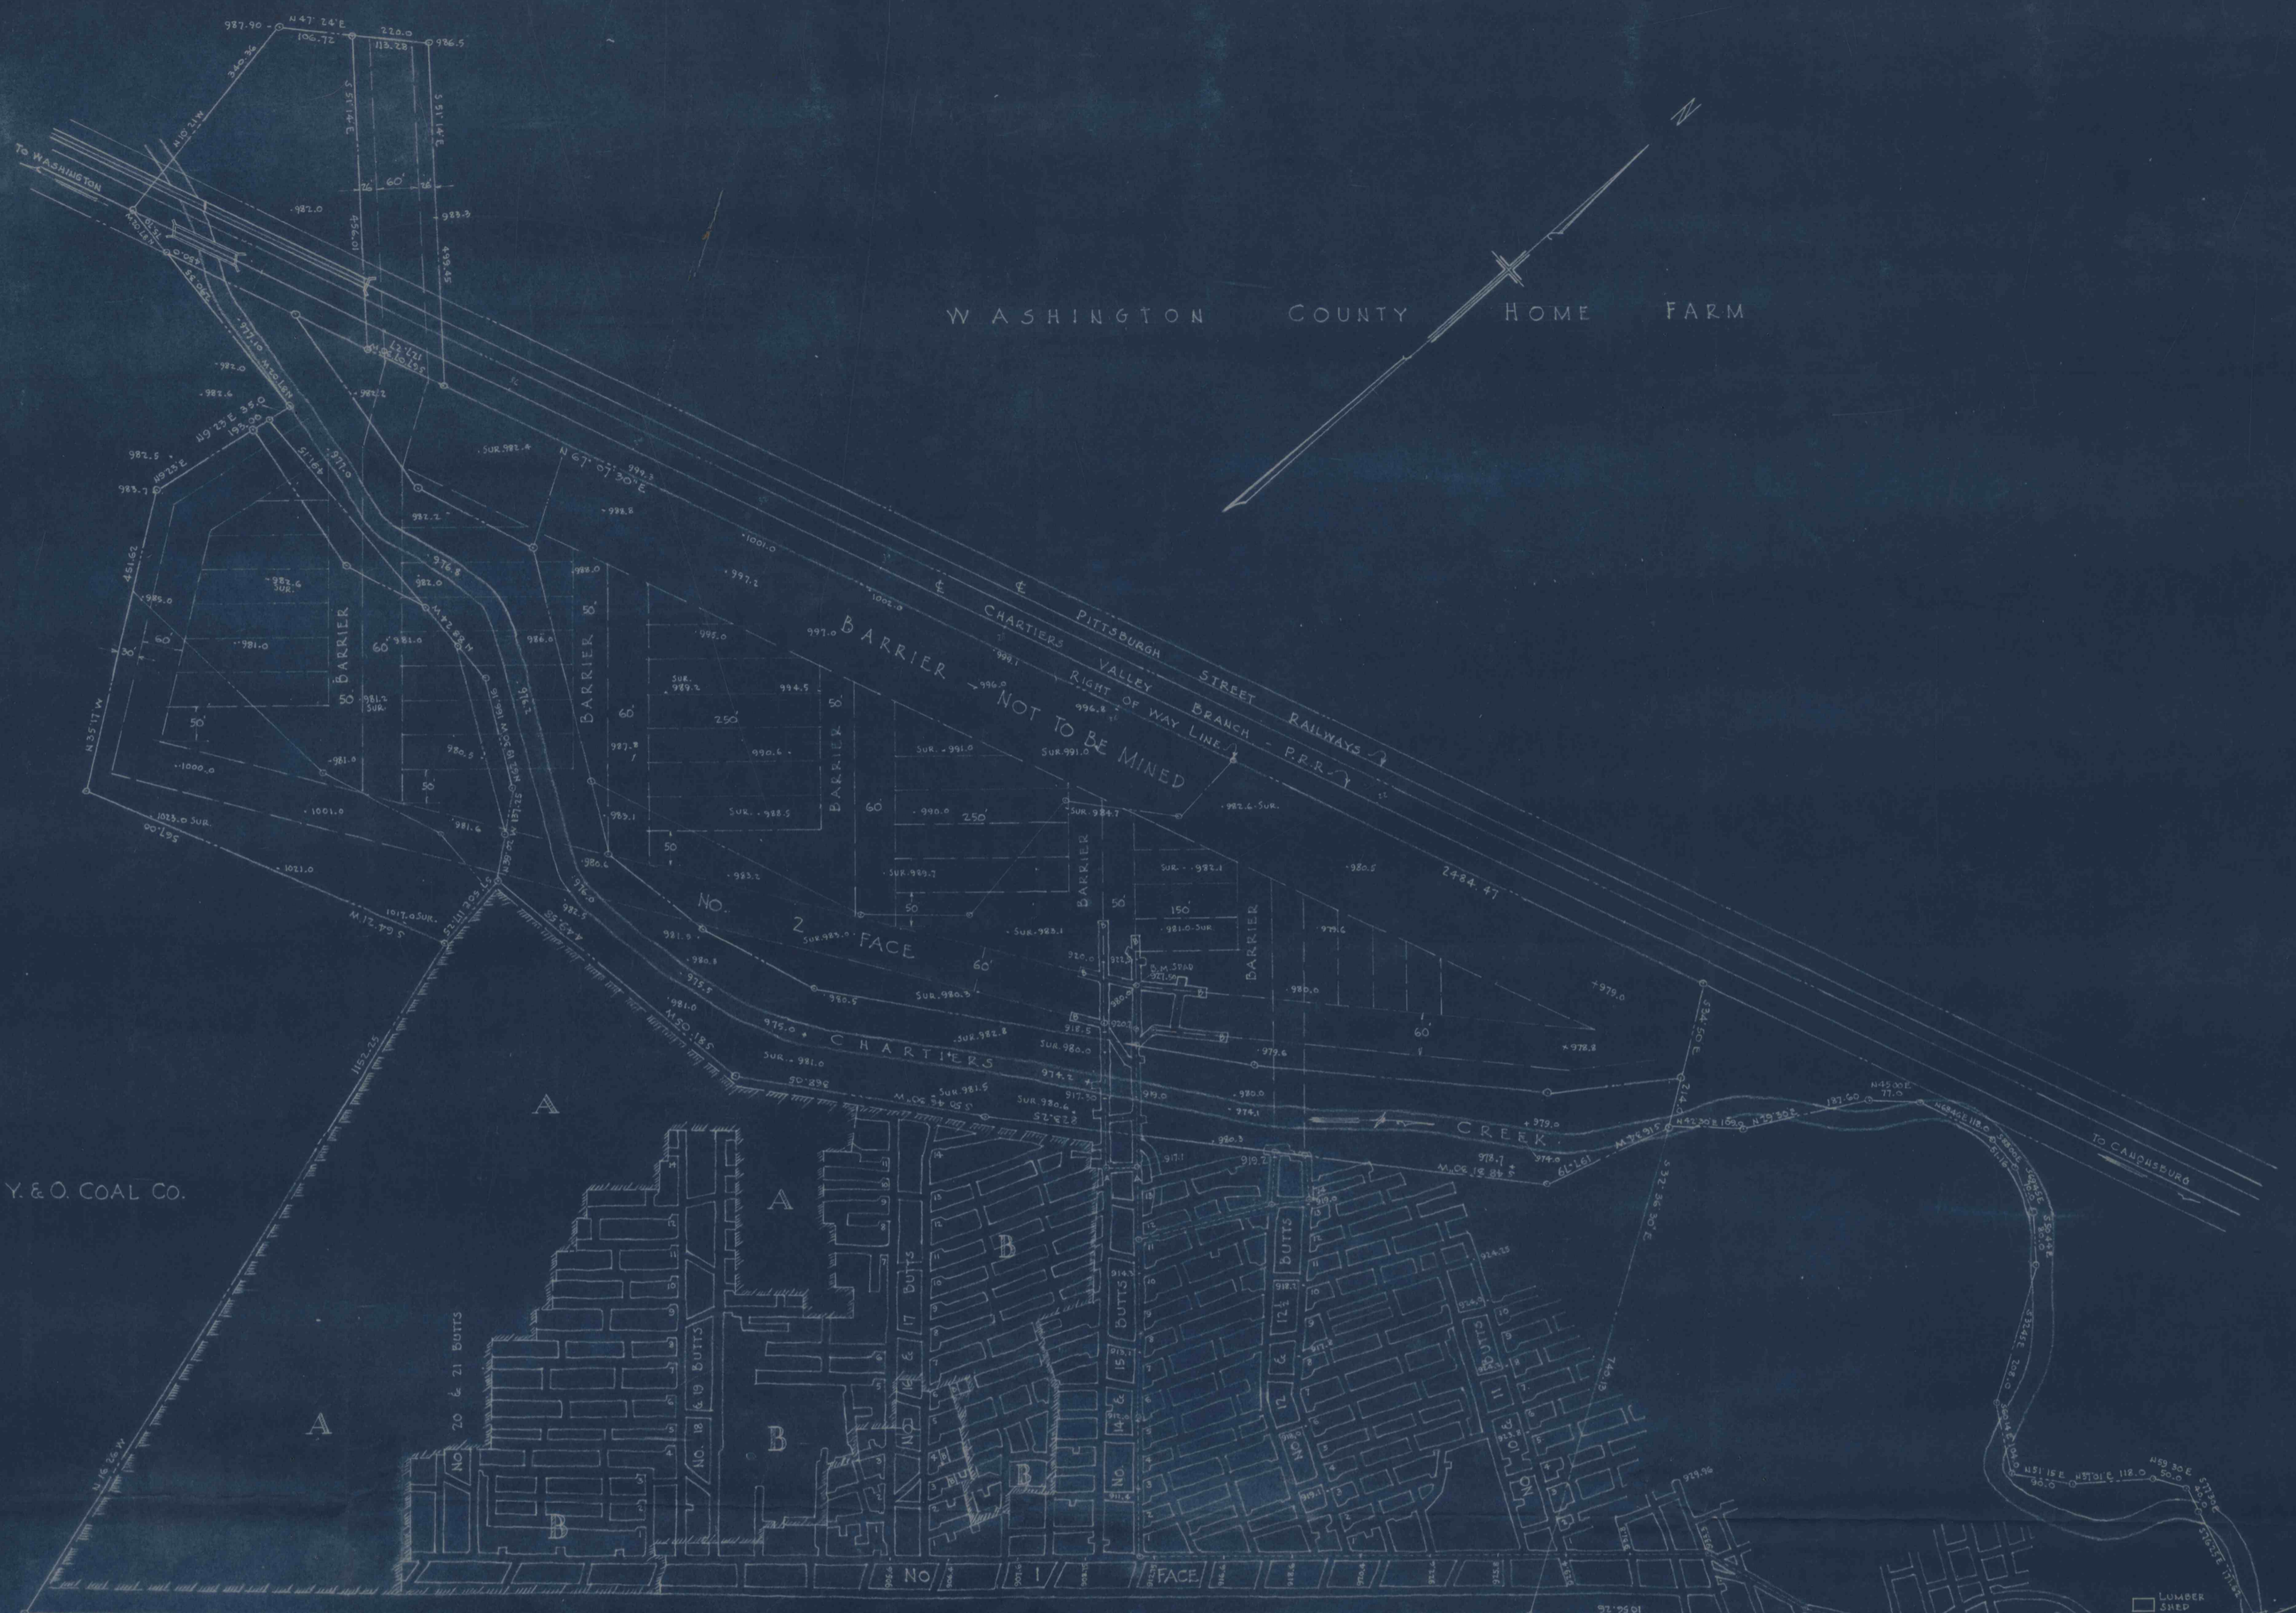

MINED OUT - Y. & O. COAL CO.

MINED OUT - Y. & O. COAL CO.

LEGEND

A	DEC. 31-1947
B	FEB. 5-1949

MAP OF
ENTERPRISE MINE
 SPRINGER COAL CO.
 CHARTIERS & SOUTH STRABANE TOWNSHIPS - WASH. CO. PA.
 SCALE 1"=100' FEB. 1-1949
 H. P. TAYLOR, R.P.E.

NOTE: THIS MAP MADE IN PART FROM SURVEY AND PREVIOUS MAPS

